


SCALE:  
 1" = 40' HORIZONTAL  
 1" = 6' VERTICAL

NOTE:  
 1. ALL LOTS SHOWN ON S/B ARE 15'x54'  
 2. SINGLE SERVICES ARE LOCATED IN CENTER OF LOT FOR 15' WIDE LOT, 7.5' FROM EACH CORNER.  
 3. DOUBLE SERVICES ARE LOCATED AT LOT CORNER

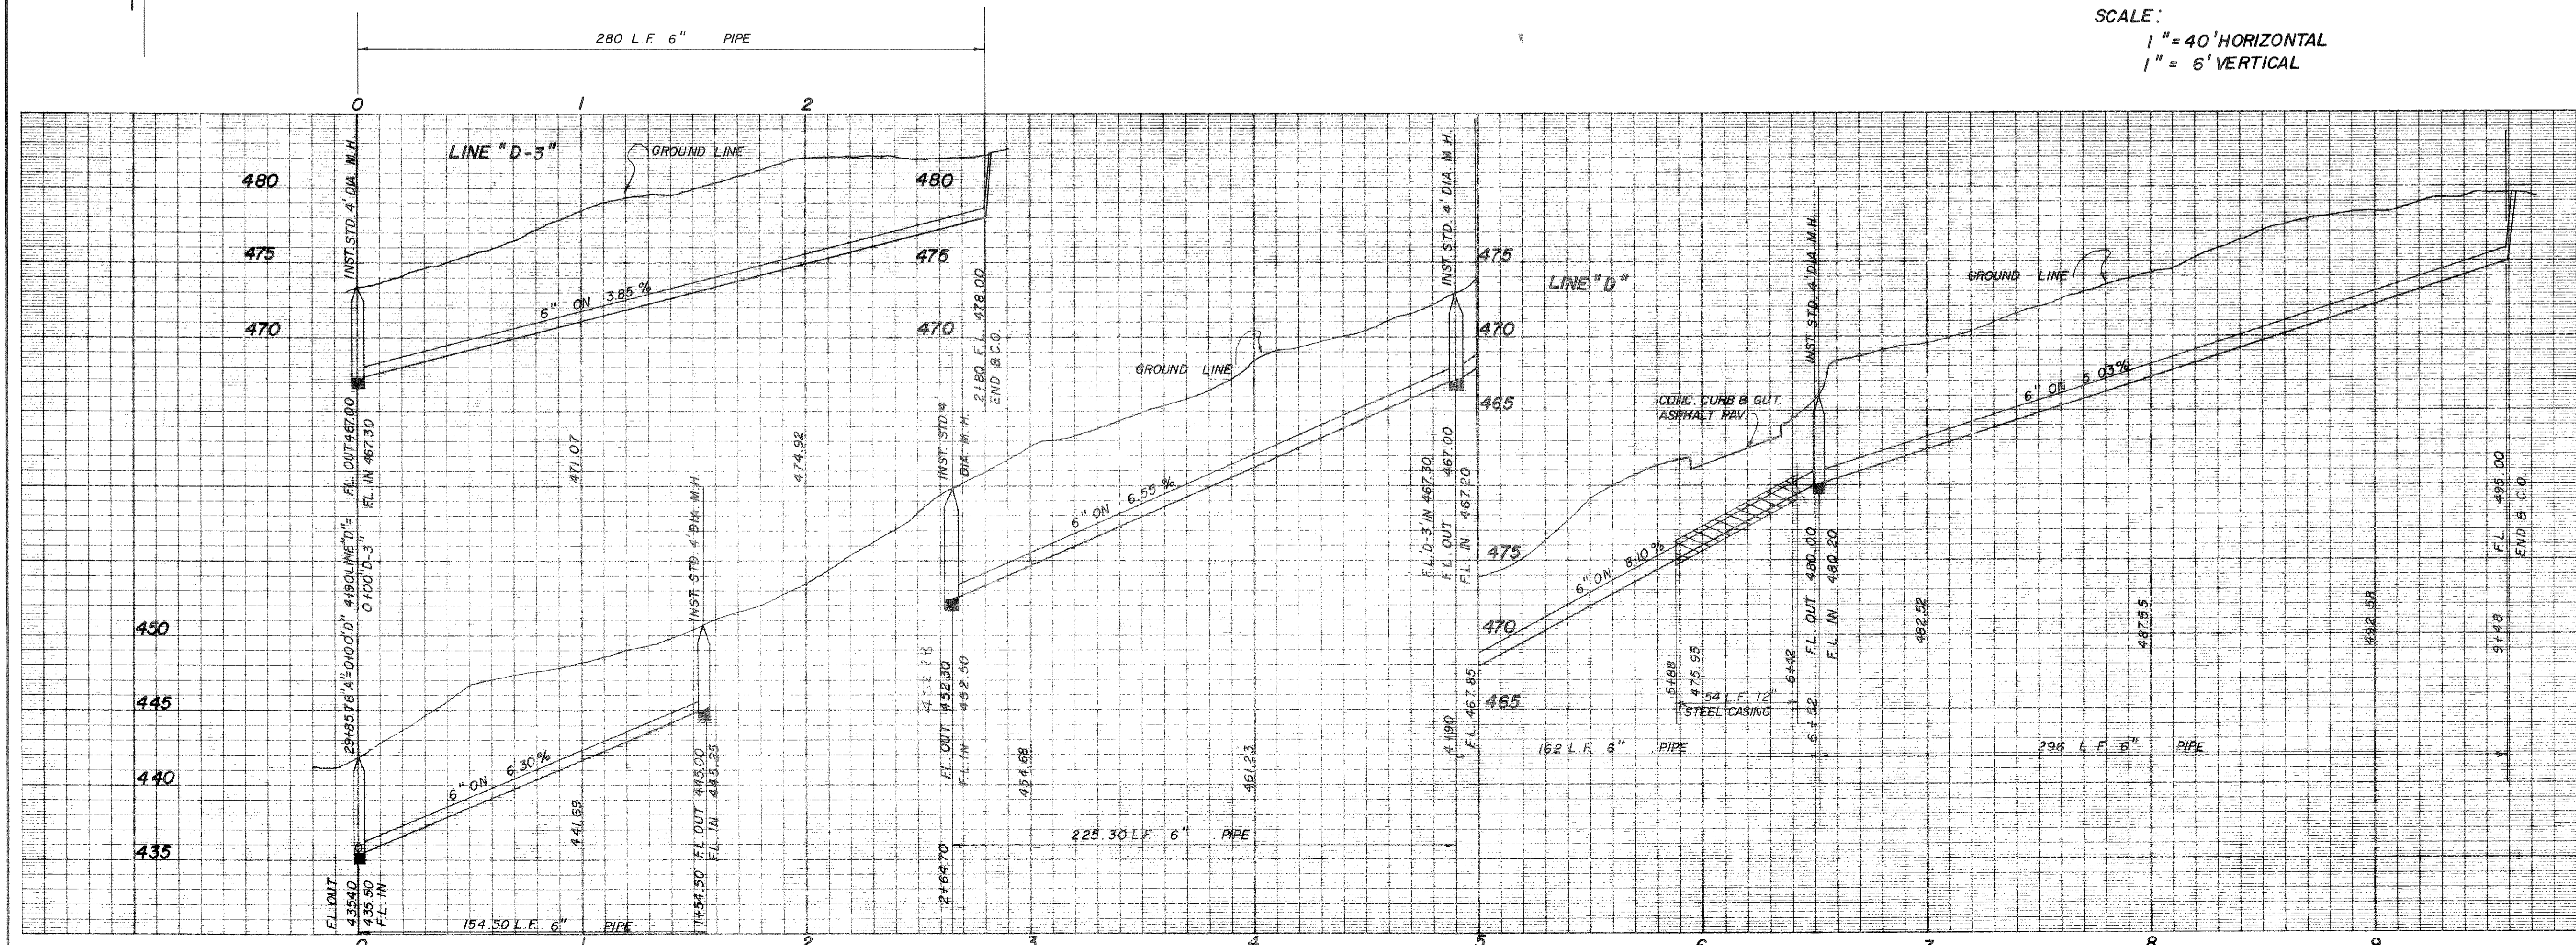

**"AS BUILT"**

PROPOSED SANITARY SEWER  
 LAKESIDE VILLAGE

CITY OF ROCKWALL, TEXAS

DESIGN	DRAWN	DATE	SCALE	NOTES	FILE	NO.
H. L. E.	D. E. O.	6-22-71	AS SHOWN			