
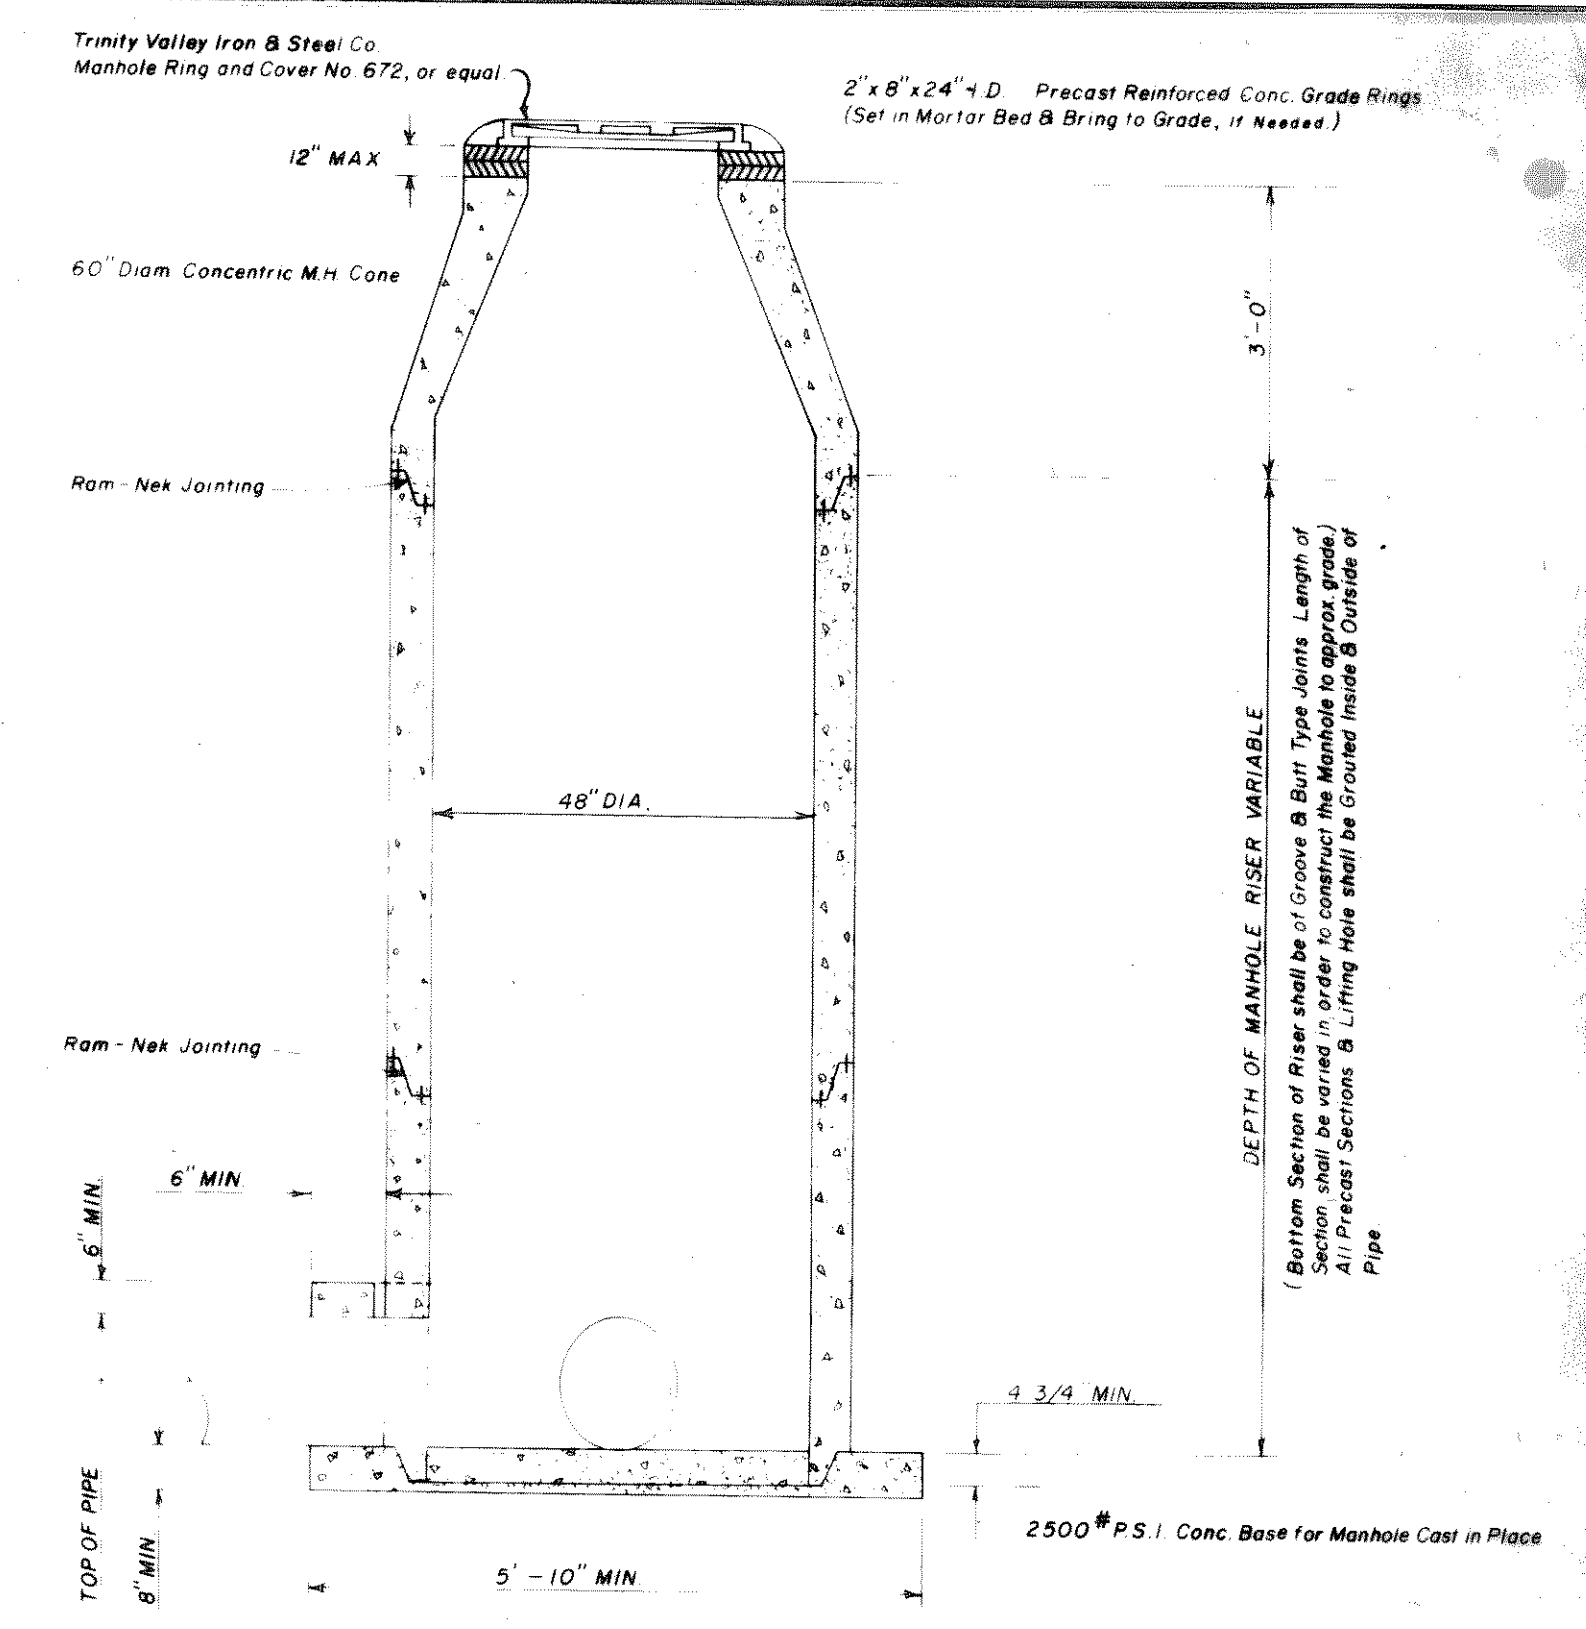


CLASS 'C' EARTH BEDDING DETAIL


NOTES

1. The maximum trench width (B) shall be the outside diameter of the pipe used plus 16 inches for pipes with 33 inch diameter or smaller. The maximum trench width (B) shall be the outside diameter of the pipe plus 24 inches for pipes larger than 33 inch inside diameter.

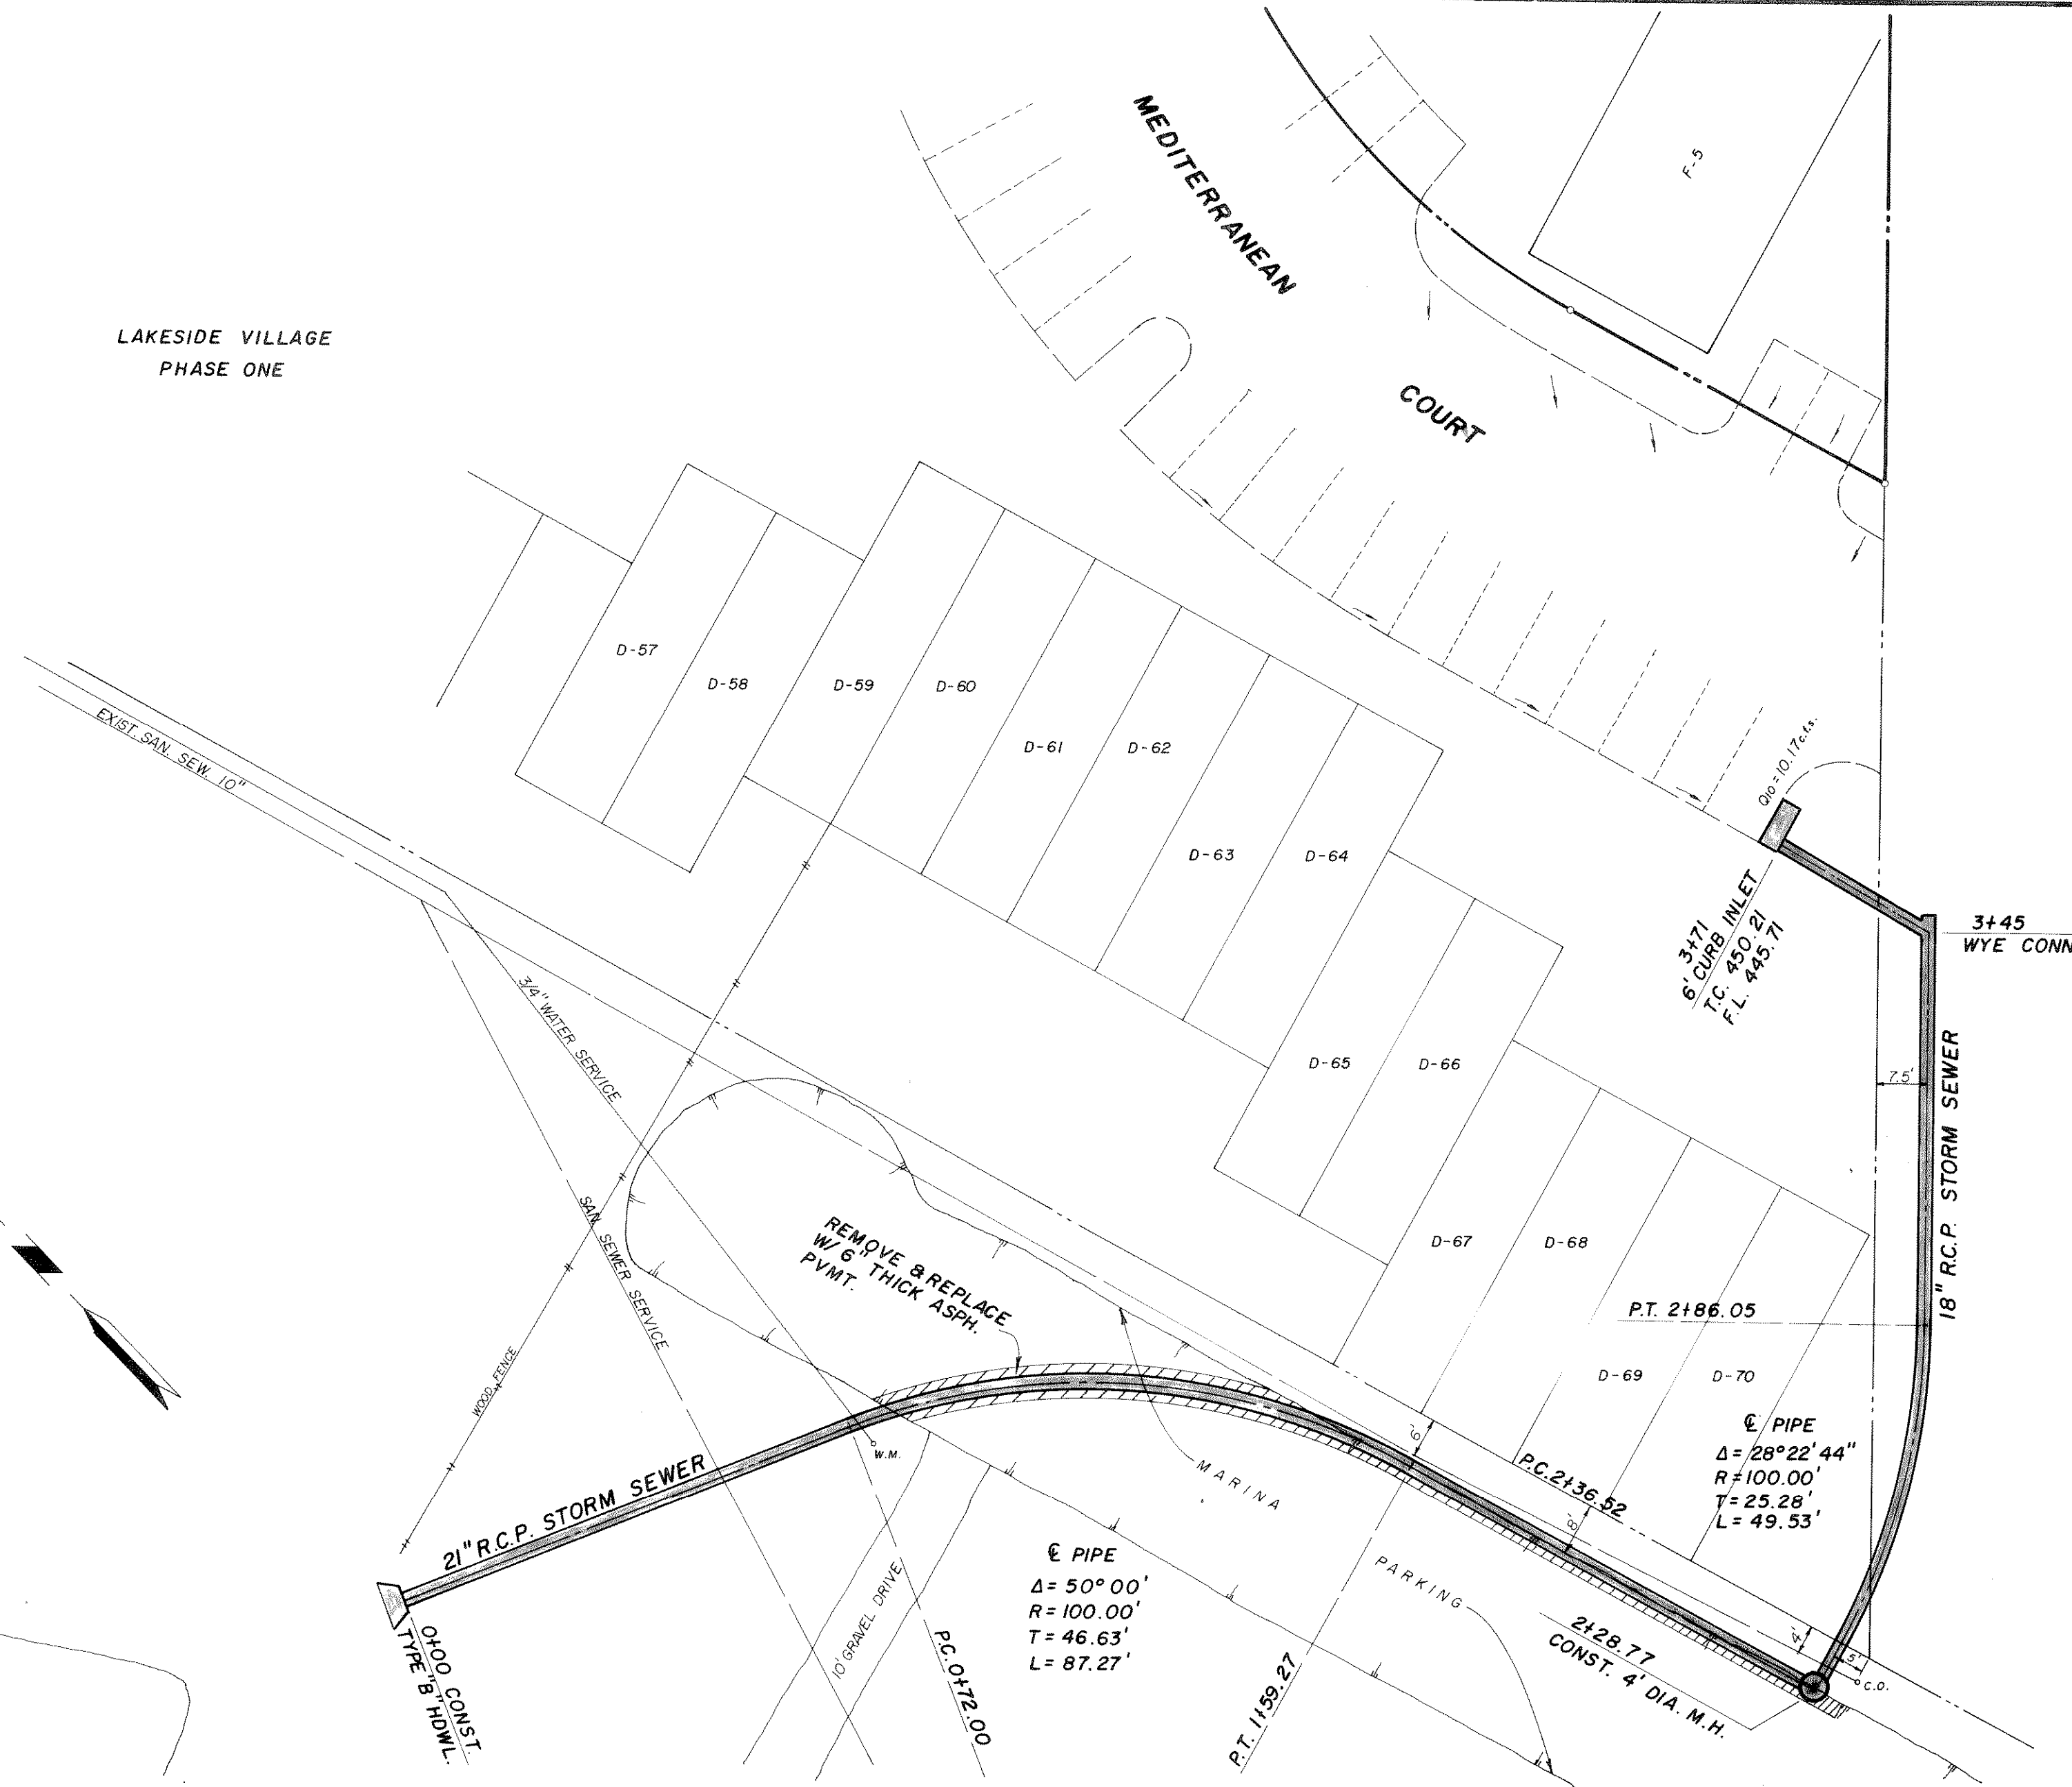

PRECAST CONCRETE PIPE - MANHOLE DETAILS

NOTE:
CONTRACTOR SHALL VERIFY LOCATION OF ALL EXIST. UTILITIES.

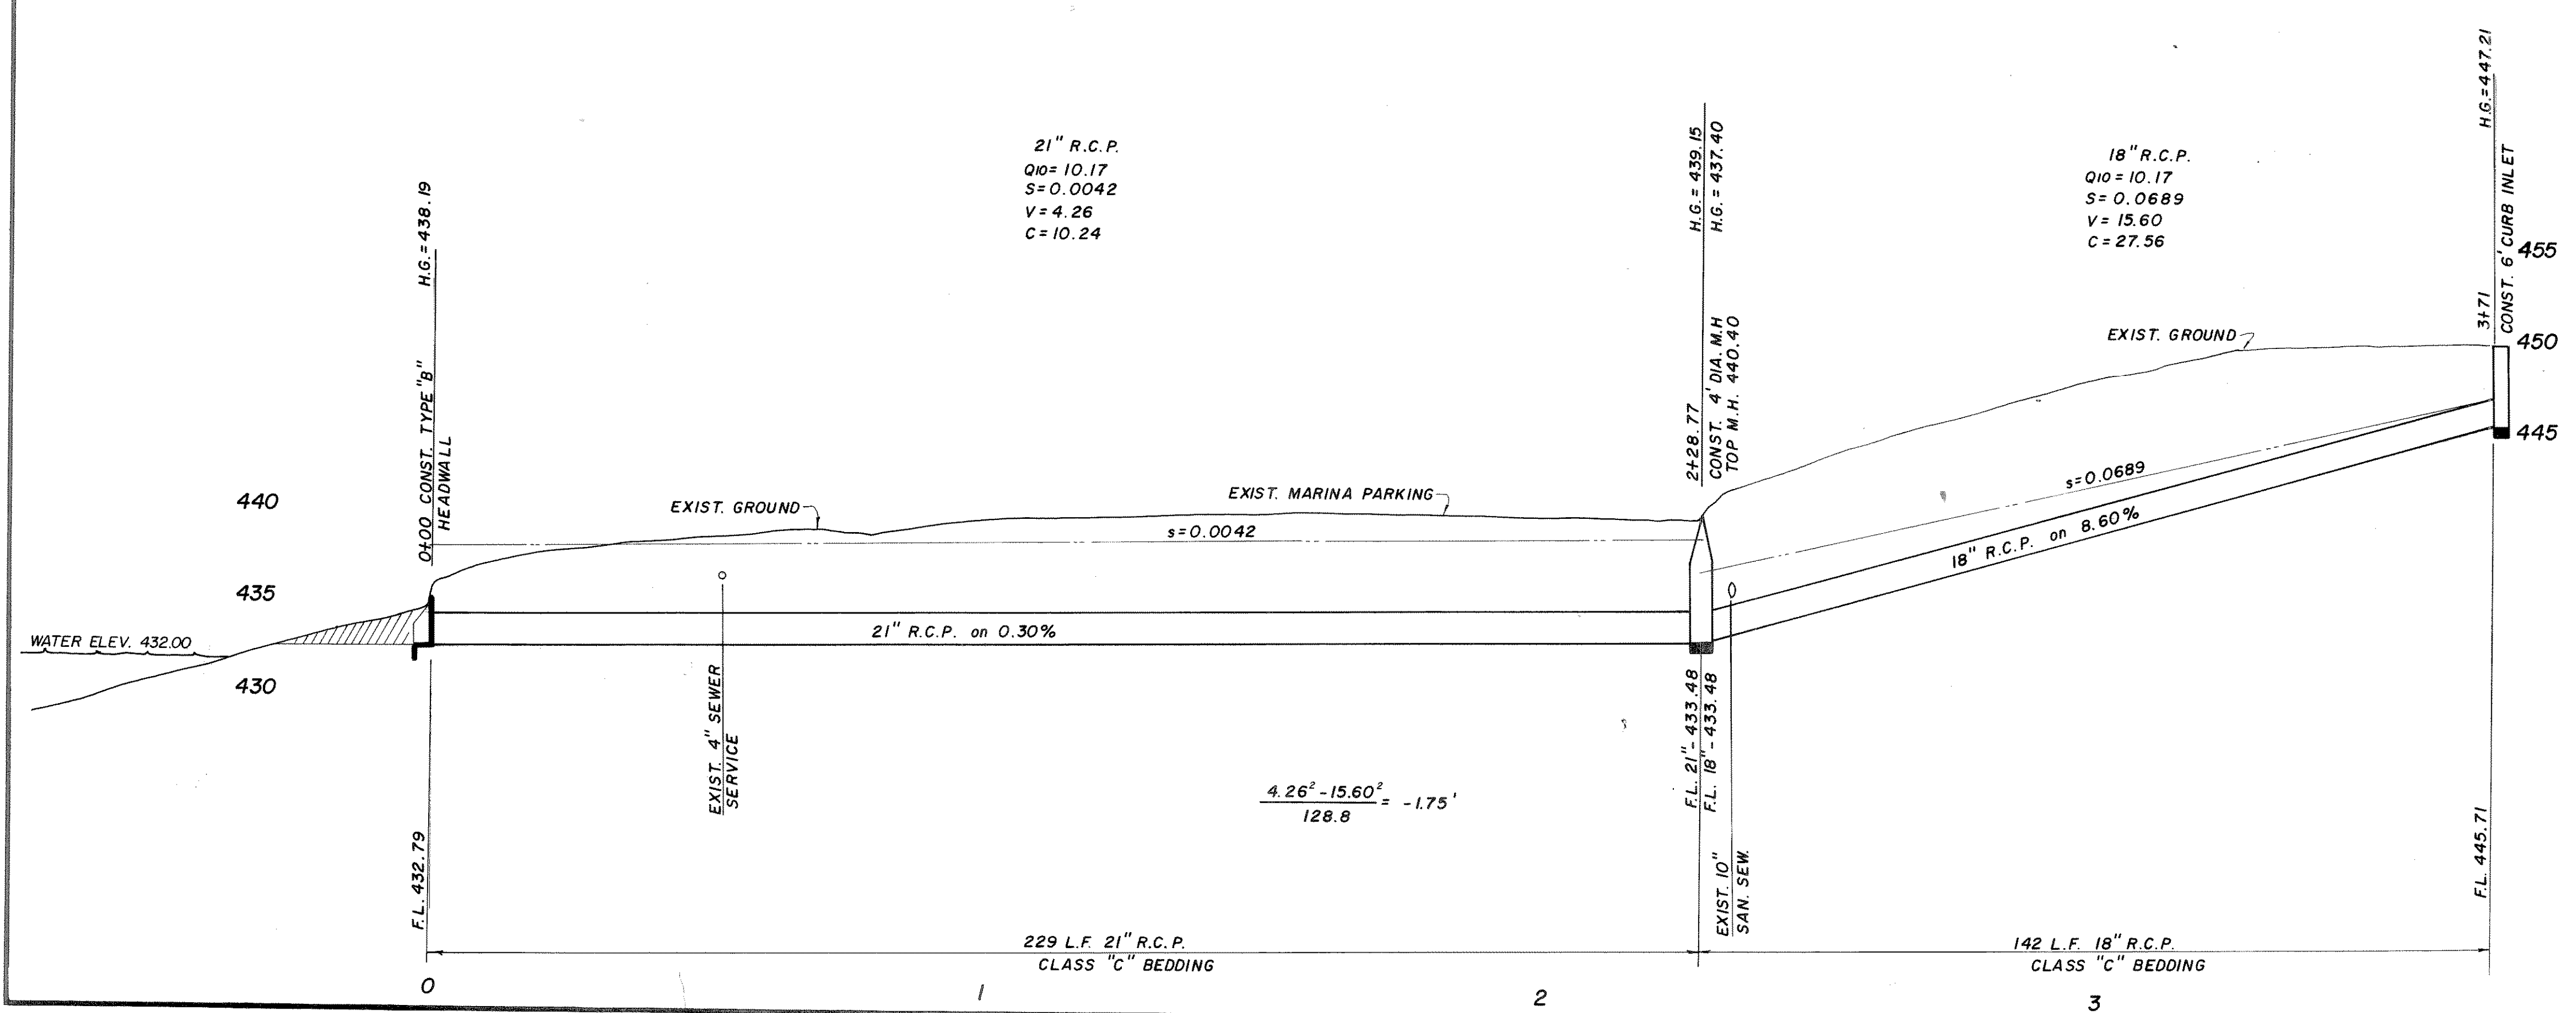

AS BUILT

PROPOSED STORM SEWER LAKESIDE VILLAGE PHASE ONE-A						
HAROLD L. EVANS CONSULTING ENGINEER						
DESIGN	DRAWN	DATE	SCALE	NOTES	FILE	NO.
D.E.O.	Danny O	8-17-77	1" = 20' H. 1" = 6' V.			7750

P.H.1