


GENERAL NOTES

1. No Trees Are To Be Cut Without Specific Authority From The Engineer.
2. Construction Areas Will Be Staked On The Ground. Contractors And Personnel Will Confine Themselves To These Areas.

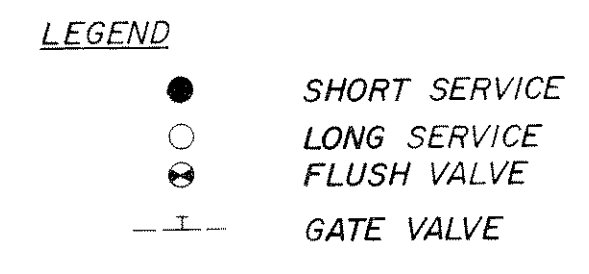

WATER DISTRIBUTION SYSTEM
for
LAKESIDE VILLAGE
SCALE: 1"=100'

JUNE, 1971

"AS BUILT"