
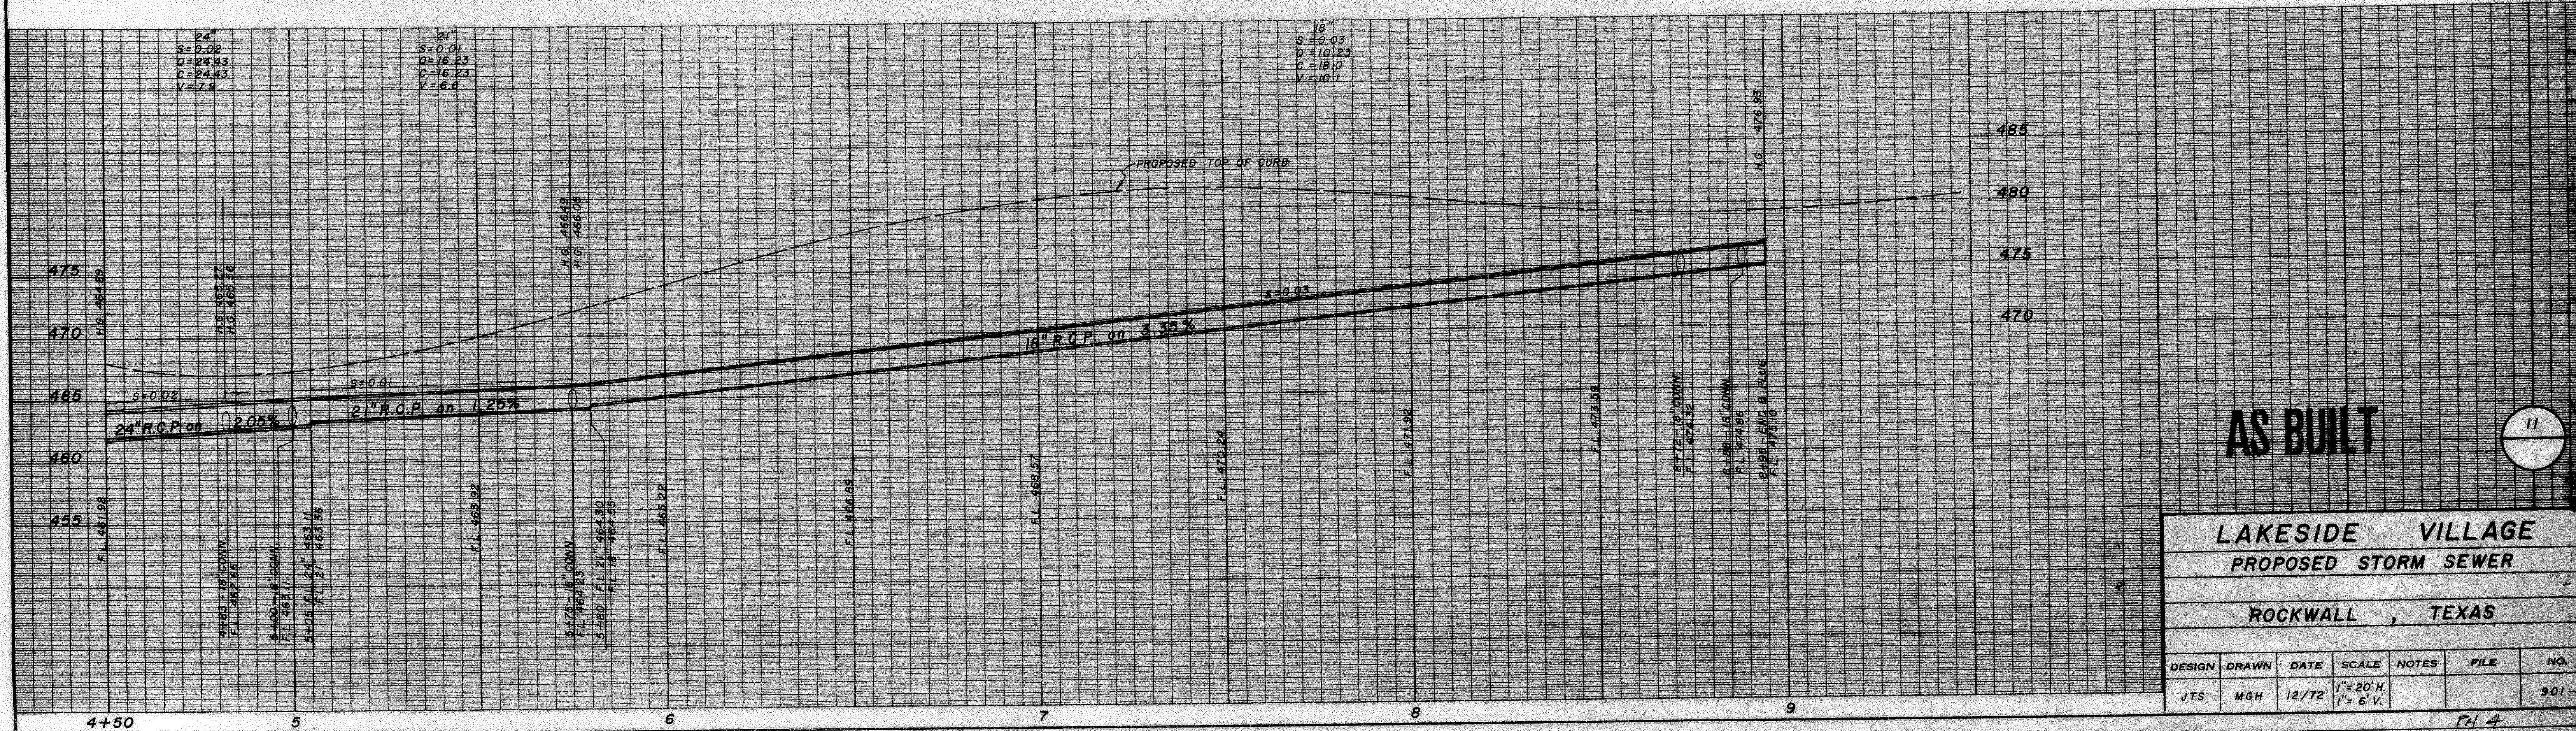


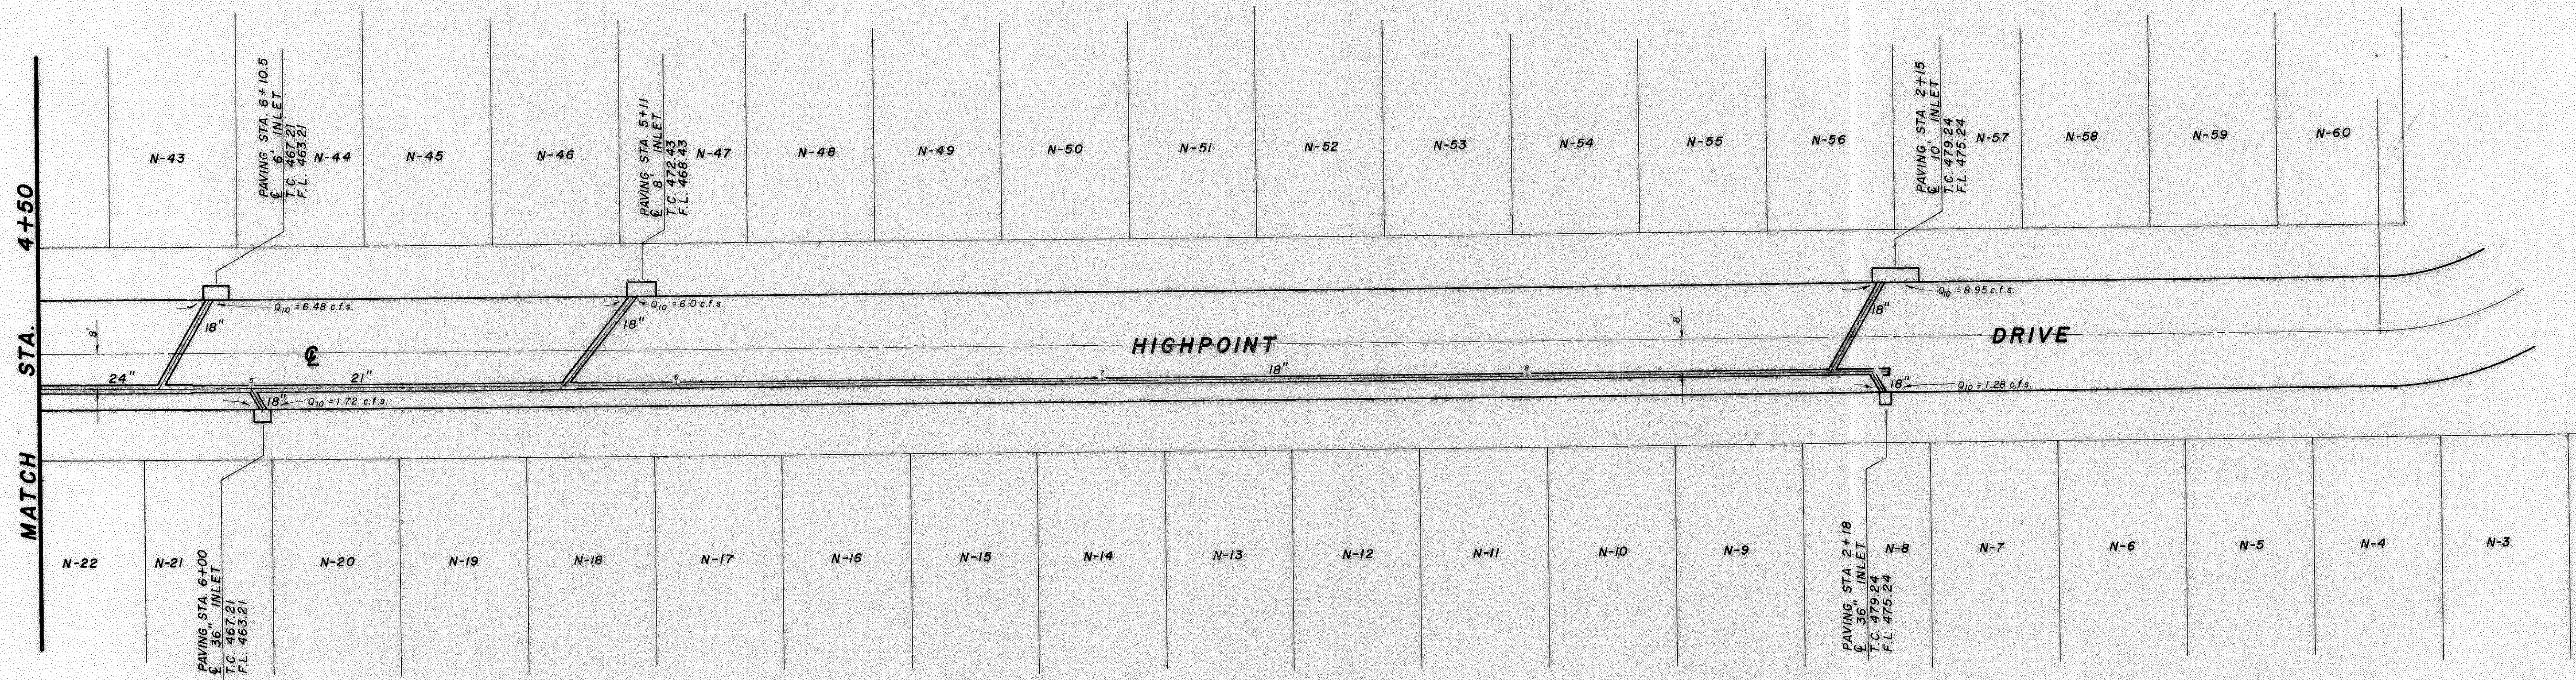

AS BUILT

LAKE SIDE VILLAGE
PROPOSED STORM SEWER

ROCKWALL, TEXAS

DESIGN	DRAWN	DATE	SCALE	NOTES	FILE	NQ.
JTS	MGH	12/72	1"=20' H. 1"=6' V.			901

7-1-4