


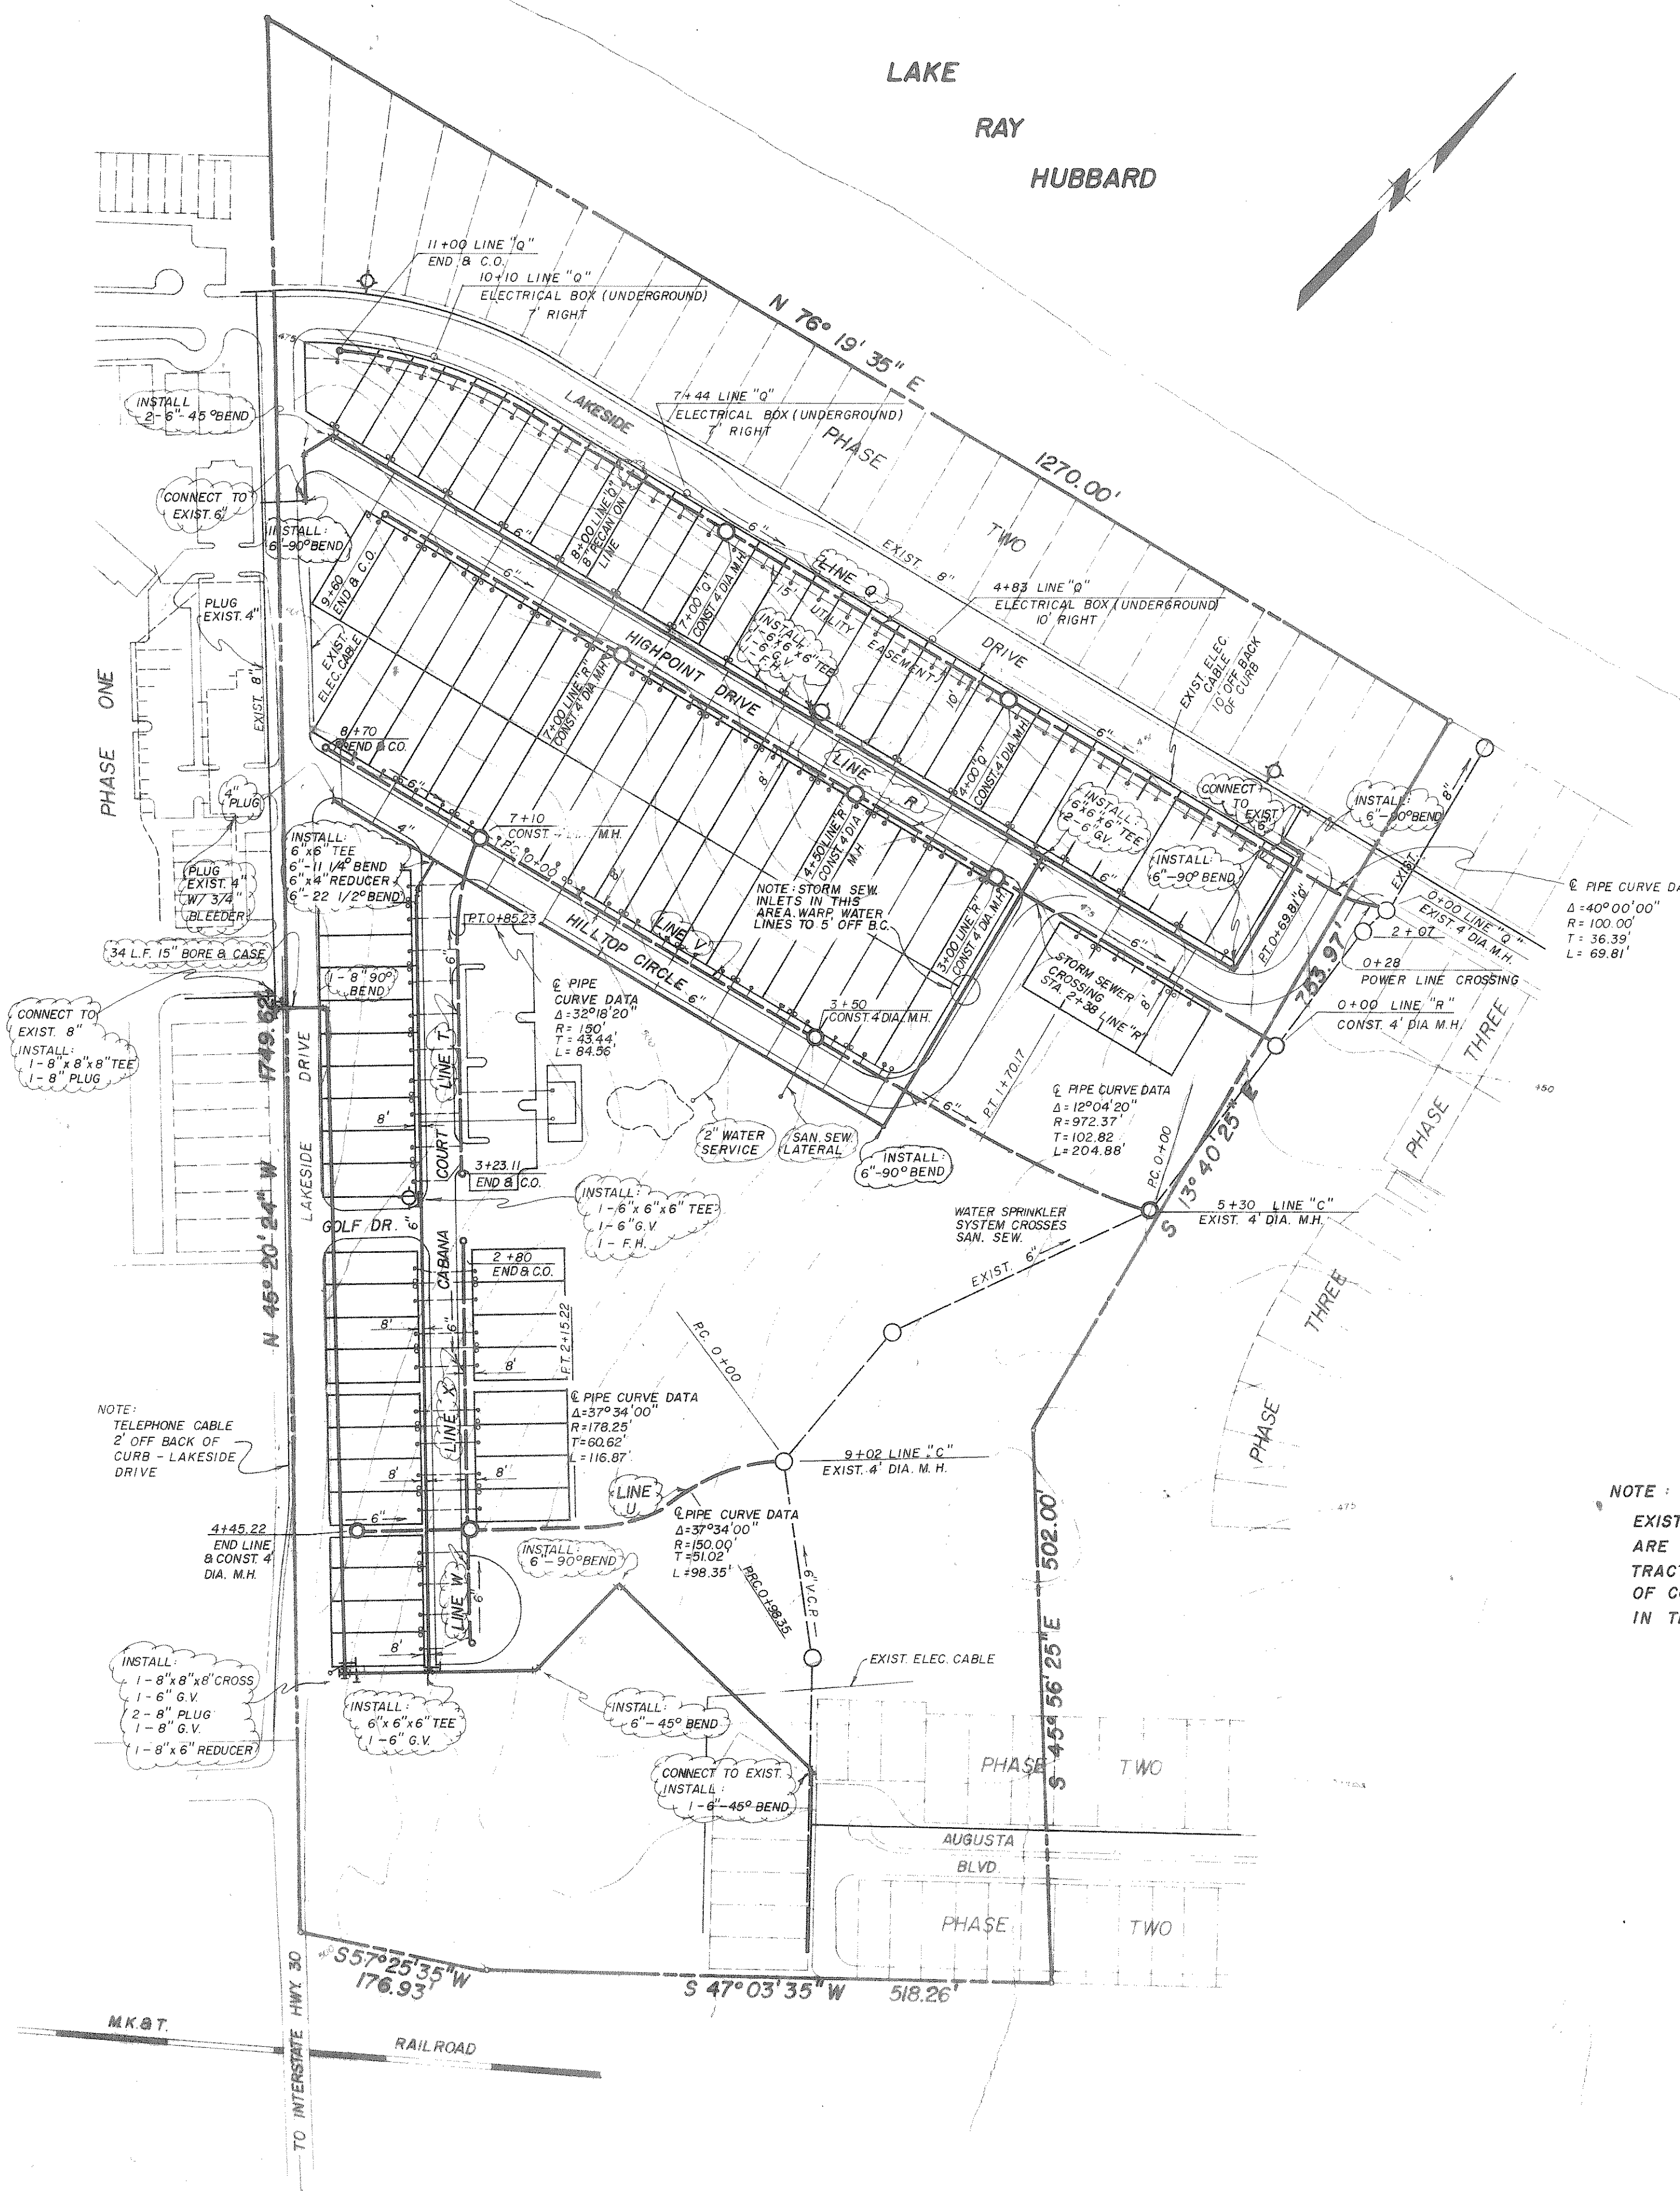

NOTE:
EXISTING UTILITIES SHOWN ON PLAN
ARE FOR THE CONVENIENCE OF CON-
TRACTOR. IT IS THE RESPONSIBILITY
OF CONTRACTOR TO VERIFY LOCATIONS
IN THE FIELD.

AS BUILT

WATER & SEWER PLAN				LAKESIDE VILLAGE	
ROCKWALL, TEXAS				PHASE IV	
				GIFCO DEVELOPMENT CO.—OWNER	
DESIGN: HLE	DRAWN: GDM RP	SCALE: 1"= 100'	DATE: 12/72	DALLAS, TEXAS	