


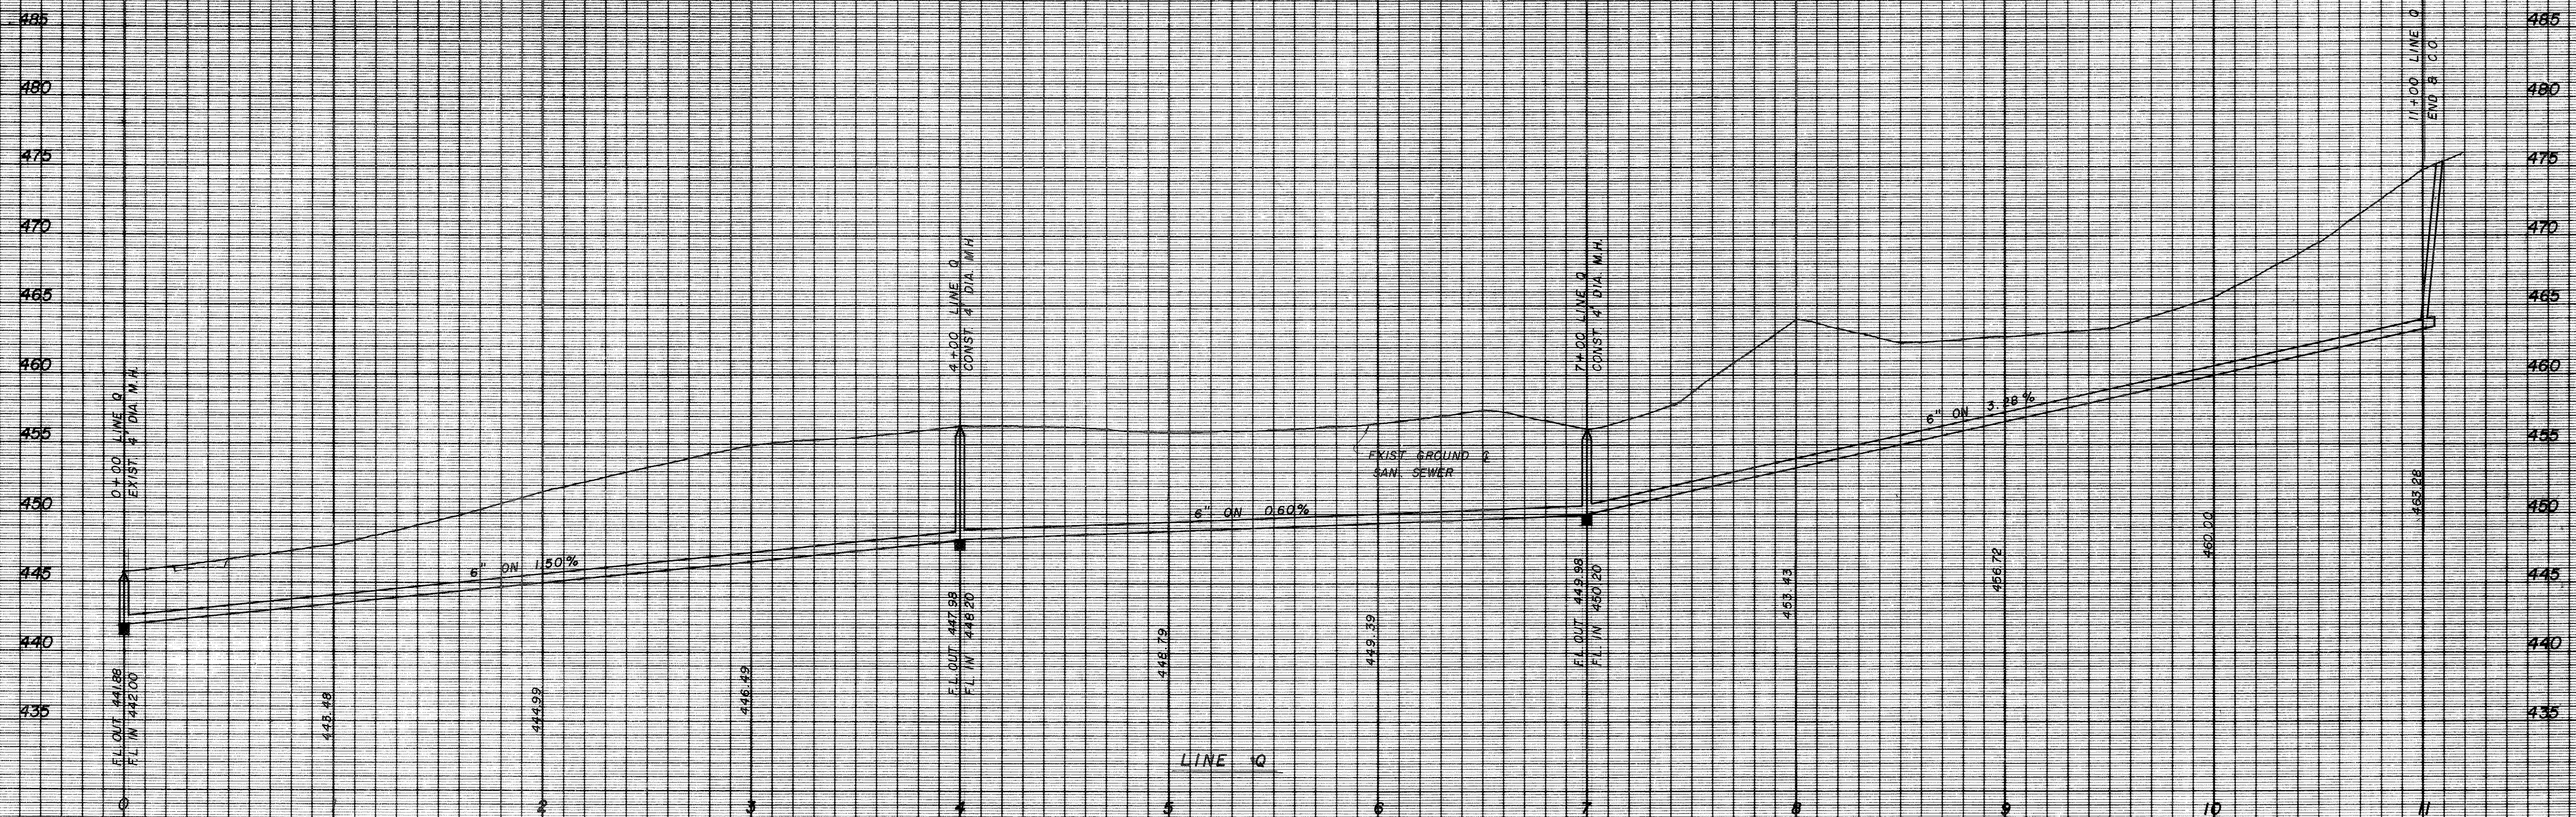

AS BUILT

LAKESIDE VILLAGE						
PROPOSED SANITARY SEWER PROFILES						
LINE Q						
ROCKWALL, TEXAS						
DESIGN	DRAWN	DATE	SCALE	NOTES	FILE	NO.
HLE	RP	1/73	1"=40'H. 1"=6'V.			901

PH 4