


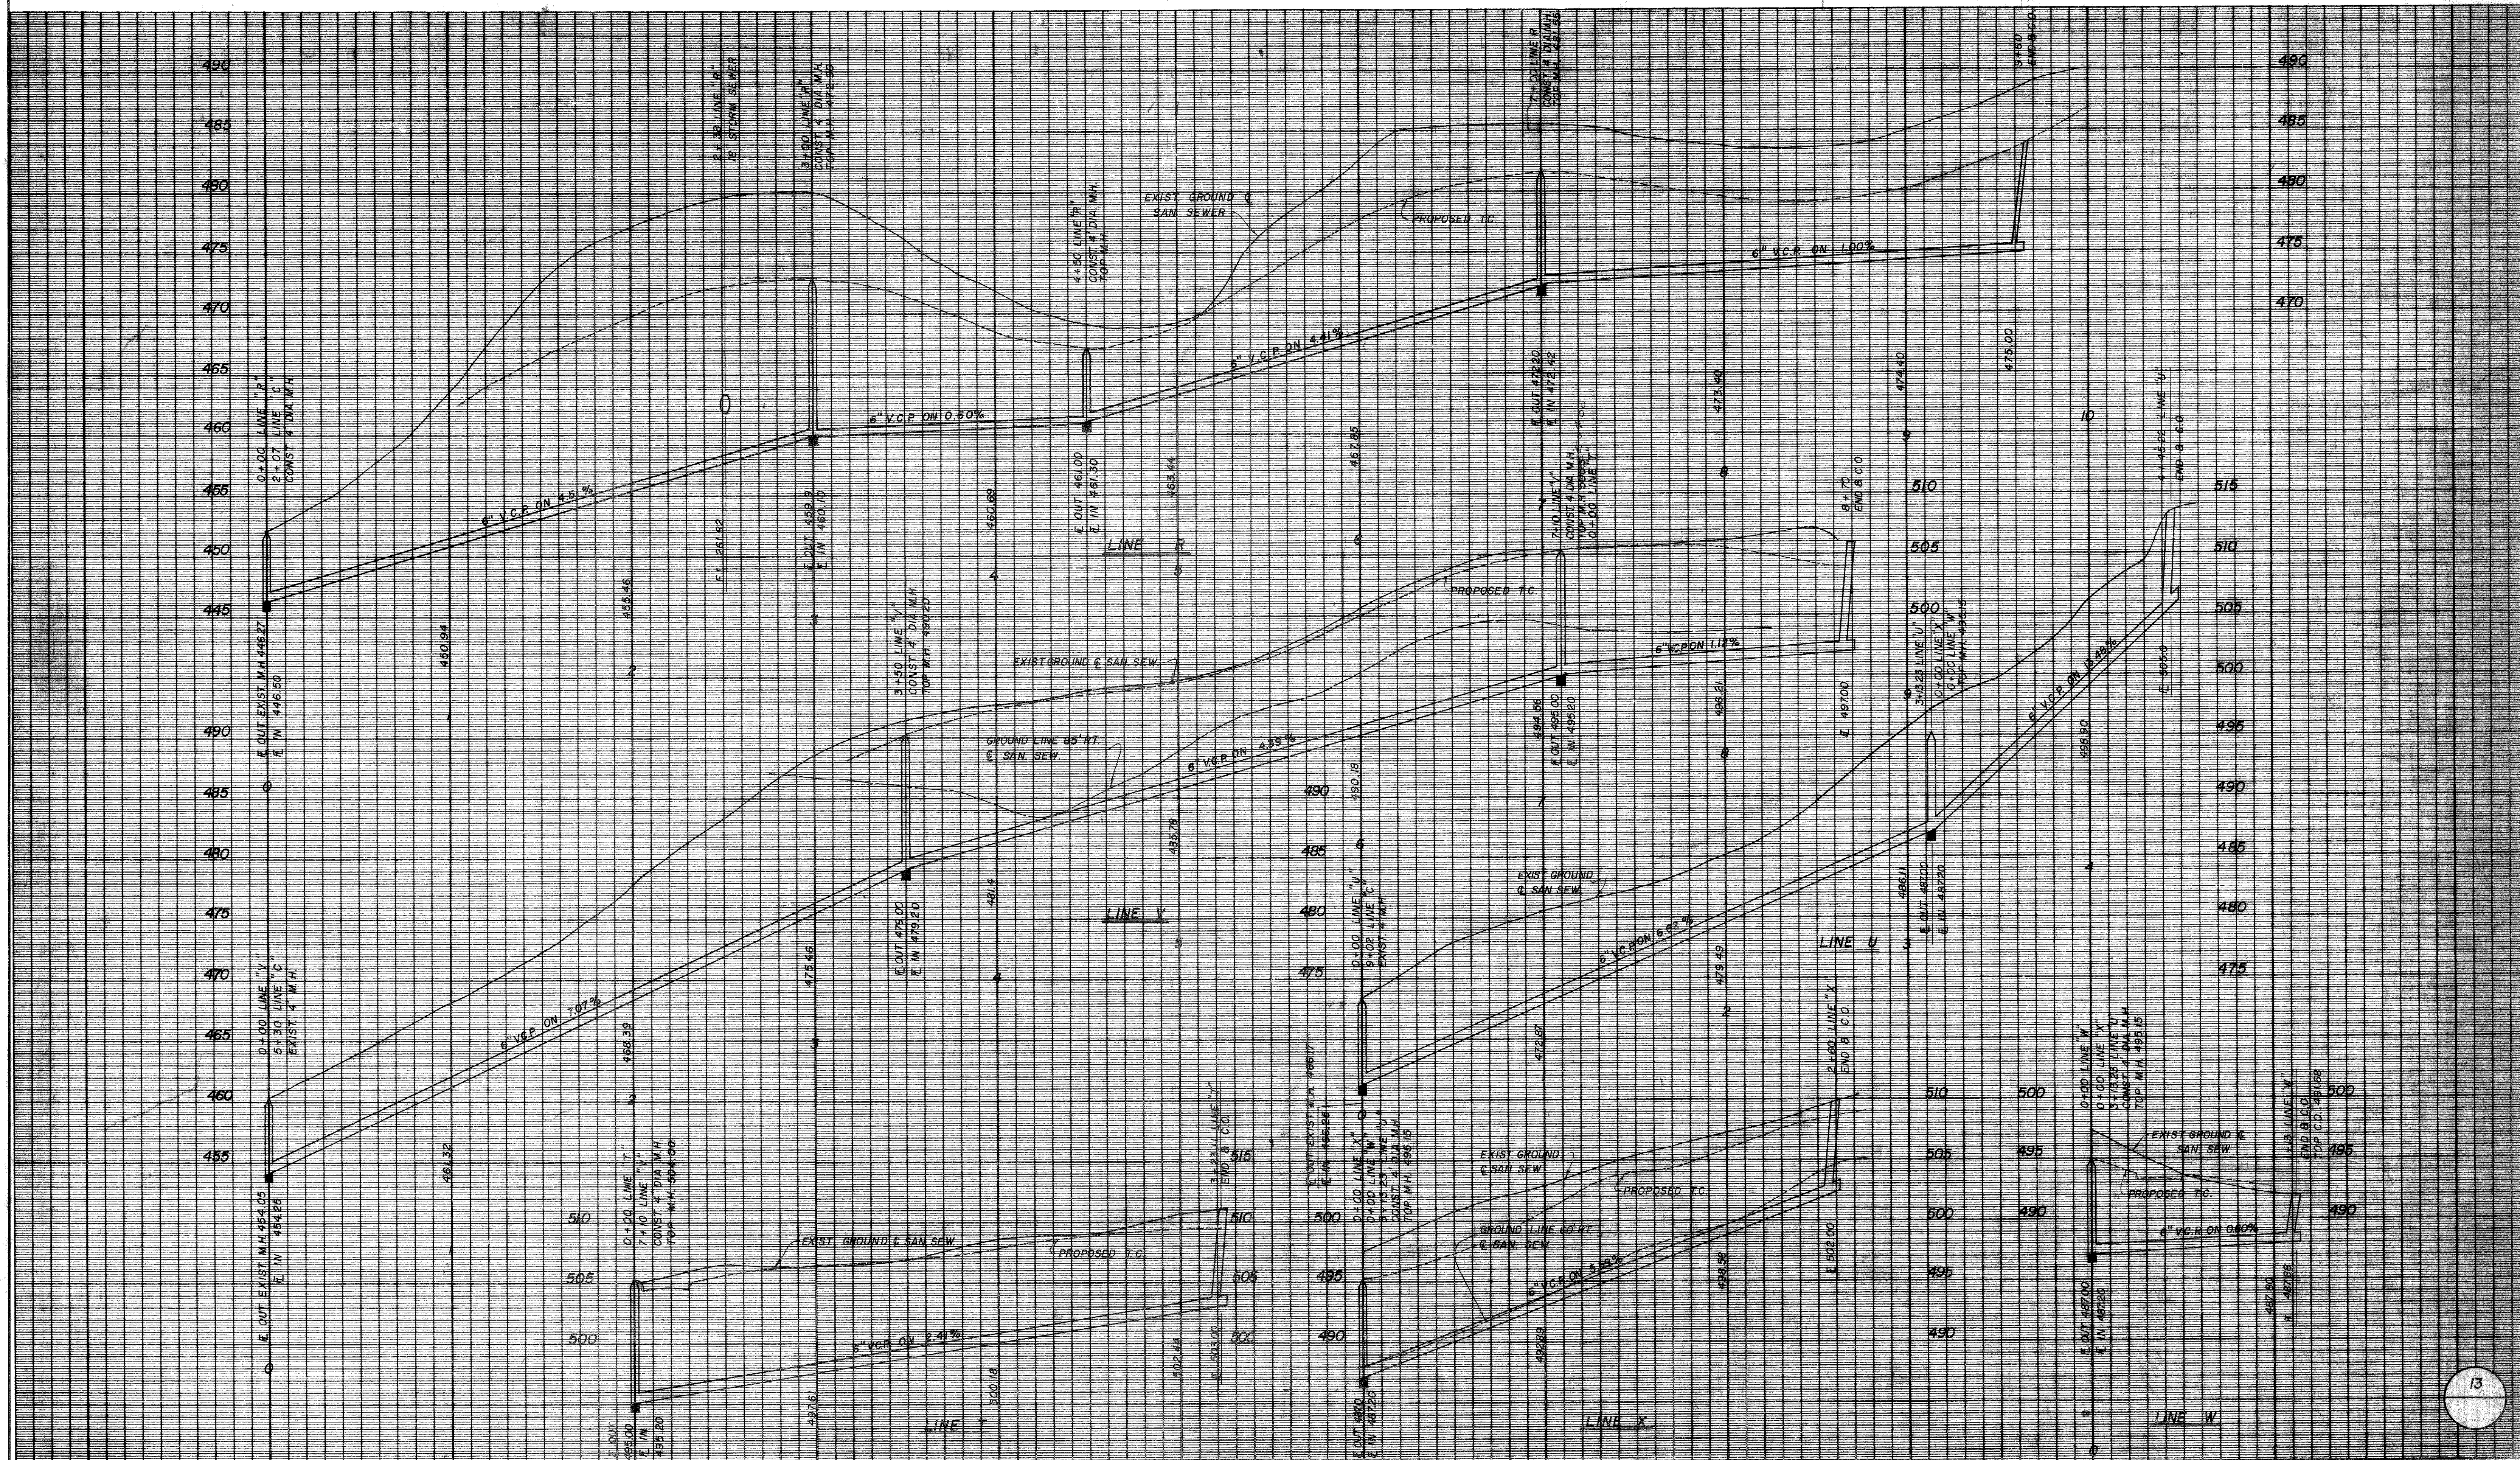

AS BUILT

| LAKESIDE VILLAGE                 |       |       |                       |       |      |     |  |
|----------------------------------|-------|-------|-----------------------|-------|------|-----|--|
| PROPOSED SANITARY SEWER PROFILES |       |       |                       |       |      |     |  |
| LINES R, T, U, V, W, & X.        |       |       |                       |       |      |     |  |
| ROCKWALL, TEXAS                  |       |       |                       |       |      |     |  |
| DESIGN                           | DRAWN | DATE  | SCALE                 | NOTES | FILE | NO. |  |
| JTS                              | RP    | 12/72 | 1"= 40'H.<br>1"= 6'V. |       |      | 901 |  |