
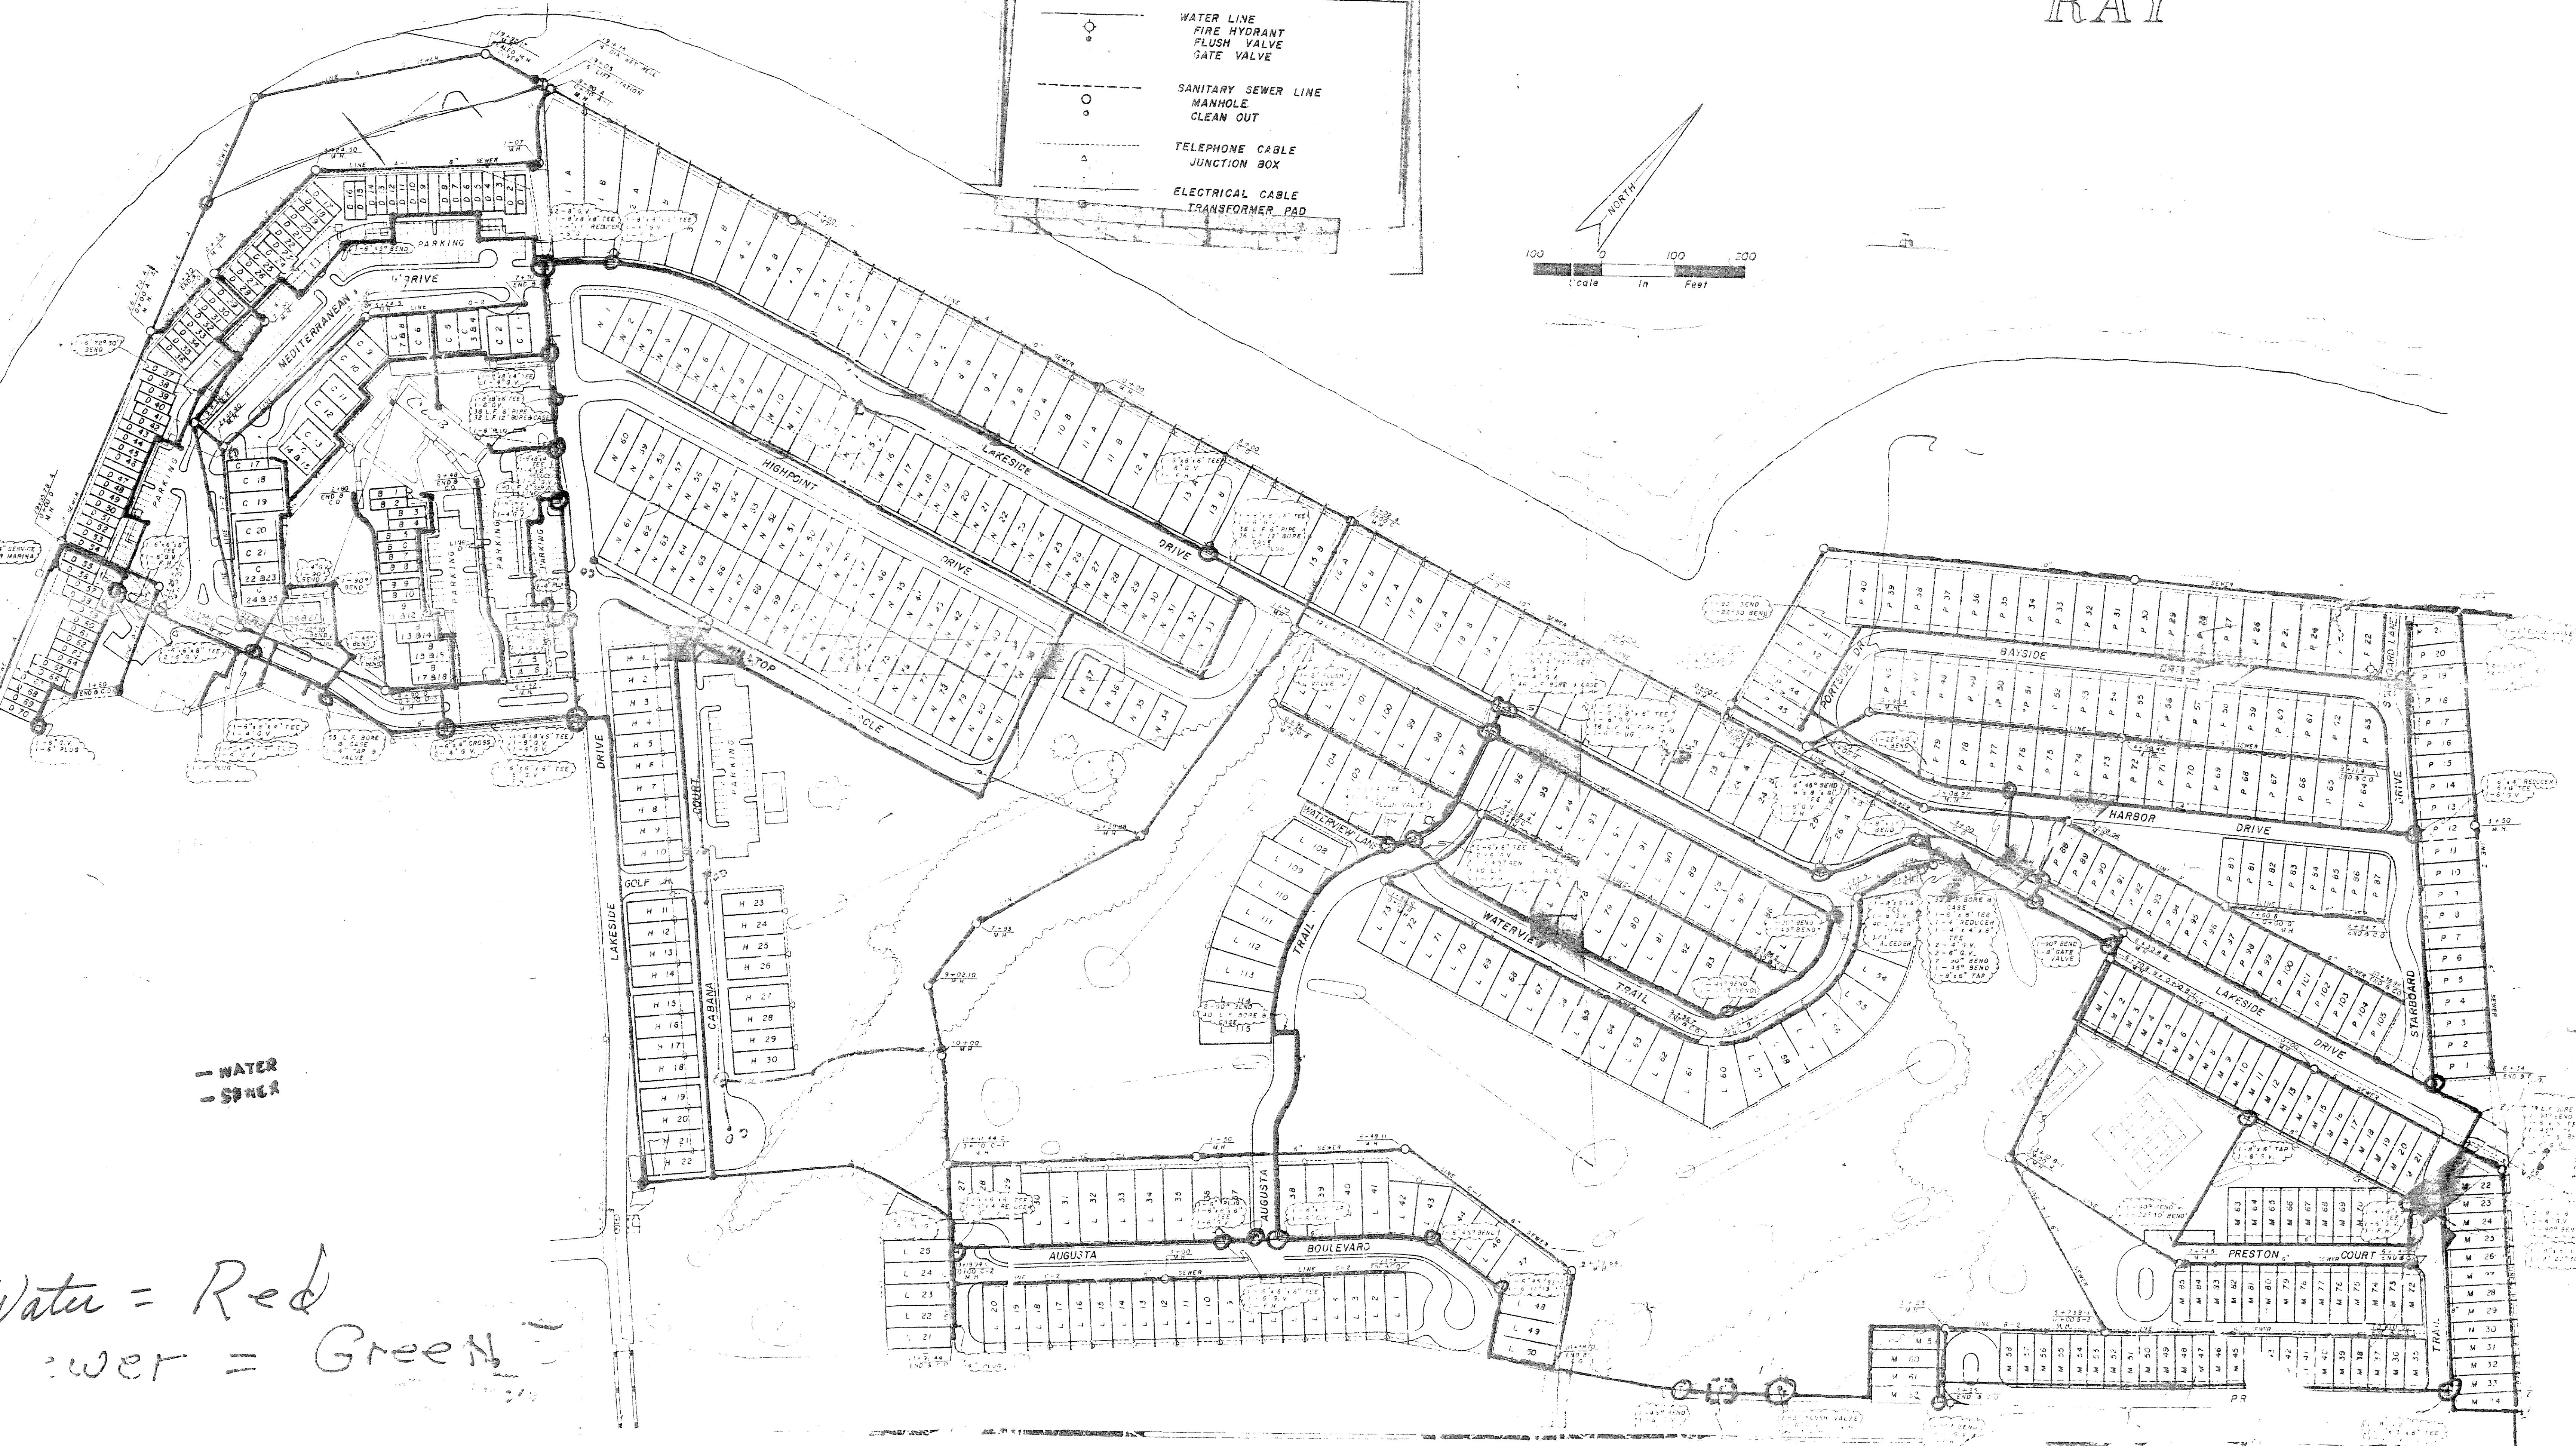
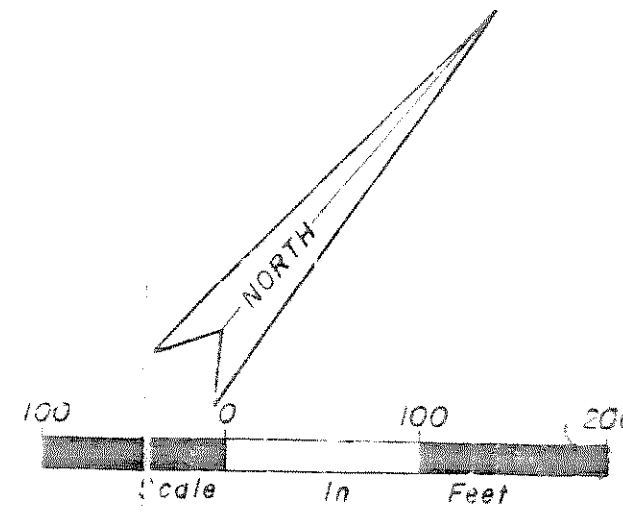


LAKE

RAY

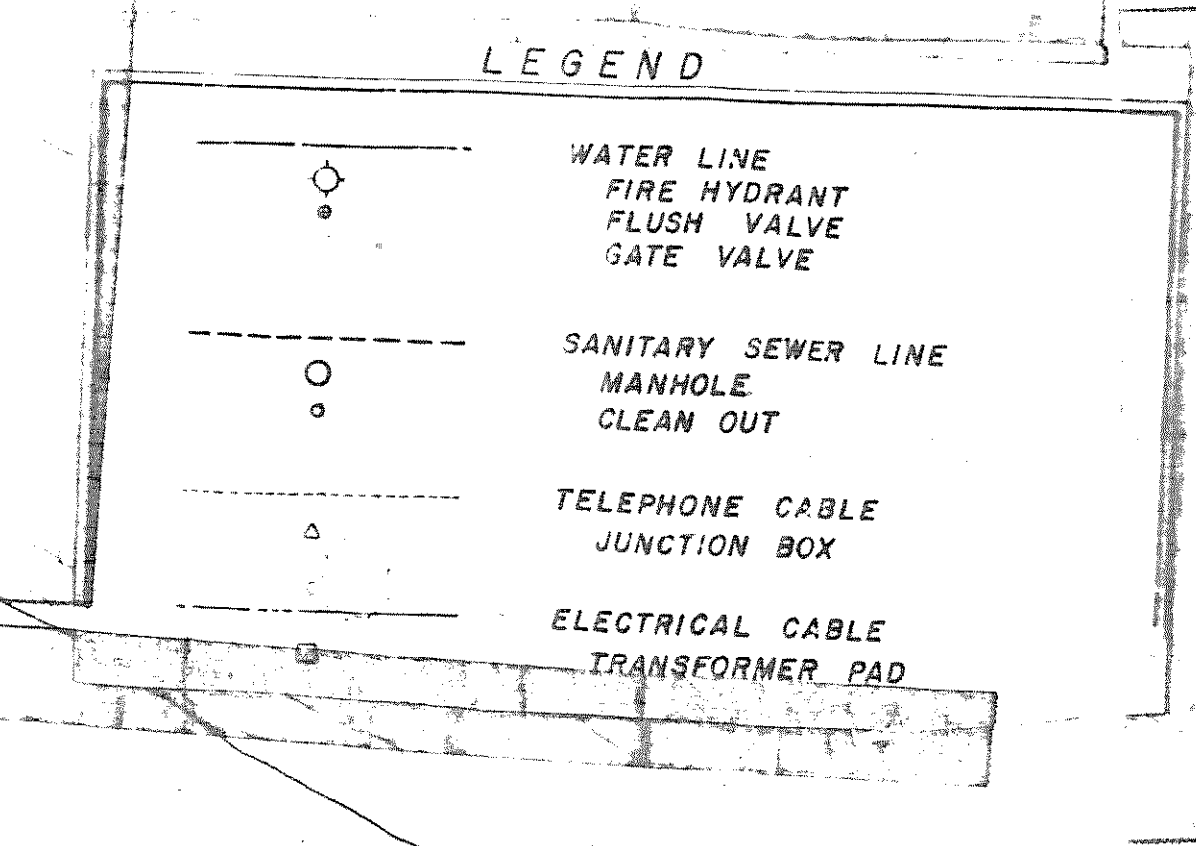

- WATER
- SEWER

Water = Red
Sewer = Green