



FILE: 9802SAN
 VIEW:
 DATE:

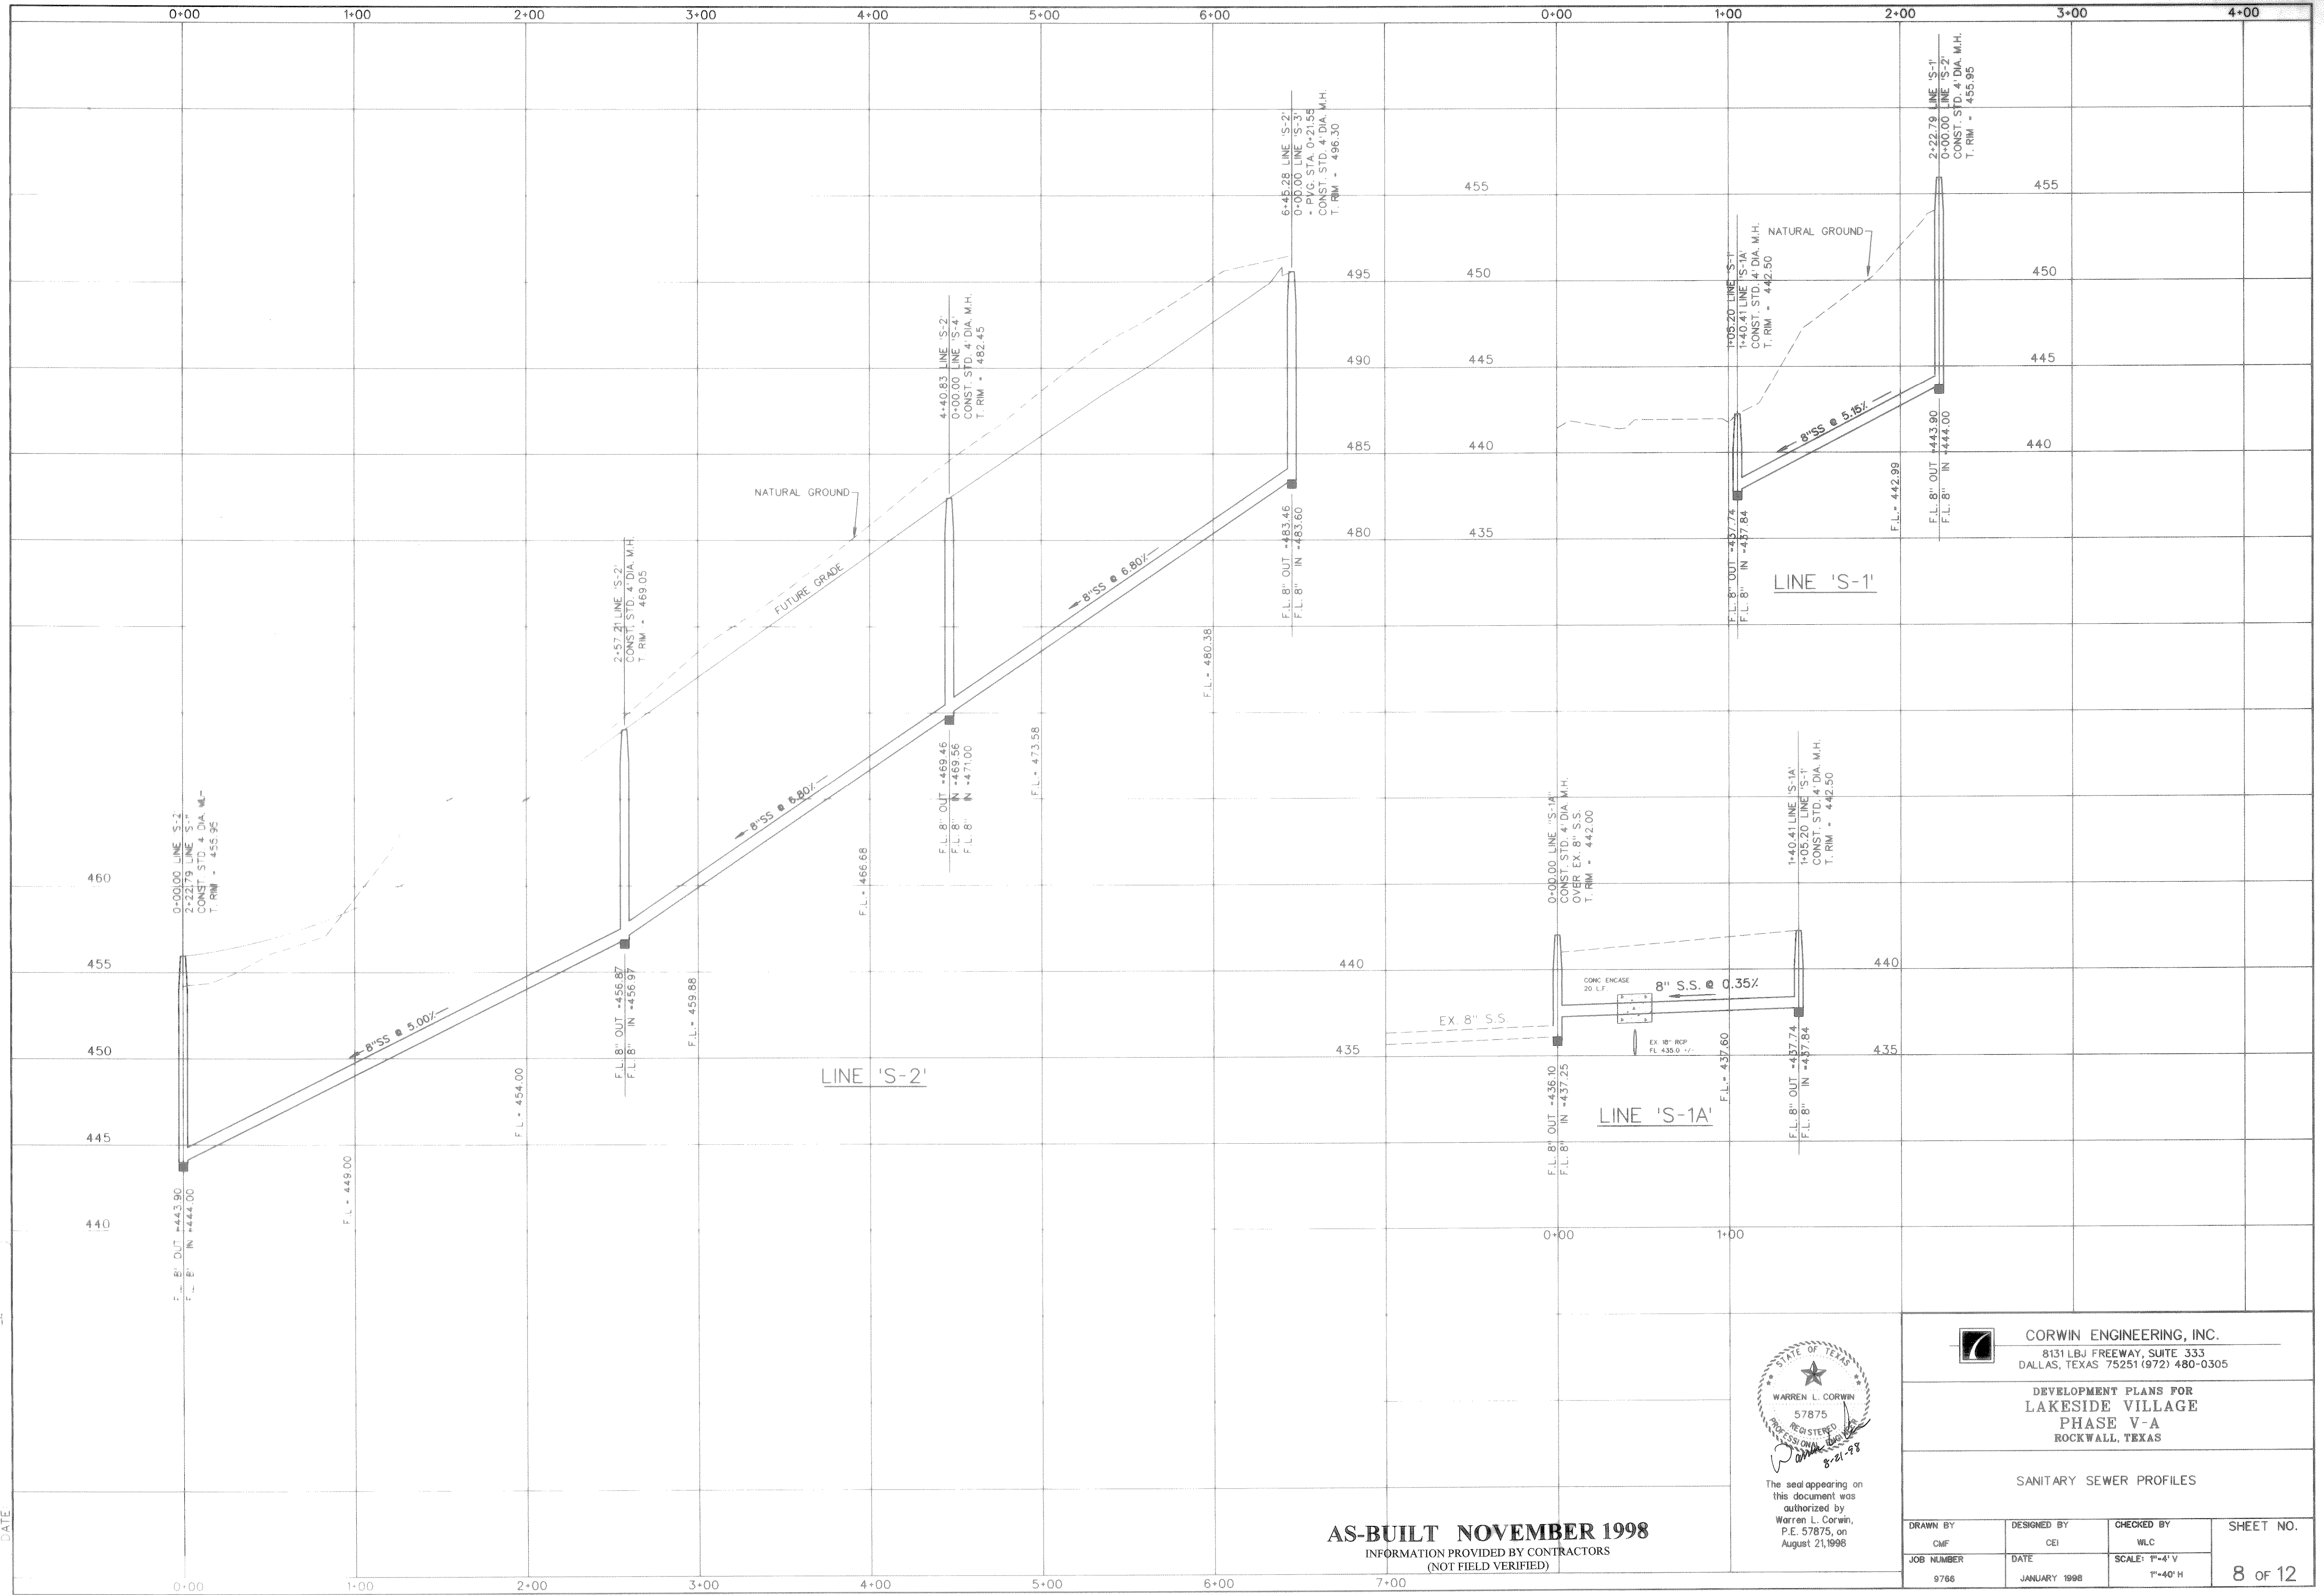

AS-BUILT NOVEMBER 1998
 INFORMATION PROVIDED BY CONTRACTORS
 (NOT FIELD VERIFIED)

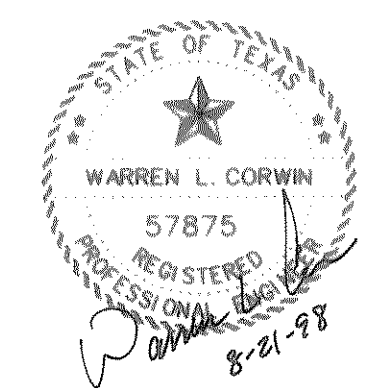

The seal appearing on this document was authorized by Warren L. Corwin, P.E. 57875, on August 21, 1998

CORWIN ENGINEERING, INC.
 8131 LBJ FREEWAY, SUITE 333
 DALLAS, TEXAS 75251 (972) 480-0305

DEVELOPMENT PLANS FOR
LAKE SIDE VILLAGE
 PHASE V-A
 ROCKWALL, TEXAS

SANITARY SEWER PROFILES

DRAWN BY CMF	DESIGNED BY CEI	CHECKED BY WLC	SHEET NO. 8 OF 12
JOB NUMBER 9766	DATE JANUARY 1998	SCALE: 1"=4' V 1"=40' H	