


DEVELOPMENT PLANS
FOR
LAKESIDE VILLAGE
PHASE V-A
CITY OF ROCKWALL, TEXAS

INDEX


1	TITLE
2	PLAT
3	PLAT
4	DRAINAGE AREA MAP
5	SARATOGA DRIVE & PONCHARTRAIN
6	TAHOE DRIVE
7	WATER AND SANITARY SEWER PLAN
8	SANITARY SEWER PROFILES
9	SANITARY SEWER PROFILES
10	STORM SEWER PLAN AND PROFILE LINE 'D-1'
11	GRADING PLAN
12	POLLUTION PREVENTION PLAN

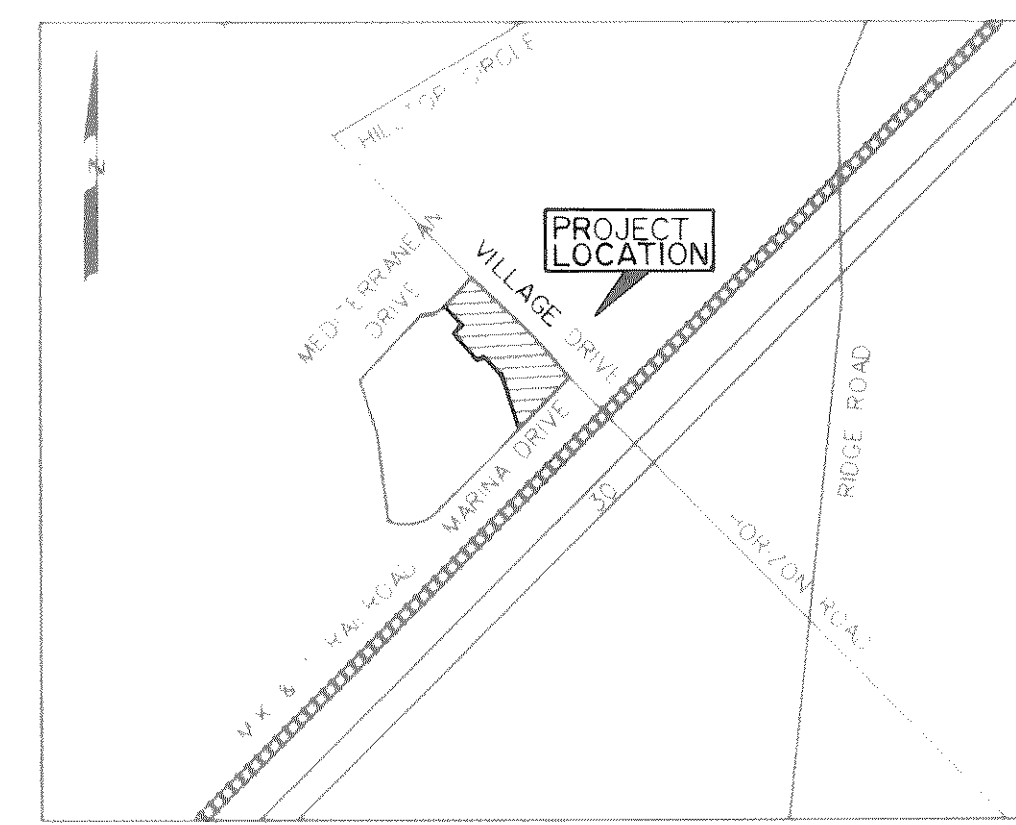

VICINITY MAP
NOT TO SCALE

PREPARED FOR
THE LAKESIDE VILLAGE V, LP
318A DALLAS DRIVE, DENTON, TEXAS 76205

CORWIN ENGINEERING, INC. — CONSULTING ENGINEERS
8131 LBJ FREEWAY, SUITE 333 DALLAS, TEXAS 75251

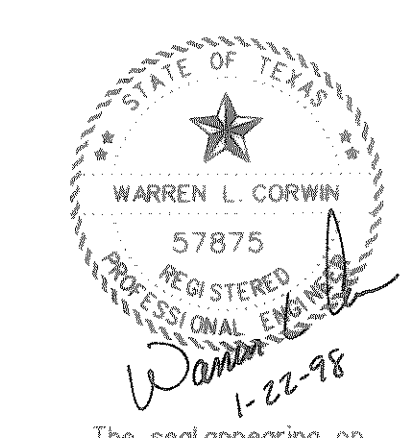

The seal appearing on this document was authorized by Warren L. Corwin, P.E. 57875, on January 22, 1998

AS-BUILT NOVEMBER 1998
INFORMATION PROVIDED BY CONTRACTORS
(NOT FIELD VERIFIED)