


AS-BUILT NOVEMBER 1998
 INFORMATION PROVIDED BY CONTRACTORS
 (NOT FIELD VERIFIED)

JOB NUMBER 9766		DATE JANUARY 1998	SCALE: 1"=40'
DRAWN BY RBS		DESIGNED BY CEI	CHECKED BY CEI
SHEET NO. 5 OF 12			
CORWIN ENGINEERING, INC. 8131 LBJ FREEWAY, SUITE 333 DALLAS, TEXAS 75281 (972) 480-0305			
DEVELOPMENT PLANS FOR LAKEVIEW VILLAGE PHASE V-A ROCKWALL, TEXAS			
SARATOGA DRIVE PONCHARTRAIN DRIVE			

NO.	ADDED INGRESS/EGRESS ESMT.	BY	DATE
1		PUB	5-19-98

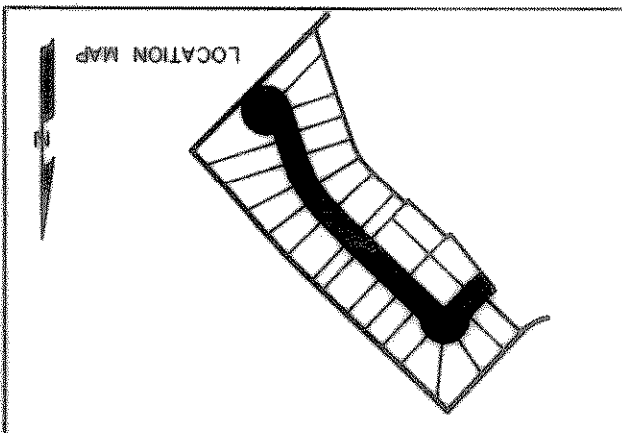

BENCHMARKS:
 "□" found on the top of curb of Lakeside Drive,
 corner of railroad bridge & Lakeside Drive.
 ELEVATION = 506.23

