

CORWIN ENGINEERING, INC.
 8131 LBJ FREEWAY, SUITE 333
 DALLAS, TEXAS 75251 (972) 480-0305

DEVELOPMENT PLANS FOR
**LAKESIDE VILLAGE
 PHASE A-A**
 ROCKWALL, TEXAS


TAMHOE DRIVE

DRAWN BY: RDS
 DESIGNED BY: CEI
 CHECKED BY: CEI

DATE: JANUARY 1998
 SCALE: 1"=40' H


JOB NUMBER: 9766

SHEET NO. 6 OF 12

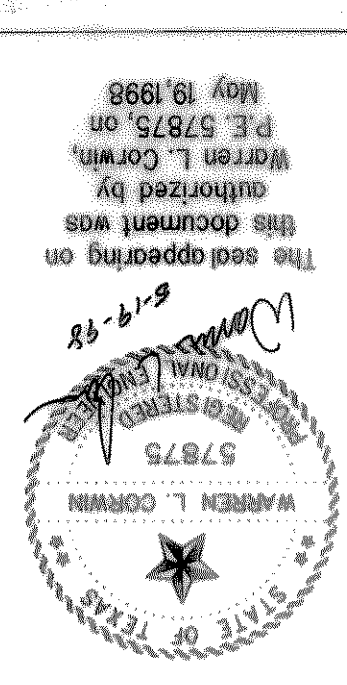

AS-BUILT NOVEMBER 1998
 INFORMATION PROVIDED BY CONTRACTORS
 (NOT FIELD VERIFIED)

NO.	REVISIONS	BY	DATE

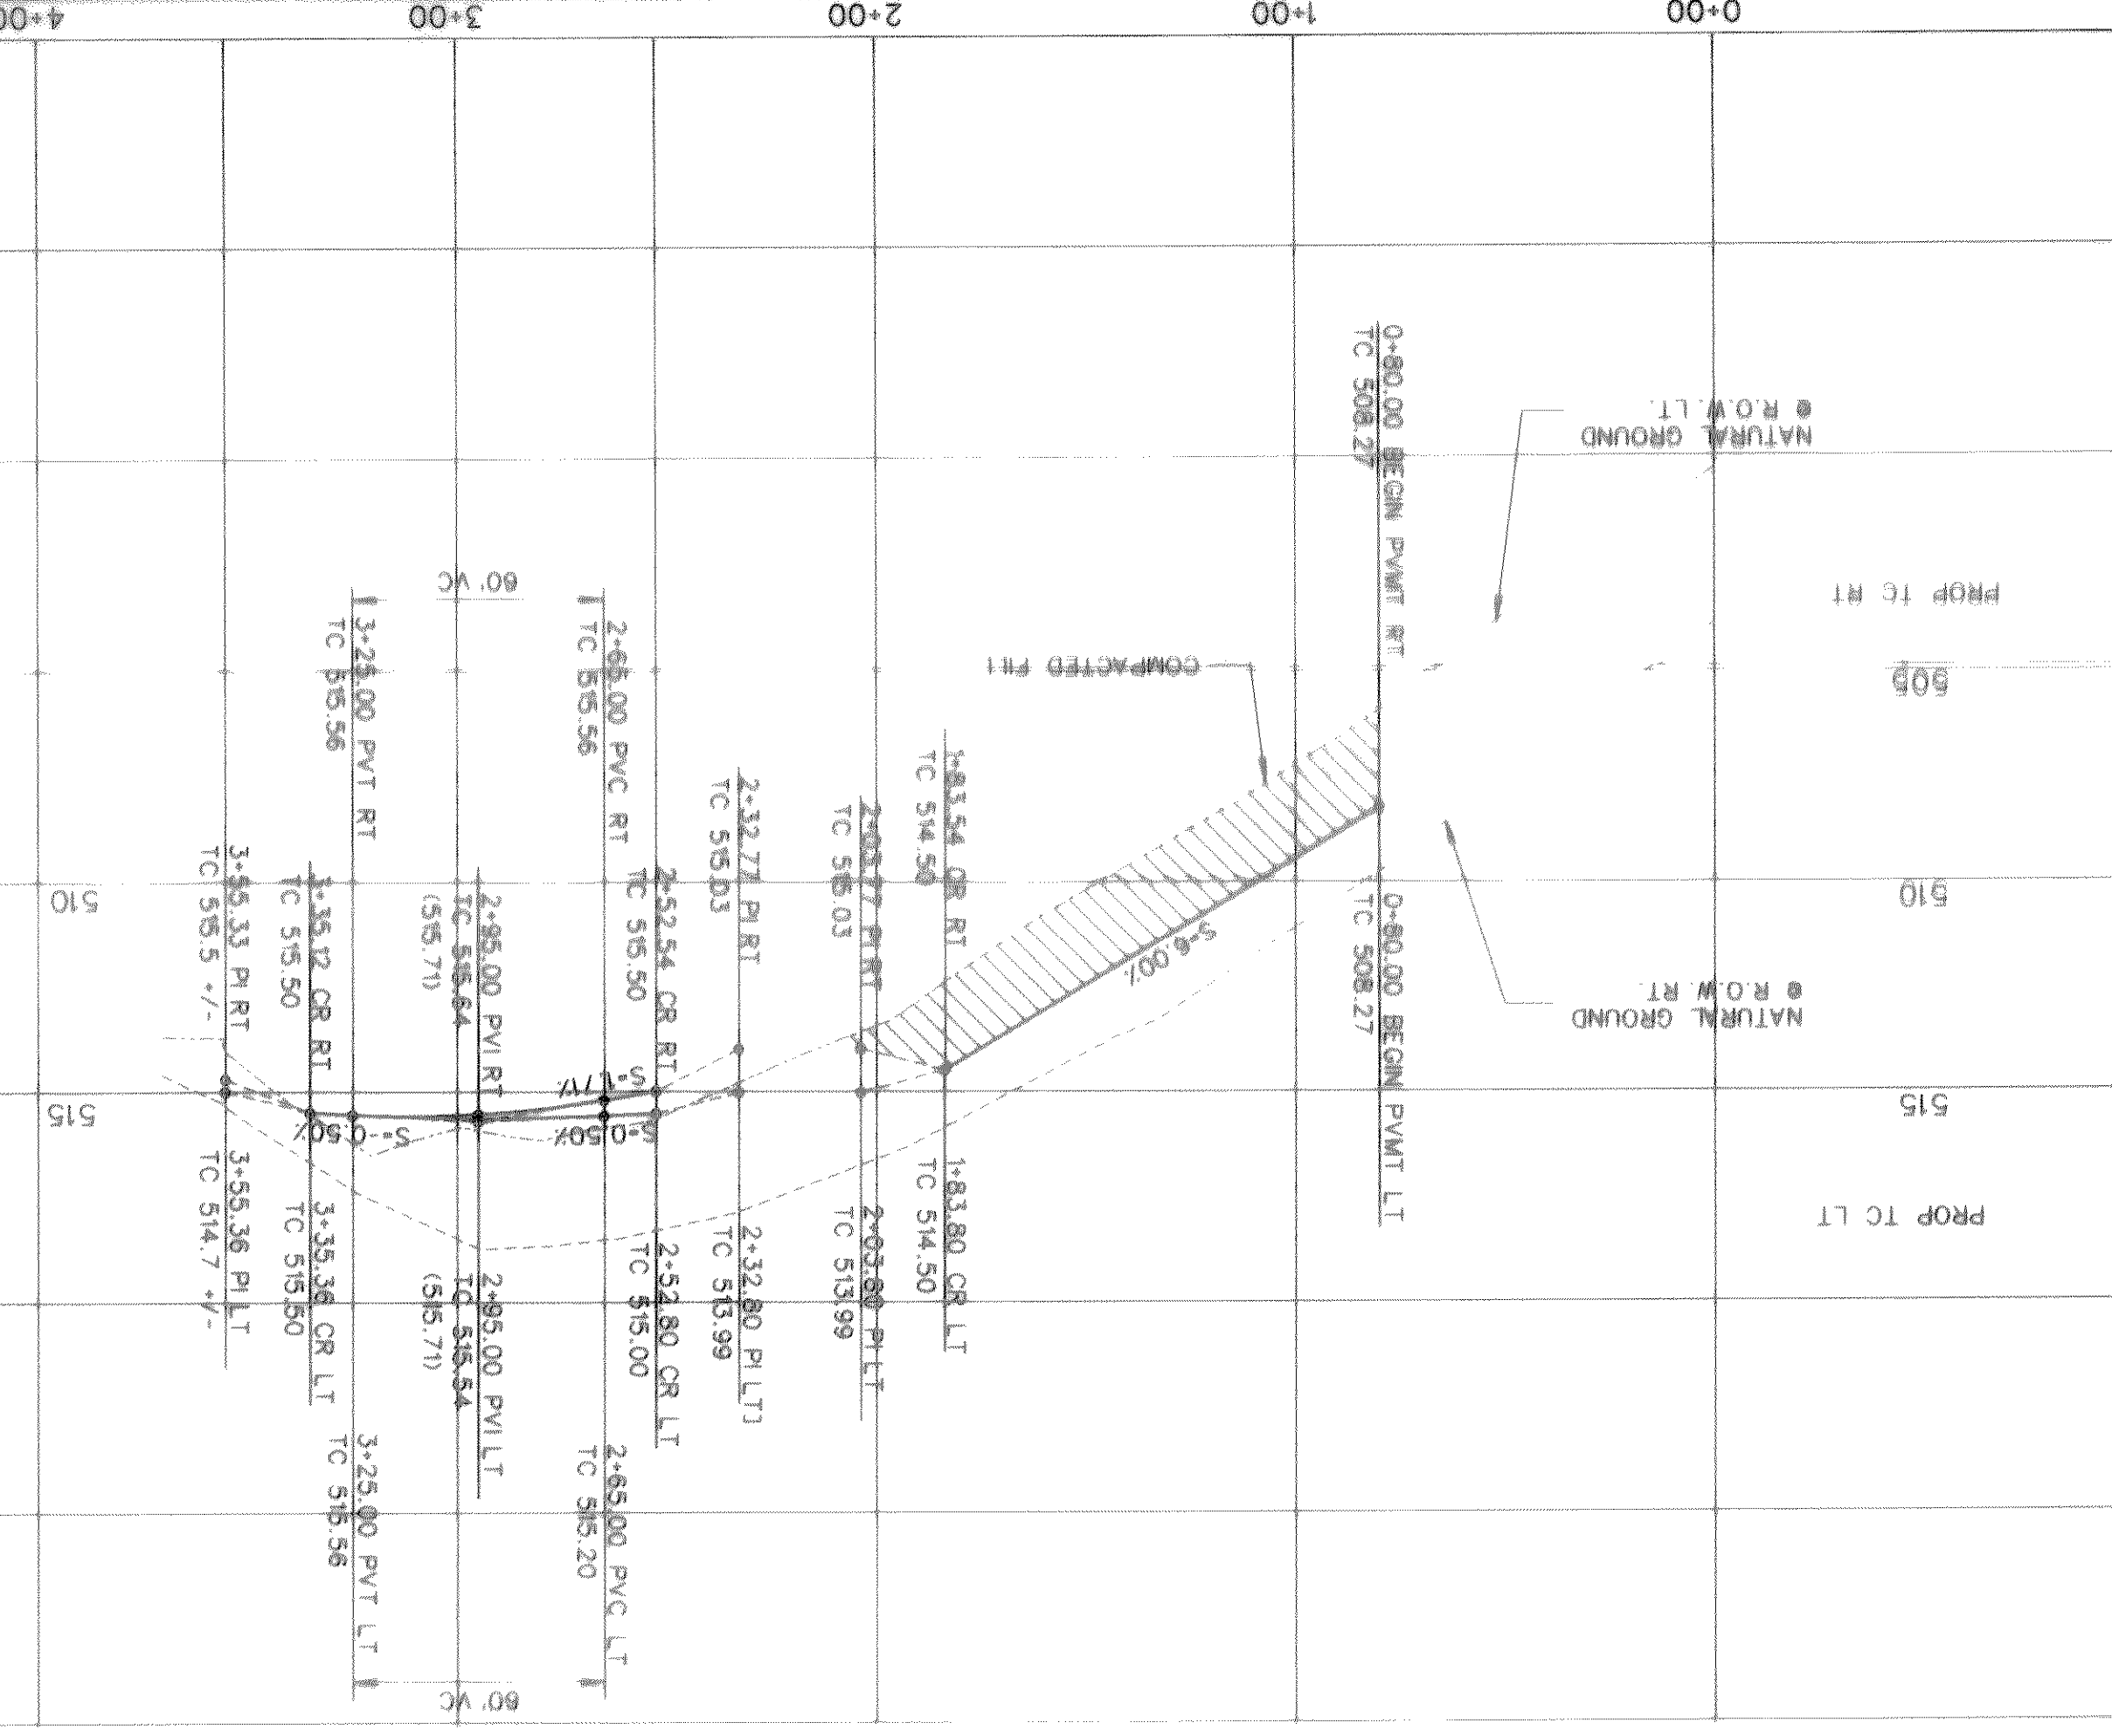

BENCHMARKS:
 "□" found on the top of curb of the northwest corner of railroad bridge & Lakeside Drive.
 ELEVATION = 506.23

