


FILE: 9802SAN
 VIEW:
 DATE:

PF:

AS-BUILT NOVEMBER 1998
 INFORMATION PROVIDED BY CONTRACTORS
 (NOT FIELD VERIFIED)

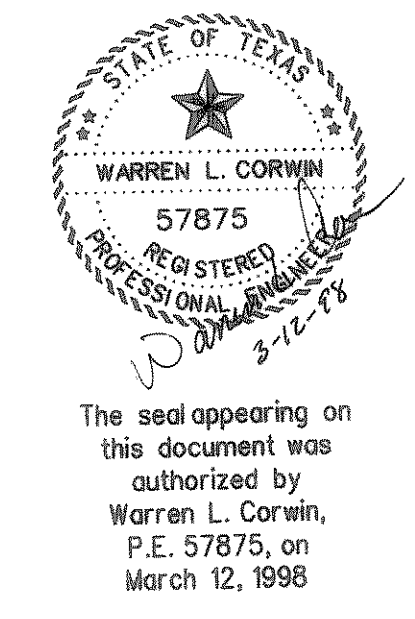

The seal appearing on this document was authorized by Warren L. Corwin, P.E. 57875, on March 12, 1998

NO.	PER CITY COMMENTS	RDS	3-12-98
	REVISIONS	BY	DATE
1			

CORWIN ENGINEERING, INC.
 8131 LBJ FREEWAY, SUITE 333
 DALLAS, TEXAS 75251 (972) 480-0305

**DEVELOPMENT PLANS FOR
 LAKESIDE VILLAGE
 PHASE V-A
 ROCKWALL, TEXAS**

SANITARY SEWER PROFILES

DRAWN BY	DESIGNED BY	CHECKED BY	SHEET NO.
CMF	CEI	WLC	9 of 12
JOB NUMBER	DATE	SCALE: 1"=4'-V 1"=40'-H	
9766	JANUARY 1998		