



BENCHMARKS:  
 "□" found on the top of curb of the northwest corner of railroad bridge @ Lakeside Drive.  
 ELEVATION = 506.23

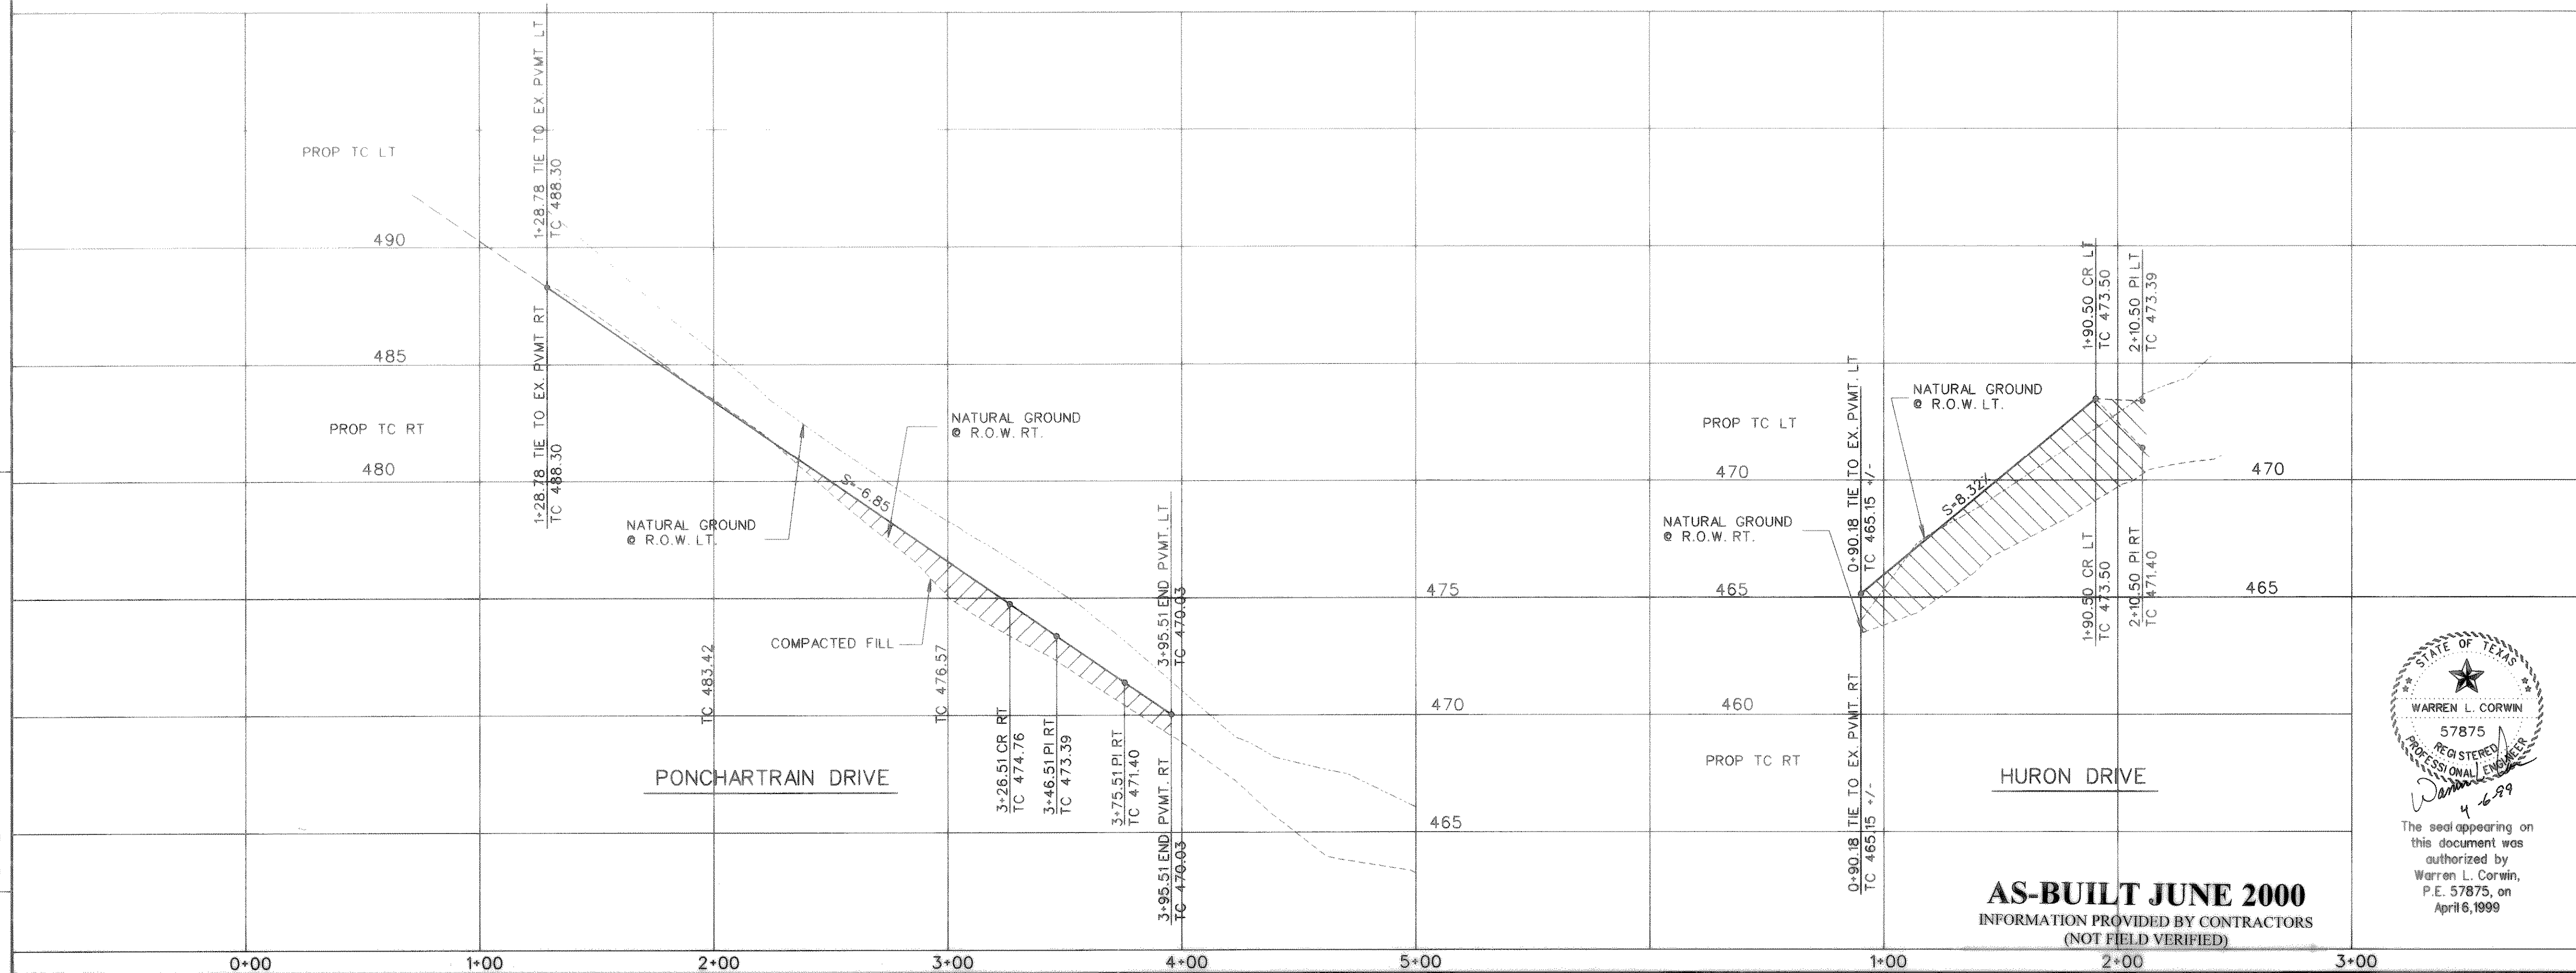

NO.	PER CITY COMMENTS	RDS	4-6-99
1		BY	DATE

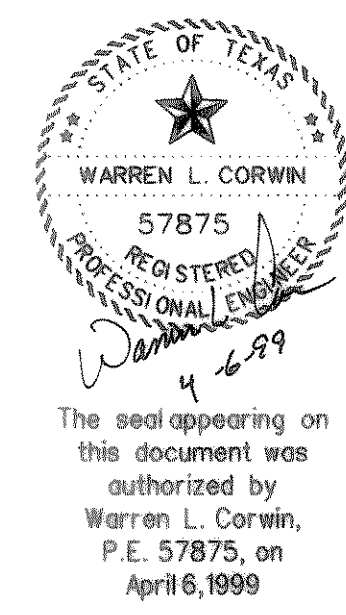

**CORWIN ENGINEERING, INC.**  
 8131 LBJ FREEWAY, SUITE 333  
 DALLAS, TEXAS 75251 (972) 480-0305

DEVELOPMENT PLANS FOR  
**LAKEVILLE VILLAGE**  
 PHASE V-B  
 ROCKWALL, TEXAS

PONCHARTRAIN DRIVE  
 HURON DRIVE

**AS-BUILT JUNE 2000**  
 INFORMATION PROVIDED BY CONTRACTORS  
 (NOT FIELD VERIFIED)

DRAWN BY	DESIGNED BY	CHECKED BY	SHEET NO.
RDS	CEI	CEI	4 OF 10
JOB NUMBER	DATE	SCALE: 1"=4' V 1"=40' H	
9853	OCTOBER 1998		

PF:  
 FILE:  
 REF. FILE:  
 VIEW:  
 DATE: