


SANITARY SEWER CURVE DATA			
CURVE NO.	①	②	③
Δ	16° 08' 03"	11° 21' 04"	" "
R	200.00'	803.00'	" "
T	28.35'	79.80'	" "
L	56.32'	159.09'	" "


- LEGEND**
- PROP. WATER LINE
 - PROP. FIRE HYDRANT AND VALVE
 - PROP. GATE VALVE AND PLUG
 - PROP. FLUSH VALVE
 - EXIST. WATER LINE
 - EXIST. FIRE HYDRANT AND VALVE
 - PROP. SANITARY SEWER
 - PROP. MANHOLE
 - PROP. CLEANOUT
 - EXIST. SANITARY SEWER
 - EXIST. MANHOLE
 - PROP. STORM SEWER
 - PROP. CURB INLETS
 - PROP. CONC. HEADWALL

4+25.00 LINE 'S-1'
 P.V.G. STA. 4+11.23
 CONST. STD. 4' DIA M.H.
 T. RIM = 500.40

SERVICE SCHEDULE		
TYPE	SIZE	NO.
WATER	1"	25
SANITARY	4"	25

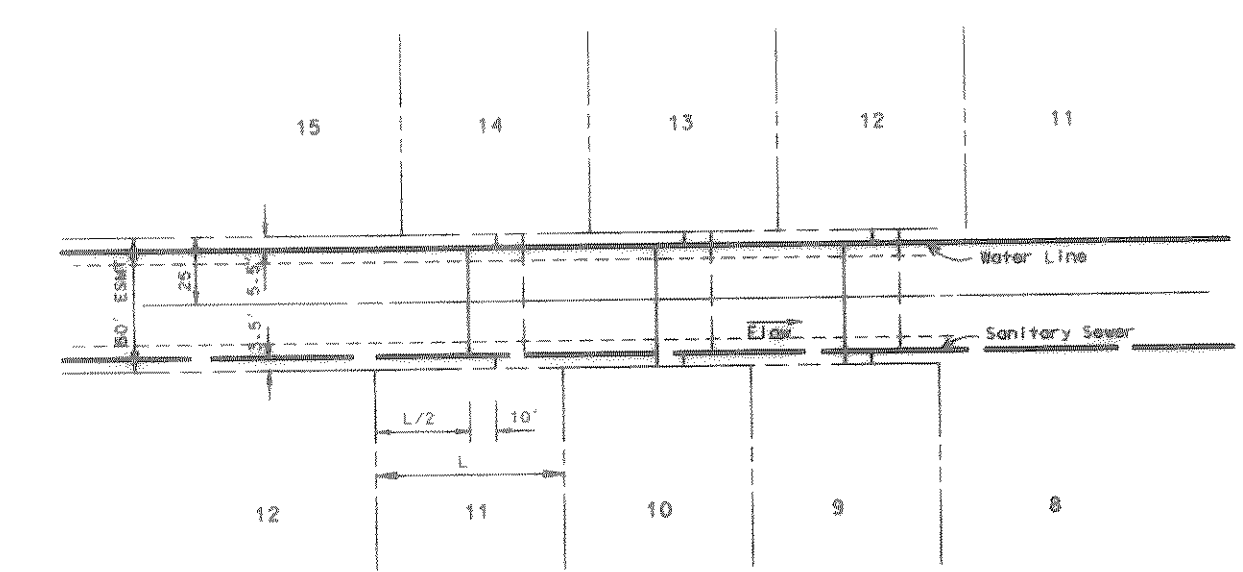


TYPICAL WATER & SEWER SERVICE LAYOUT
 N.T.S.
 END SERVICES AT ESMT.

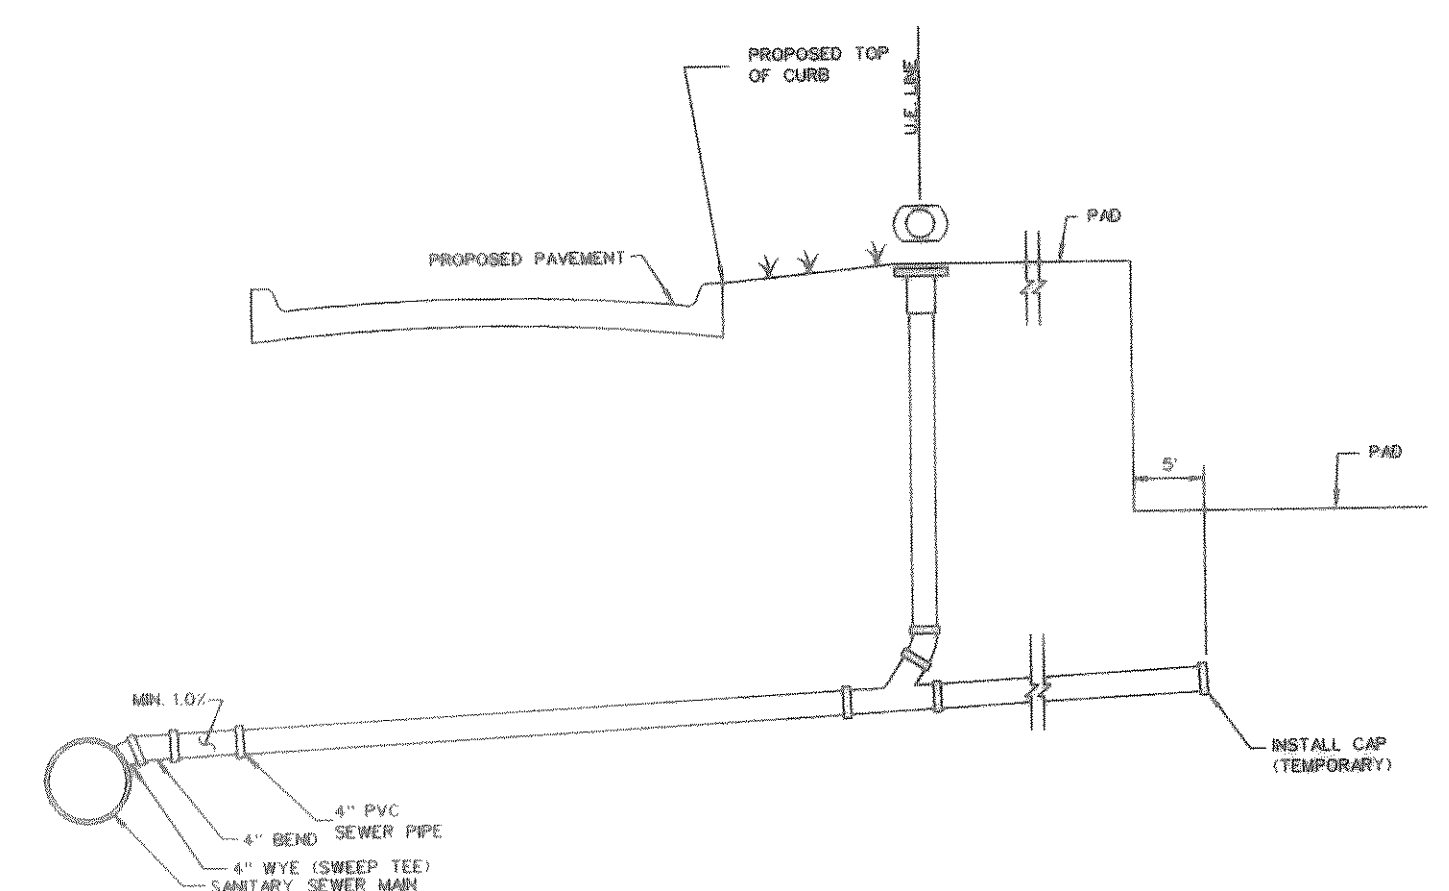

SANITARY SEWER SERVICE DETAIL
 LOTS 9-12 BLK. A
 N.T.S.

- NOTES:**
- CONTRACTOR SHALL VERIFY LOCATION & ELEVATION OF ALL EXISTING UTILITIES PRIOR TO CONSTRUCTION
 - WATERLINES SHALL BE STUBBED OUT A MINIMUM OF 20 LF FROM END OF PAVEMENT.
 - ALL WATER MAINS SHALL BE C-900 PVC CLASS 200.

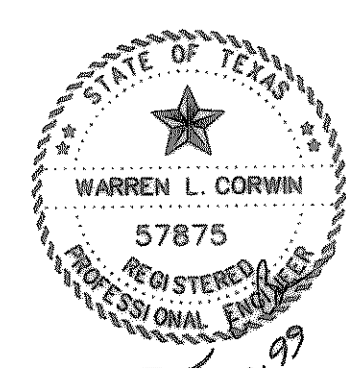

The seal appearing on this document was authorized by Warren L. Corwin, P.E. 57875, on May 18, 1999

CORWIN ENGINEERING, INC.
 8131 LBJ FREEWAY, SUITE 333
 DALLAS, TEXAS 75251 (972) 480-0305

DEVELOPMENT PLANS FOR
LAKESIDE VILLAGE
 PHASE V-B
 ROCKWALL, TEXAS

WATER AND SANITARY SEWER PLAN

DRAWN BY RDS	DESIGNED BY WLC	CHECKED BY WLC	SHEET NO. 6 OF 10
JOB NUMBER 9853	DATE OCTOBER 1998	SCALE: 1"=50'	

AS-BUILT JUNE 2000
 INFORMATION PROVIDED BY CONTRACTORS
 (NOT FIELD VERIFIED)

FILE: PF:
 REF. FILE:
 VIEW:
 DATE: