


DEVELOPMENT PLANS  
FOR  
LAKESIDE VILLAGE  
PHASE V-B  
CITY OF ROCKWALL, TEXAS

INDEX


1	TITLE
2	PLAT
3	DRAINAGE AREA MAP
4	PONCHARTRAIN DRIVE & HURON DRIVE
5	TAHOE DRIVE
6	WATER AND SANITARY SEWER PLAN
7	SANITARY SEWER PROFILES
8	STORM SEWER PLAN AND PROFILE LINE 'D-1' & 'D-2'
8B	STORM SEWER PLAN AND PROFILE LINE 'D-3'
9	GRADING PLAN
10	POLLUTION PREVENTION PLAN

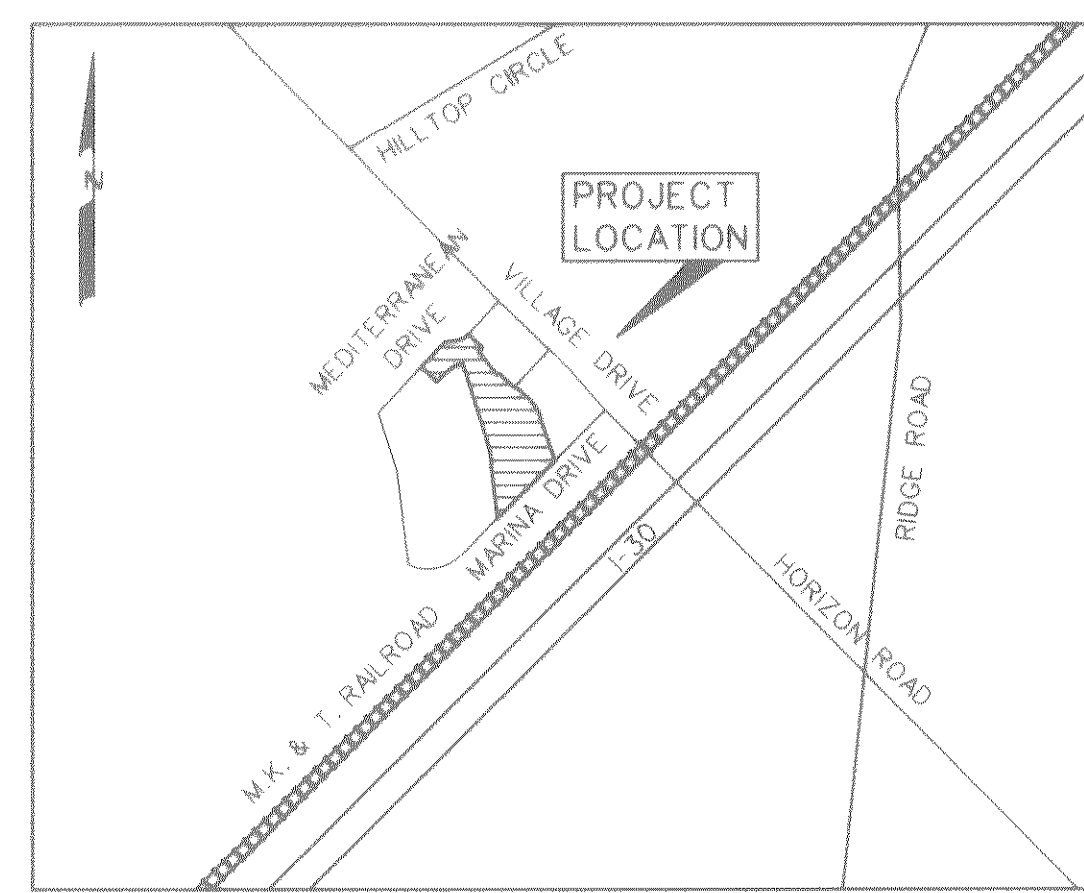

VICINITY MAP  
NOT TO SCALE

PREPARED FOR  
THE LAKESIDE VILLAGE V, LP  
318A DALLAS DRIVE, DENTON, TEXAS 76205

CORWIN ENGINEERING, INC. — CONSULTING ENGINEERS  
8131 LBJ FREEWAY, SUITE 333 DALLAS, TEXAS 75251

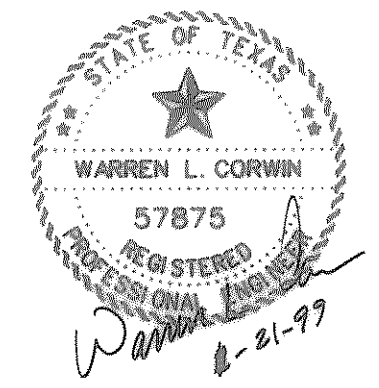

The seal appearing on this document was authorized by Warren L. Corwin, P.E. 57875, on January 21, 1999

AS-BUILT JUNE 2000  
INFORMATION PROVIDED BY CONTRACTORS  
(NOT FIELD VERIFIED)