


### STORM SEWER CALCULATIONS

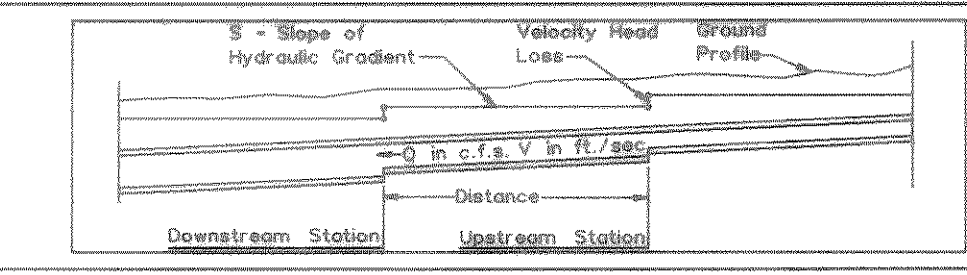

RUNOFF COLLECTION POINT (INLET OR MANHOLE)	Distance Between Collection Points	INCREMENTAL DRAINAGE AREA					Accumulated "CA"	Time at Upstream Station (minutes)	Design Storm Frequency (yrs)	Intensity "I" (inches/hr)	Storm Water Runoff "Q" (c.f.s.)	Slope of Hydraulic Gradient "S" (ft/ft)	Selected Storm Sewer Size (in)	Velocity in Sewer Between Collection Points "V" (ft/s)	Head Loss Coeff. "Kj"	Velocity Head Loss at Upstream Station "V <sup>2</sup> /2g (feet)	Flow Time in Sewer Distance V x 60 (minutes)	Time at Downstream Station (minutes)	Remarks
		Area No.	Drainage Area (Acres)	Runoff Coeff. "C"	Incremental "CA"	"CA"													
LINE D-1																			
3+46	1+31	234	1.7	0.5	0.85	0.85	10.00	100	9.8	7.4	0.49	18"	3.5	0.1	0.27	0.30	10.30		
1+31	1+00	31	1.8	0.5	0.90	1.75	10.30	100	9.8	16.2	2.37	18"	3.4	0.5	0.68	0.03	10.33		
1+00	0+85	15	1.8	0.5	0.90	1.75	10.33	100	9.8	16.2	0.51	24"	5.2	0.1	0.10	0.04	10.37		
LINE D-2																			
3+10	1+00	210	2.5	0.5	1.25	1.25	10.00	100	9.8	12.6	1.43	18"	7.1	1.25	0.30	0.25	10.25		
1+00	0+75	25	2.5	0.5	1.25	1.25	10.25	100	9.8	12.6	0.31	24"	4.0	0.1	0.10	0.10	10.35		
LINE D-3																			
5+22	5+07	15	5.4	0.5	2.7	2.7	10.00	100	9.8	26.5	0.40	30"	5.4	0.1	0.89	0.01	10.01		
5+07	2+30	277	5.4	0.5	2.7	2.7	10.01	100	9.8	26.5	0.40	30"	5.4	0.1	0.83	0.33	10.34		

### INLET DESIGN CALCULATIONS

INLET NO.	Location	AREA RUNOFF					Carry-Over from Upstream	Total Gutter Flow (c.f.s.)	Gutter Capacity (c.f.s.)	Gutter Slope (ft./100 ft.)	SELECTED INLET		Inlet Capacity (c.f.s.)	
		Design Storm Frequency	Time of Conc. (min.)	Intensity "I" (in/hr)	Runoff Coeff. "C"	Area "A" (ac.)					Length "L" (ft.)	Type		
1	Pvg STA 4+16	100	10	9.80	0.50	2.6	12.6	12.6	30.0	-	Lw Pt	10'	STD	21.0


### RUNOFF COMPUTATIONS

DRAINAGE AREA NO.	AC	RUNOFF COEFF. (C)	TOTAL C x A	Tc (min)	I (100')	Q (100) cfs
1	2.5	0.50	1.25	10	9.80	12.6
2	2.1	0.50	1.05	10	9.80	10.3
3	0.6	0.50	0.30	10	9.80	2.8
4	1.8	0.50	0.90	10	9.80	8.8
5	2.1	0.50	1.55	10	9.80	10.5


NOTE:  
 RUNOFF FROM DRAINAGE AREAS \*2, \*4 & \*5 TO BE PICKED UP WITH FUTURE PHASES

### LEGEND

- PROP. STORM SEWER
- PROP. CURB INLETS
- PROP. CONC. HEADWALL
- EXIST. STORM SEWER
- DRAINAGE AREA DIVIDE
- FLOW ARROW
- DRAINAGE AREA NO.
- INLET NO.

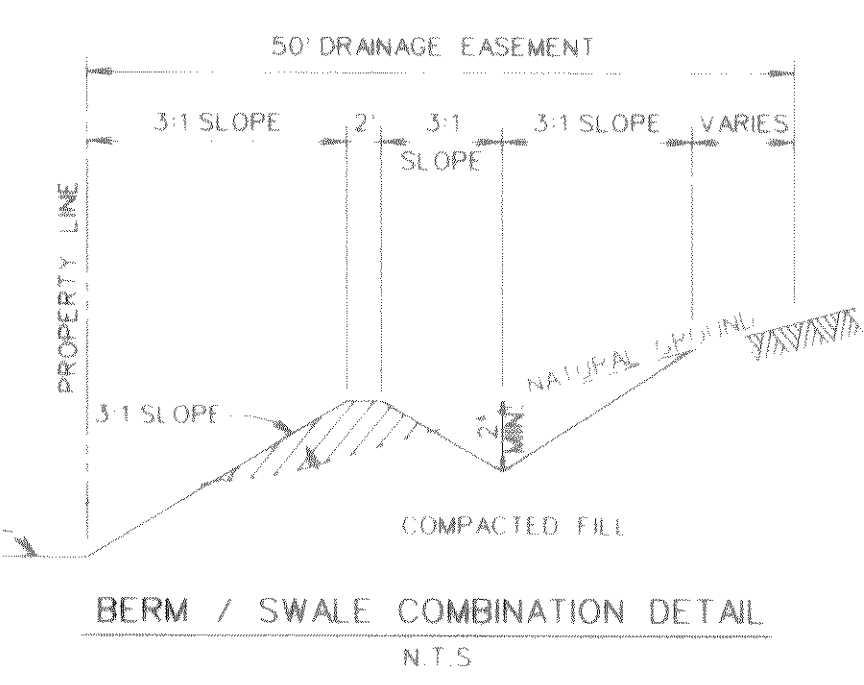

NOTE:  
 DRAINAGE AREAS NO 1 & 5 SHALL BE GRADED TO EX 2-27" RCP AT SOUTH CORNER OF SITE.  
 Q<sub>ULT</sub> = 54.0 cfs  
 Q<sub>CAP</sub> = 83.5 cfs

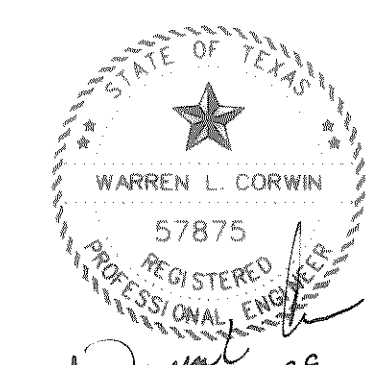

The seal appearing on this document was authorized by Warren L. Corwin, P.E. 57875, on July 9, 1999

**AS-BUILT JUNE 2000**  
 INFORMATION PROVIDED BY CONTRACTORS (NOT FIELD VERIFIED)

1	PER CITY COMMENTS	RDS	4-6-99
NO.	REVISIONS	BY	DATE
<b>CORWIN ENGINEERING, INC.</b> 8131 LBJ FREEWAY, SUITE 333 DALLAS, TEXAS 75251 (972) 480-0305			
<b>DEVELOPMENT PLANS FOR LAKESIDE VILLAGE PHASE V-B CORINTH, TEXAS</b>			
DRAINAGE AREA MAP			
DRAWN BY	DESIGNED BY	CHECKED BY	SHEET NO.
RDS	CEI	WLC	3 OF 10
JOB NUMBER	DATE	SCALE:	
9853	OCTOBER 1998	1"=50'	