

0+00 1+00 2+00 3+00 4+00 5+00 6+00

505
500
495

PROPOSED GRADE

PAD LT.
PAD RT.

8" S.S. @ 0.40%

0+00.00 LINE S-1
TIE TO EX. M.H. - 504.45
ADJUST T. RM. - 504.45

EX. F.L. 8" OUT - 493.26
F.L. 8" IN - 493.36

4+25.00 LINE S-1
P.C. STA. = +112.3
CONST. STD. 4" DIA. M.H.
T. RM. = 500.40

F.L. - 493.76
F.L. - 494.16
F.L. - 494.56
F.L. - 494.96
F.L. 8" OUT - 495.06


LINE 'S-1'

0+00 1+00 2+00 3+00 4+00 5+00 6+00 7+00

FILE: 9802SAN
VIEW:
DATE:

PF:

AS-BUILT JUNE 2000
INFORMATION PROVIDED BY CONTRACTORS
(NOT FIELD VERIFIED)

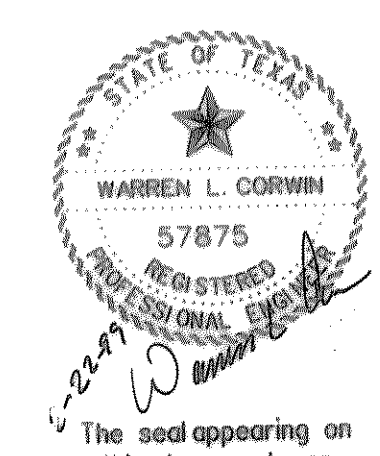

The seal appearing on this document was authorized by Warren L. Corwin, P.E. 57875, on October 21, 1998

CORWIN ENGINEERING, INC.
8131 LBJ FREEWAY, SUITE 333
DALLAS, TEXAS 75251 (972) 480-0305

DEVELOPMENT PLANS FOR
LAKESIDE VILLAGE
PHASE V-B
ROCKWALL, TEXAS

SANITARY SEWER PROFILES

DRAWN BY CMF	DESIGNED BY CEI	CHECKED BY WLC	SHEET NO. 7 OF 10
JOB NUMBER 9853	DATE OCTOBER 1998	SCALE: 1"=4' V 1"=40' H	