



0 20 40 80
SCALE: 1" = 40'

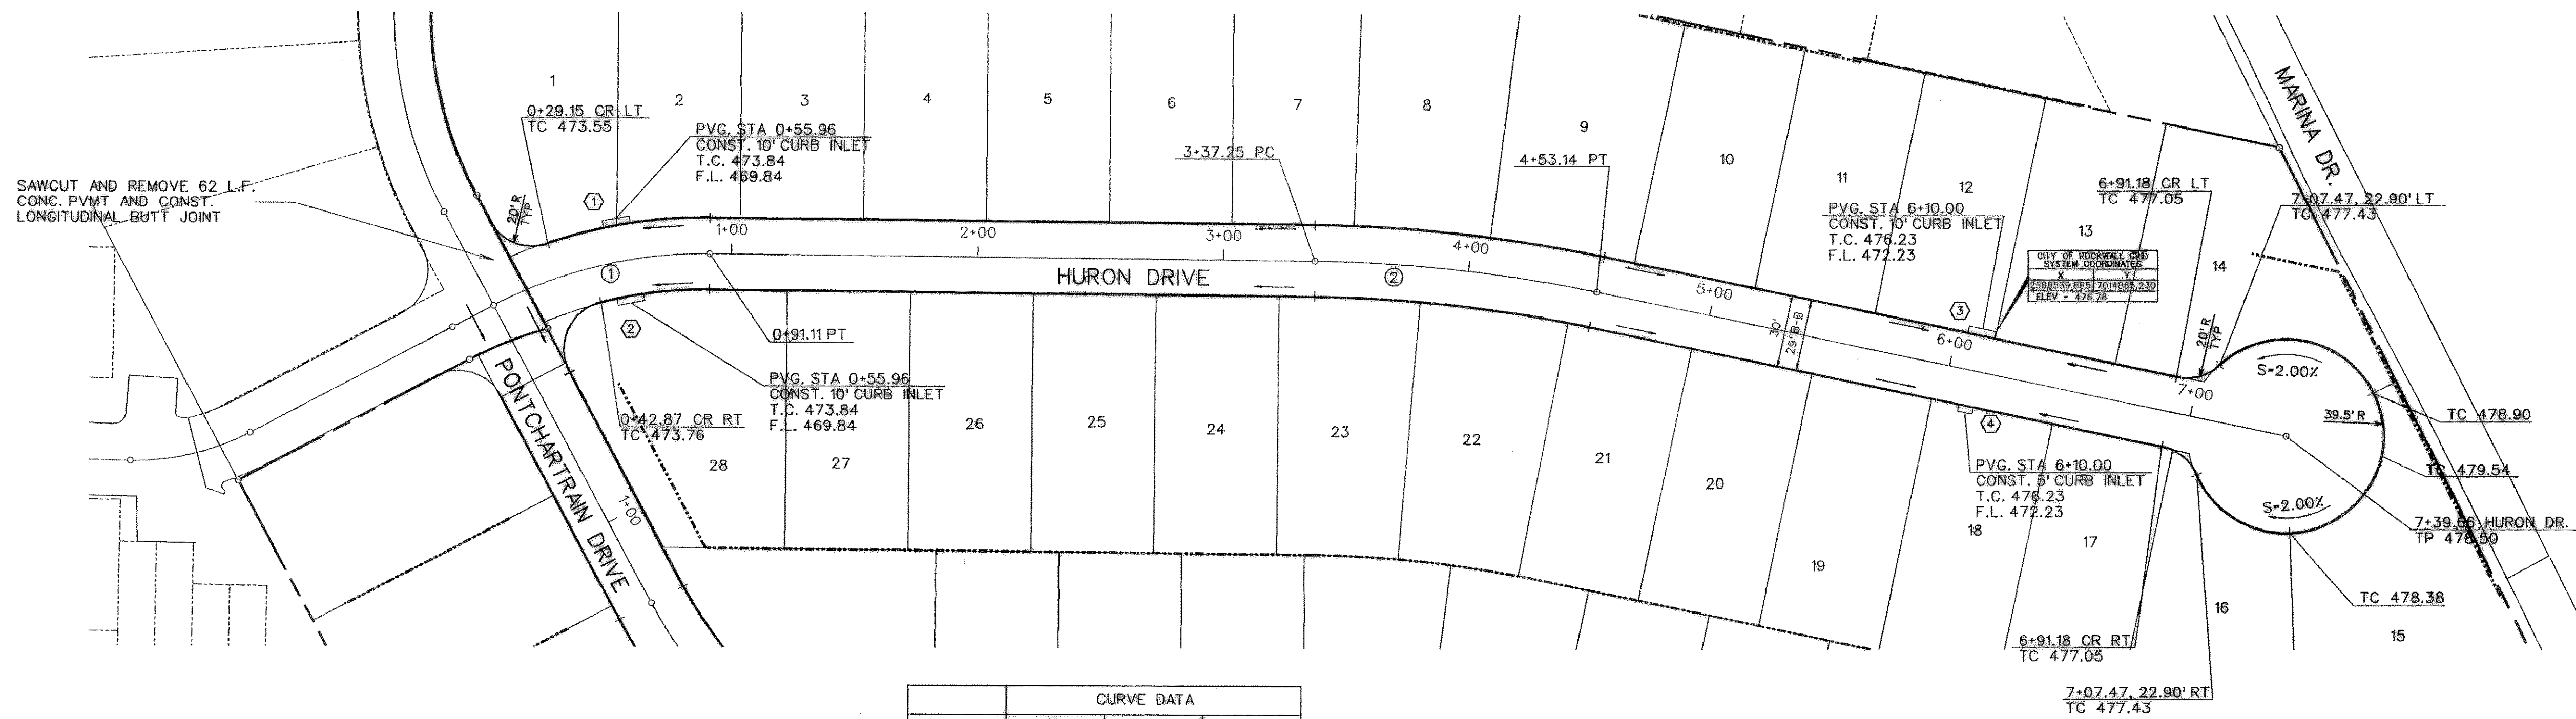


CURVE DATA			
CURVE NO.	①	②	③
Δ	28° 13' 08"	11° 21' 04"	° ' "
R	185.00'	585.00'	'
T	46.50'	58.14'	'
L	91.11'	115.90'	'

BENCHMARKS:
"□" found on the top of curb of the northwest corner of railroad bridge @ Village Drive.
ELEVATION = 506.23

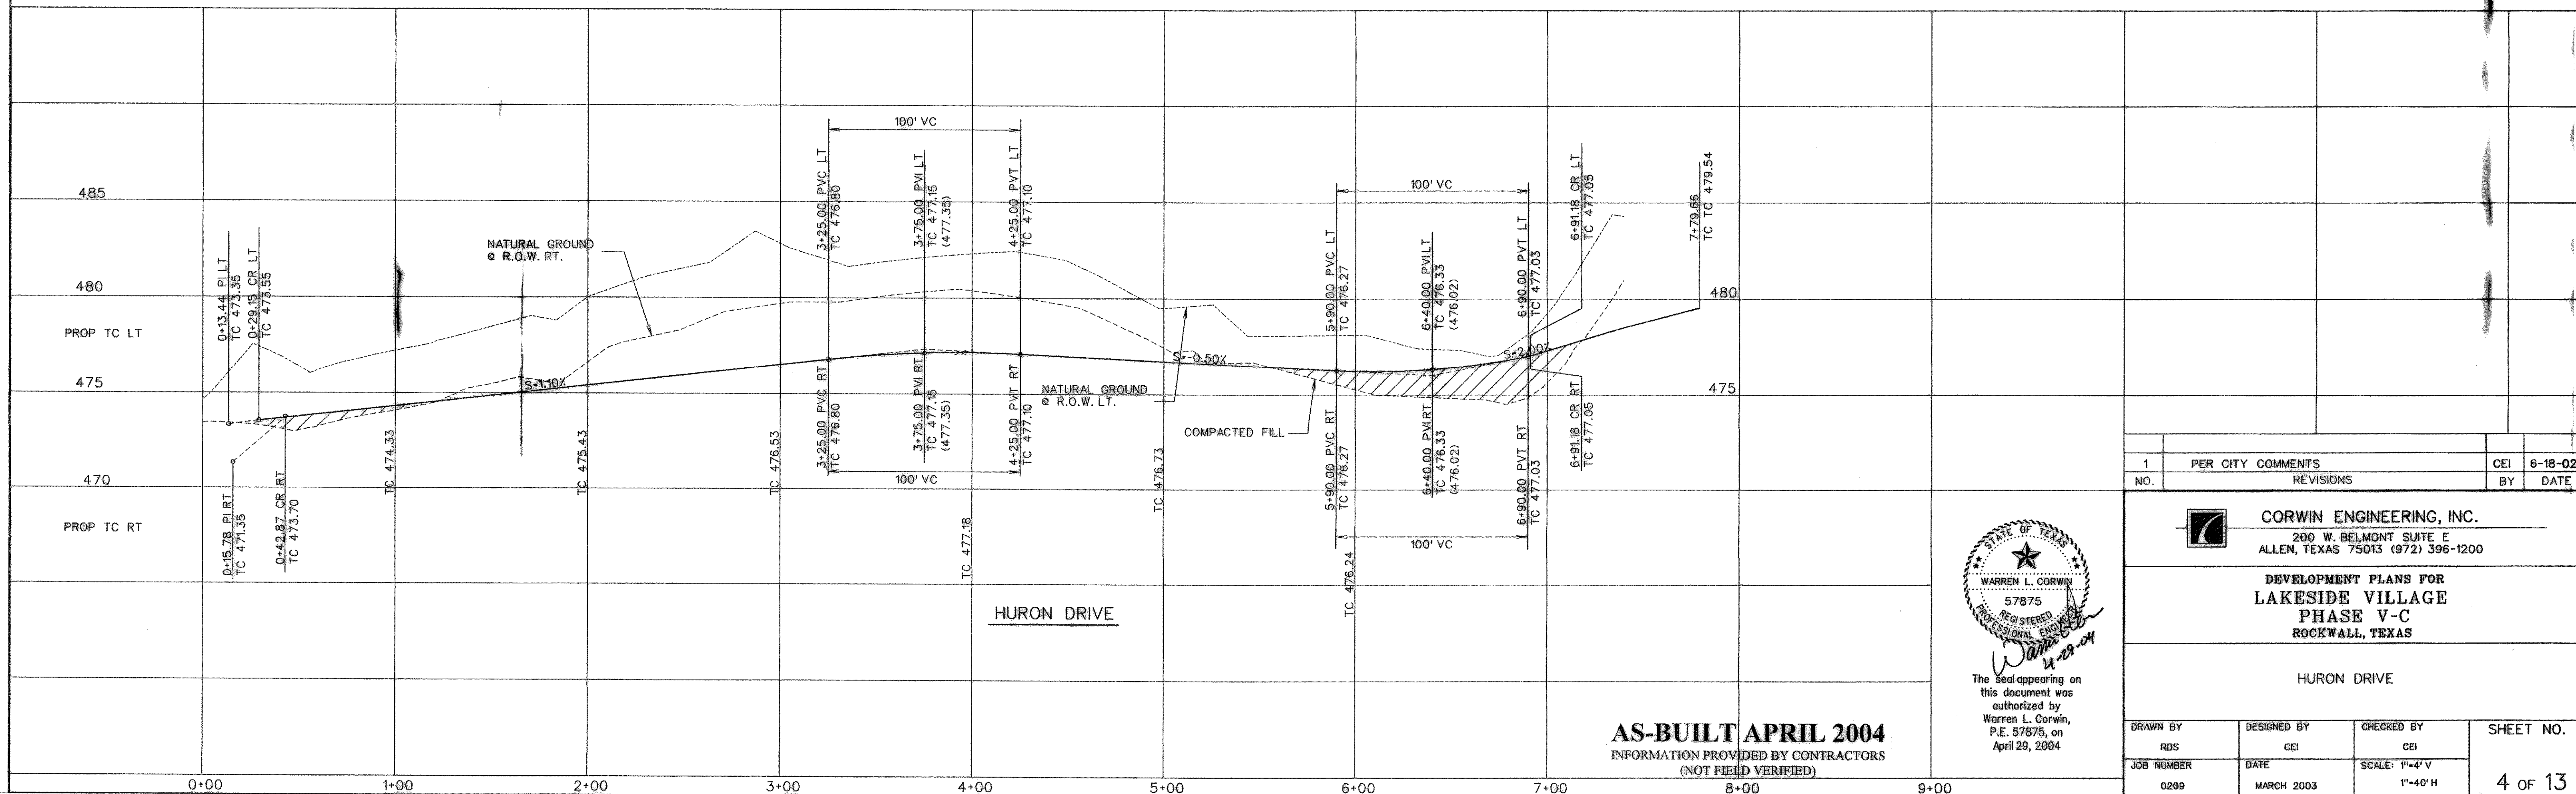

1	PER CITY COMMENTS	CEI	6-18-02
NO.	REVISIONS	BY	DATE

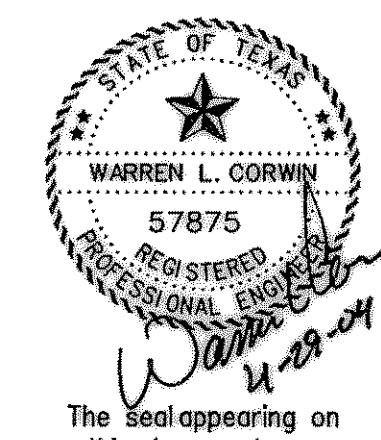

The seal appearing on this document was authorized by Warren L. Corwin, P.E. 57875, on April 29, 2004

AS-BUILT APRIL 2004
INFORMATION PROVIDED BY CONTRACTORS
(NOT FIELD VERIFIED)

CORWIN ENGINEERING, INC.
200 W. BELMONT SUITE E
ALLEN, TEXAS 75013 (972) 396-1200

DEVELOPMENT PLANS FOR LAKESIDE VILLAGE PHASE V-C
ROCKWALL, TEXAS

HURON DRIVE

DRAWN BY RDS	DESIGNED BY CEI	CHECKED BY CEI	SHEET NO. 4 OF 13
JOB NUMBER 0209	DATE MARCH 2003	SCALE: 1"=4' V 1"=40' H	