

LEGEND


- PROP. WATER LINE
- PROP. FIRE HYDRANT AND VALVE
- PROP. GATE VALVE AND PLUG
- PROP. FLUSH VALVE
- EXIST. WATER LINE
- EXIST. FIRE HYDRANT AND VALVE
- PROP. SANITARY SEWER
- PROP. MANHOLE
- PROP. CLEANOUT
- EXIST. SANITARY SEWER
- EXIST. MANHOLE
- PROP. STORM SEWER
- PROP. CURB INLETS
- PROP. CONC. HEADWALL

SERVICE SCHEDULE		
TYPE	SIZE	NO.
WATER	1"	61
SANITARY	4"	61

SANITARY SEWER CURVE DATA			
CURVE NO.	①	②	③
Δ	11° 21'04"	22° 50'39"	11° 21'04"
R	563.50'	200.00'	328.50'
T	56.00'	40.41'	32.65'
L	111.64'	79.74'	65.08'

NOTES:

1. CONTRACTOR SHALL VERIFY LOCATION & ELEVATION OF ALL EXISTING UTILITIES PRIOR TO CONSTRUCTION
2. WATERLINES SHALL BE STUBBED OUT A MINIMUM OF 20 LF FROM END OF PAVEMENT.
3. ALL WATER MAINS SHALL BE C-900 PVC CLASS 200.
4. WASTEWATER LATERALS SHALL BE INSTALLED IN ACCORDANCE WITH CITY OF ROCKWALL STANDARD DETAIL "WASTEWATER LATERAL CONNECTIONS."

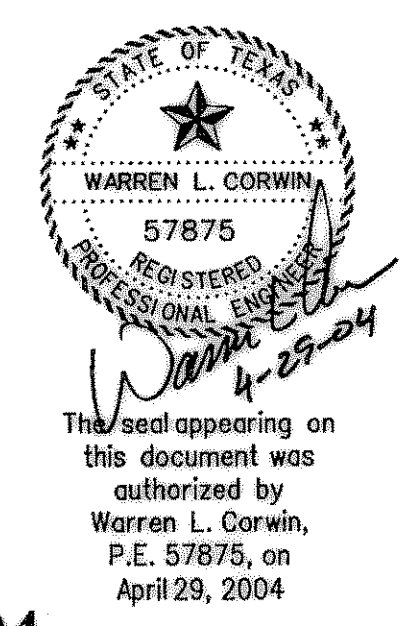

CORWIN ENGINEERING, INC. 8131 LBJ FREEWAY, SUITE 333 DALLAS, TEXAS 75251 (972) 480-0305			
DEVELOPMENT PLANS FOR LAKESIDE VILLAGE PHASE V-C ROCKWALL, TEXAS			
WATER AND SANITARY SEWER PLAN			
DRAWN BY CMF	DESIGNED BY WLC	CHECKED BY WLC	SHEET NO. 6 OF 13
JOB NUMBER 0209	DATE MARCH 2003	SCALE 1"=50'	

AS-BUILT APRIL 2004
 INFORMATION PROVIDED BY CONTRACTORS
 (NOT FIELD VERIFIED)