


CURVE DATA			
CURVE NO.	①	②	③
Δ	26° 20' 04"	39° 01' 13"	° ' "
R	65.00'	65.00'	'
T	15.21'	23.03'	'
L	29.88'	44.27'	'

BENCHMARKS:
 "□" found on the top of curb of the northwest corner of railroad bridge & Village Drive.
 ELEVATION = 506.23

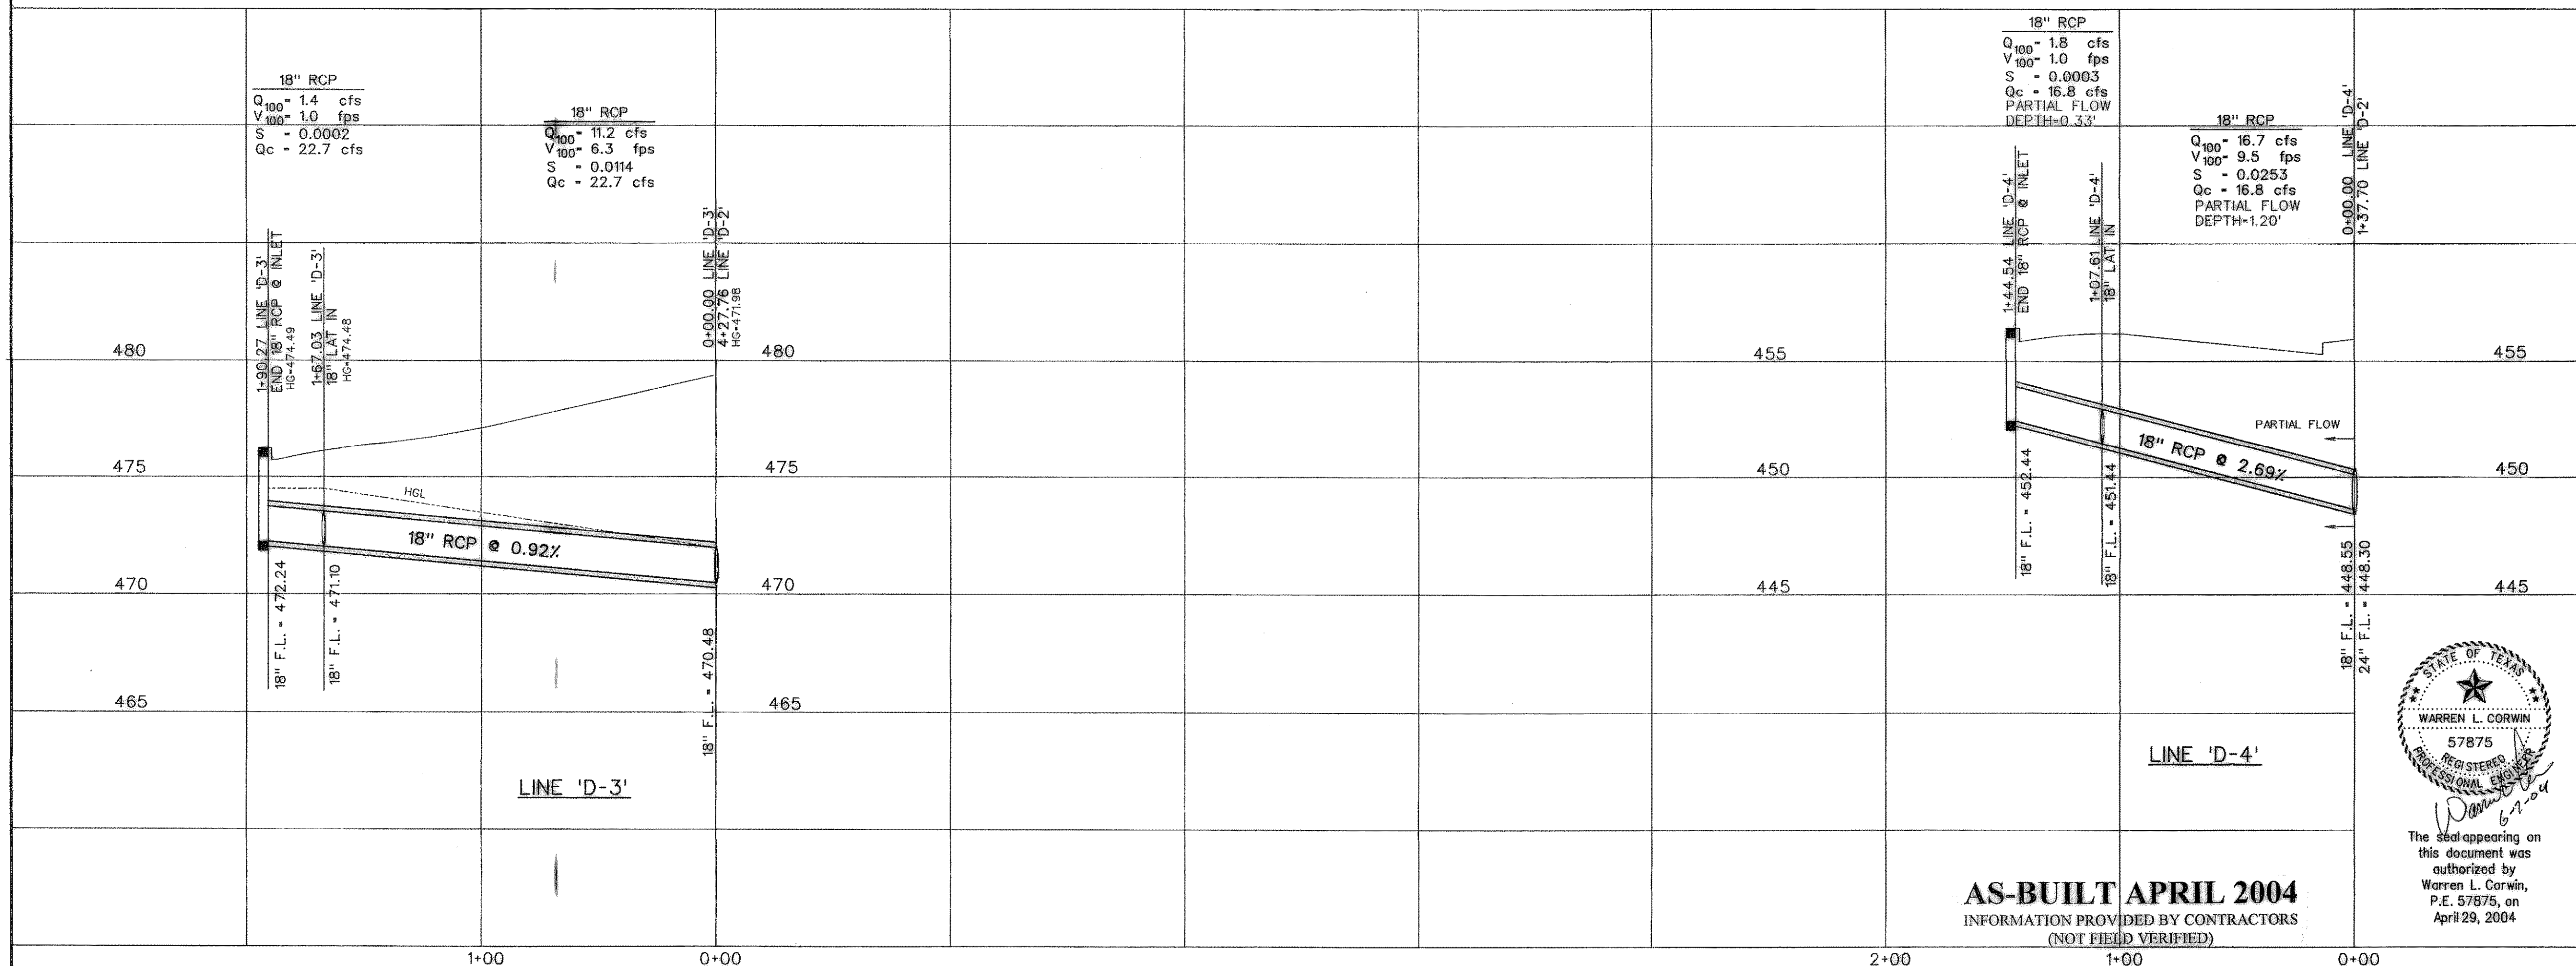

NO.	REVISIONS	BY	DATE

CORWIN ENGINEERING, INC.
 200 W. BELMONT SUITE E
 ALLEN, TEXAS 75013 (972) 396-1200

DEVELOPMENT PLANS FOR
LAKESIDE VILLAGE
 PHASE V-C
 ROCKWALL, TEXAS

STORM SEWER PLAN AND PROFILE
 LINES 'D-3' & 'D-4'

DRAWN BY RDS	DESIGNED BY CEI	CHECKED BY CEI	SHEET NO. 10 OF 13
JOB NUMBER 0209	DATE MARCH 2003	SCALE: 1"=4' V 1"=40' H	

AS-BUILT APRIL 2004
 INFORMATION PROVIDED BY CONTRACTORS
 (NOT FIELD VERIFIED)

STATE OF TEXAS
 WARREN L. CORWIN
 57875
 REGISTERED PROFESSIONAL ENGINEER
 APRIL 29, 2004
 The seal appearing on this document was authorized by Warren L. Corwin, P.E. 57875, on April 29, 2004