


DEVELOPMENT PLANS
FOR
LAKESIDE VILLAGE
PHASE V-C
CITY OF ROCKWALL, TEXAS

INDEX


1	TITLE
2	PLAT
3	DRAINAGE AREA MAP
4	HURON DRIVE
5	PONTCHARTRAIN DRIVE
6	WATER AND SANITARY SEWER PLAN
7	SANITARY SEWER PROFILES
8	STORM SEWER PLAN & PROFILE LINE 'D-1'
9	STORM SEWER PLAN & PROFILE LINE 'D-2'
10	STORM SEWER PLAN & PROFILE LINE 'D-3' & 'D-4'
11	GRADING PLAN
12	POLLUTION PREVENTION PLAN
13	RETAINING WALL PLAN

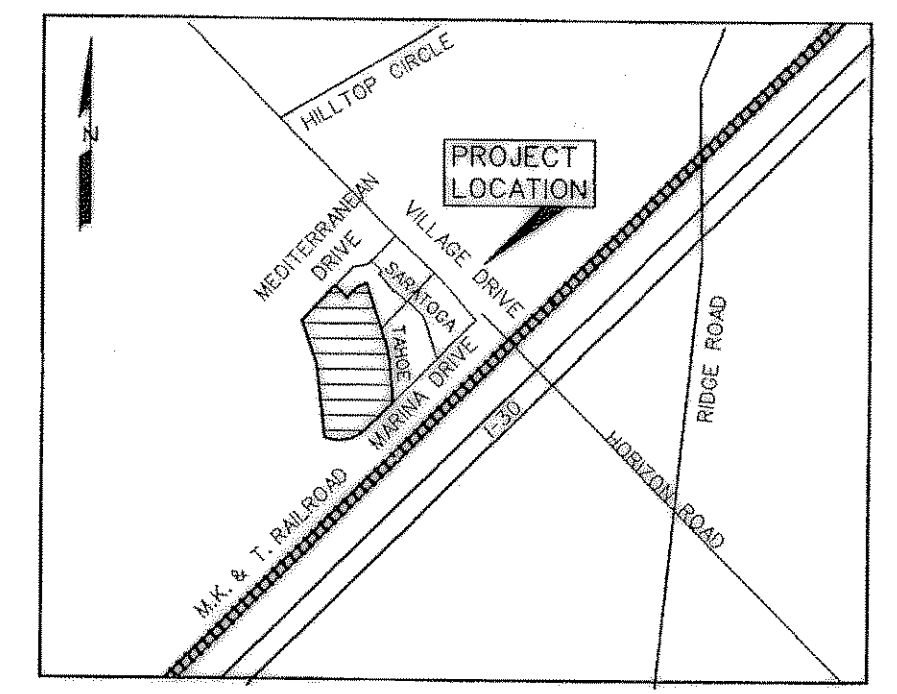

VICINITY MAP
NOT TO SCALE

PREPARED FOR
THE LAKESIDE VILLAGE V, LP
318A DALLAS DRIVE, DENTON, TEXAS 76205

CORWIN ENGINEERING, INC. — **CONSULTING ENGINEERS**
200 W. BELMONT, SUITE E ALLEN, TEXAS 75013

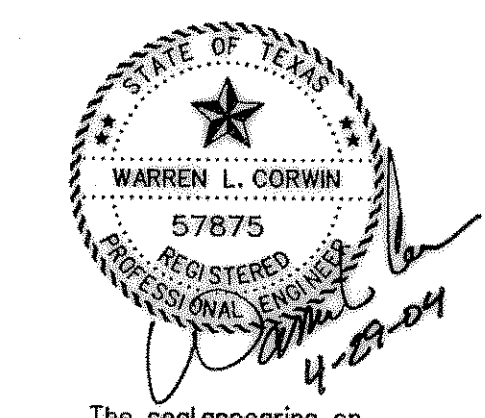

The seal appearing on this document was authorized by Warren L. Corwin, P.E. 57875, on April 29, 2004

AS-BUILT APRIL 2004
INFORMATION PROVIDED BY CONTRACTORS
(NOT FIELD VERIFIED)