


NOTE:
 ACTUAL NUMBER, LOCATION AND SIZE OF RETAINING WALLS TO BE DESIGNED AND SUBMITTED FOR CITY APPROVAL BY OTHERS, PRIOR TO UTILITY CONSTRUCTION.


NOTE:
 RETAINING WALL - - - - -
 T- TOP OF WALL
 B- BOTTOM OF WALL

BENCHMARKS:
 "□" found on the top of curb of the northwest corner of railroad bridge at Village Drive.
 ELEVATION = 506.23

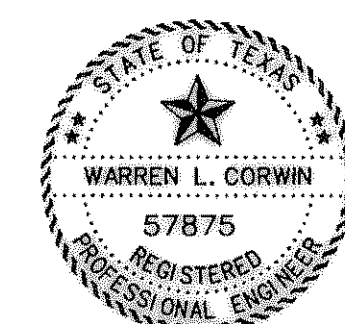

The seal appearing on this document was authorized by Warren L. Corwin, P.E. 57875, on April 29, 2004

AS-BUILT APRIL 2004
 INFORMATION PROVIDED BY CONTRACTORS
 (NOT FIELD VERIFIED)

 CORWIN ENGINEERING, INC. 200 W. BELMONT, SUITE E ALLEN, TEXAS 75013 (972) 396-1200			
DEVELOPMENT PLANS FOR LAKESIDE VILLAGE PHASE V-C ROCKWALL, TEXAS			
RETAINING WALL PLAN			
DRAWN BY	DESIGNED BY	CHECKED BY	SHEET NO.
	WLC	WLC	
JOB NUMBER	DATE	SCALE:	
0209	MARCH 2003	1"=40'	13 OF 13