


CITY OF ROCKWALL , TEXAS

WATER AND SEWER SYSTEM IMPROVEMENTS

PART I LAKESIDE VILLAGE WATER LINE EXTENSION
PART II LAKESIDE VILLAGE OUTFALL AND LIFT STATION

1971

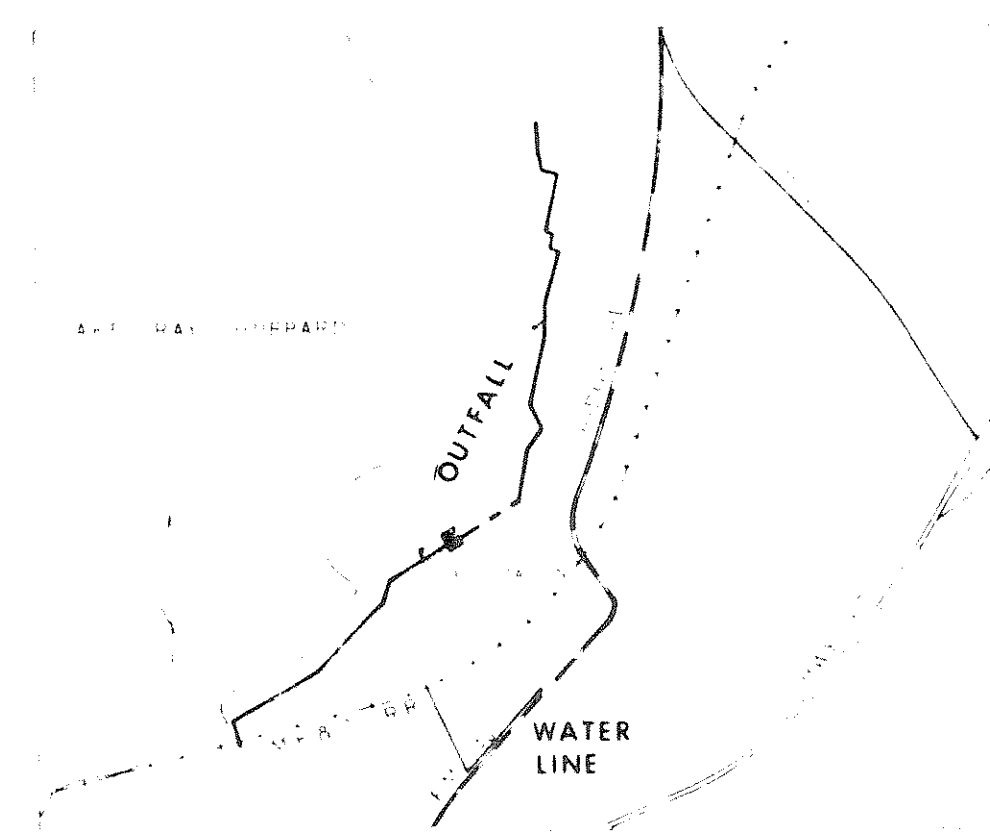

MAYOR

R. C. BLACKETER

ALDERMEN

HARRY MYERS DON E. WADDLE

WAYNE ROGERS GORDON EDWARDS

TED CAIN

FREESE , NICHOLS & ENDRESS
CONSULTING ENGINEERS

REVISIONS
AUG. 1972