



TREE LEGEND

- MAPLE
- HACKBERRY
- BOIS D'ARC
- CEDAR
- LOCUST
- MESQUITE
- COTTONWOOD
- WILLOW
- ELM
- PECAN
- ASH

GRAPHIC SCALE

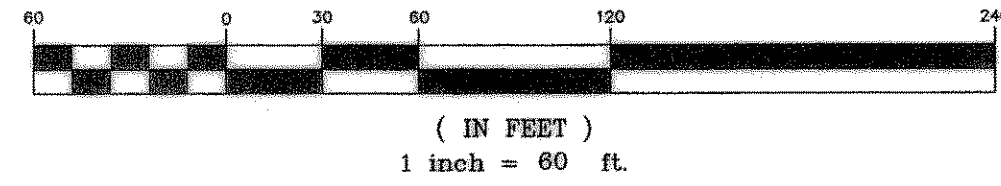

RECORD DRAWINGS:
 THE INTENT OF THE OWNER AND ENGINEER WAS TO CONSTRUCT THESE FACILITIES ACCORDING TO THESE PLANS AS APPROVED BY THE CITY OF ROCKWALL. THE LINES AND GRADES WERE SET ON THE GROUND FOR CONSTRUCTION ACCORDING TO SAID PLANS. THE CITY OF ROCKWALL INSPECTED THE CONSTRUCTION. THE OWNER NOR ENGINEER DID NOT VERIFY LINES OR GRADES AFTER CONSTRUCTION. WE ARE NOT AWARE OF ANY CHANGES OR REVISIONS TO THESE PLANS DURING CONSTRUCTION EXCEPT AS NOTED.

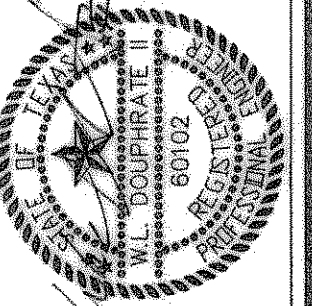

THE SEAL APPEARING ON THIS DOCUMENT WAS AUTHORIZED BY W.L. DOUPHRATE, TEXAS P.E. NO. 80102 ON 4/1/06

DOUPHRATE & ASSOCIATES, INC.
 ENGINEERING • PROJECT MANAGEMENT • SURVEYING
 2231 RIDGE RD., # 200 ROCKWALL, TEXAS 75087
 PHONE: (972)771-9004 FAX: (972)771-9005

TREE PLAN & PREL. GRADING
LAKEVIEW SUMMIT
CITY OF ROCKWALL
 ROCKWALL COUNTY, TEXAS

REVISION	
W.L.D. CHECKED	
K.E.B. DRAWN	
DATE	1/28/00
PROJECT	9919TREES3
	9 OF 42