



**TREE LEGEND**

- MAPLE
- HACKBERRY
- BOIS D'ARC
- CEDAR
- LOCUST
- MESQUITE
- COTTONWOOD
- WILLOW
- ELM
- PECAN
- ASH

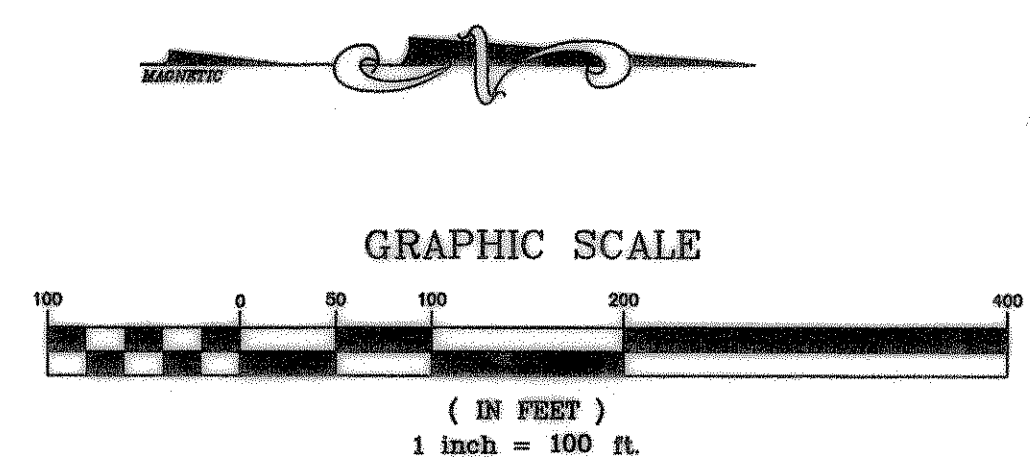

**RECORD DRAWINGS:**

THE INTENT OF THE OWNER AND ENGINEER WAS TO CONSTRUCT THESE FACILITIES ACCORDING TO THESE PLANS AS APPROVED BY THE CITY OF Rockwall. THE LINES AND GRADES WERE SET ON THE GROUND FOR CONSTRUCTION ACCORDING TO SAID PLANS. THE CITY OF Rockwall INSPECTED THE CONSTRUCTION. THE OWNER NOR ENGINEER DID NOT VERIFY LINES OR GRADES AFTER CONSTRUCTION. WE ARE NOT AWARE OF ANY CHANGES OR REVISIONS TO THESE PLANS DURING CONSTRUCTION EXCEPT AS NOTED

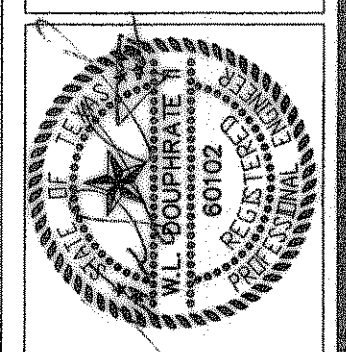

THE SEAL APPEARING ON THIS DOCUMENT WAS AUTHORIZED BY W.L. DOUPHRATE, LICENSE NO. 60102 ON 4/7/00

**DOUPHRATE & ASSOCIATES, INC.**  
 ENGINEERING • PROJECT MANAGEMENT • SURVEYING  
 2231 RIDGE RD., # 200 ROCKWALL, TEXAS 75087  
 PHONE: (972)771-8004 FAX: (972)771-8005

**TREE PLAN  
 LAKEVIEW SUMMIT, PHASE ONE  
 CITY OF ROCKWALL  
 ROCKWALL COUNTY, TEXAS**

REVISION	
CHECKED	W.L.D.
DRAWN	K.E.B.
DATE	1/29/00
PROJECT	9919TREP1H