

STA: 8+07.39
END & C.O.
1 PIPE JOINT
PAST PHASE LINE

STA: 0+00.00 LINE D=
STA: 10+45.47 LINE C
INSTALL:
4' DIA. MH

STA: 0+00.00 LINE D-1=
STA: 14+32.22 LINE B
INSTALL:
4' DIA. MH

STA: 12+32.62
END & C.O.
1 PIPE JOINT
PAST PHASE LINE

STA: 14+66.31
INSTALL:
1-4' M.H.
1 PIPE JOINT
PAST PHASE LINE

STA: 4+09.99
INSTALL:
1-4' M.H.

STA: 2+71.22 LINE H=
STA: 0+00.00 LINE I
INSTALL:
4' DIA. MH

STA: 4+75
INSTALL:
1 CLEANOUT
1 PIPE JOINT
PAST PHASE LINE

STA: 3+60.00
INSTALL:
4' M.H.

STA: 2+91.65
INSTALL:
4' M.H.

STA: 2+17.61
INSTALL:
4' DIA. MH

STA: 4+13.31 LINE A=
STA: 14+06.31 LINE C
INSTALL:
4' DIA. MH

STA: 1+43.94
INSTALL:
4' DIA. MH

STA: 0+68.40
CONNECT TO
EX. 4' DIA. MH

STA: 0+00.00
INSTALL:
8" C.O.

STA: 12+62.08 LINE A=
STA: 18+54.71 LINE B
INSTALL:
4' DIA. MH

STA: 8+50.00
INSTALL:
4' DIA. MH

STA: 14+10
INSTALL:
8" C.O.

STA: 4+39.74 LINE F=
STA: 0+00.00 LINE H
INSTALL:
4' DIA. MH

STA: 0+00.00 LINE F=
STA: 19+36.49 LINE G
INSTALL:
4' DIA. MH

STA: 5+36.76
INSTALL:
6' DIA. MH
CONN. TO EXIST.
36" SS MAIN

STA: 2+48.19
INSTALL:
8" C.O.


STA: 0+00.00
INSTALL:
8" C.O.

STA: 0+00.00 LINE K=
STA: 1+36.31 LINE J
INSTALL:
4' DIA. MH

STA: 2+04.46
INSTALL:
1 CLEANOUT
1 PIPE JOINT
PAST PHASE LINE

NOTE:
LINE'S K & J
NOT TO BE ACTIVE
UNTIL PHASE II


STA: 4+64.88
INSTALL:
4' DIA. MH
CONN. TO EXIST.
18" SS

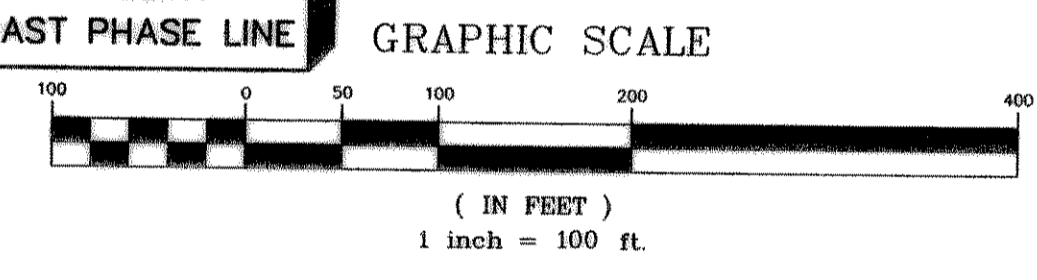

LINE	LENGTH	BEARING
L1	75.54'	S25°33'03"W
L2	72.41'	N77°45'33"W
L3	73.67'	N64°26'57"W
L4	22.13'	N29°48'48"E
L5	45.20'	S88°30'17"E
L6	80.24'	S73°54'26"E
L7	54.20'	N24°59'43"W
L8	37.90'	S66°35'54"W
L9	44.99'	N28°33'43"E
L10	72.32'	N89°00'06"E
L11	57.01'	S00°59'54"E
L12	94.72'	N18°44'32"E

CURVE	LENGTH	RADIUS	TANGENT	CH BRG	CH DIST	DELTA
C1	40.19	255.00	20.14	S64°38'22"E	40.15	09°01'52"
C2	194.92	370.00	99.78	N14°43'18"E	192.67	30°11'00"
C3	68.79	270.00	34.58	S81°12'22"E	68.60	14°35'51"
C4	69.00	230.00	34.76	N82°30'06"W	68.74	17°11'19"
C5	102.20	245.00	51.85	N130°24'44"W	101.46	23°53'58"
C6	105.30	245.00	53.48	S77°19'02"W	104.49	24°37'31"
C7	36.26	205.00	18.18	N70°04'19"E	36.21	10°08'05"
C8	44.81	205.00	22.50	S83°15'16"W	44.72	12°31'27"
C9	46.26	255.00	23.19	S71°47'43"W	46.20	10°23'39"
C10	103.92	205.00	53.10	S14°02'22"W	102.81	29°02'43"
C11	105.27	205.00	53.82	S76°17'14"E	104.12	29°25'19"
C12	96.47	280.00	48.72	S08°52'19"W	95.99	19°44'25"
C13	93.45	230.00	47.38	S82°53'50"E	92.80	23°16'43"
C14	189.77	270.00	99.00	N63°19'07"E	185.89	40°16'15"
C15	133.34	230.00	66.60	S59°47'30"W	131.48	33°13'01"

REVISED TO CONFORM TO CONSTRUCTION RECORDS.
DATE: 11-05-2007

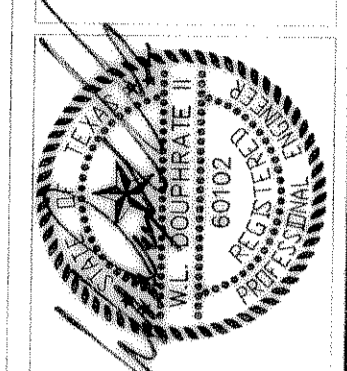

THE SEAL APPEARING ON THIS PLAN IS THE PROPERTY OF W.L.D. & ASSOCIATES, INC. NO. 60102 ON 11/15/02

DOUPHRADE & ASSOCIATES, INC.
ENGINEERING - PROJECT MANAGEMENT - SURVEYING
2231 RIDGE RD., # 200 ROCKWALL, TEXAS 75087
PHONE: (972)771-9004 FAX: (972)771-9005

SANITARY SEWER PLAN
LAKEVIEW SUMMIT, PHASE ONE
CITY OF ROCKWALL
ROCKWALL COUNTY, TEXAS

revised ss-e alignment
REVISION
W.L.D.
CHECKED
K.E.B.
DRAWN
5/23/00
DATE
9919 SS
PROJECT