



HIGH POINT ELEV = 472.81
 HIGH POINT STA = 9+97.05
 PVI STA = 10+00
 PVI ELEV = 472.96
 A.D. = -1.74
 K = 40.25

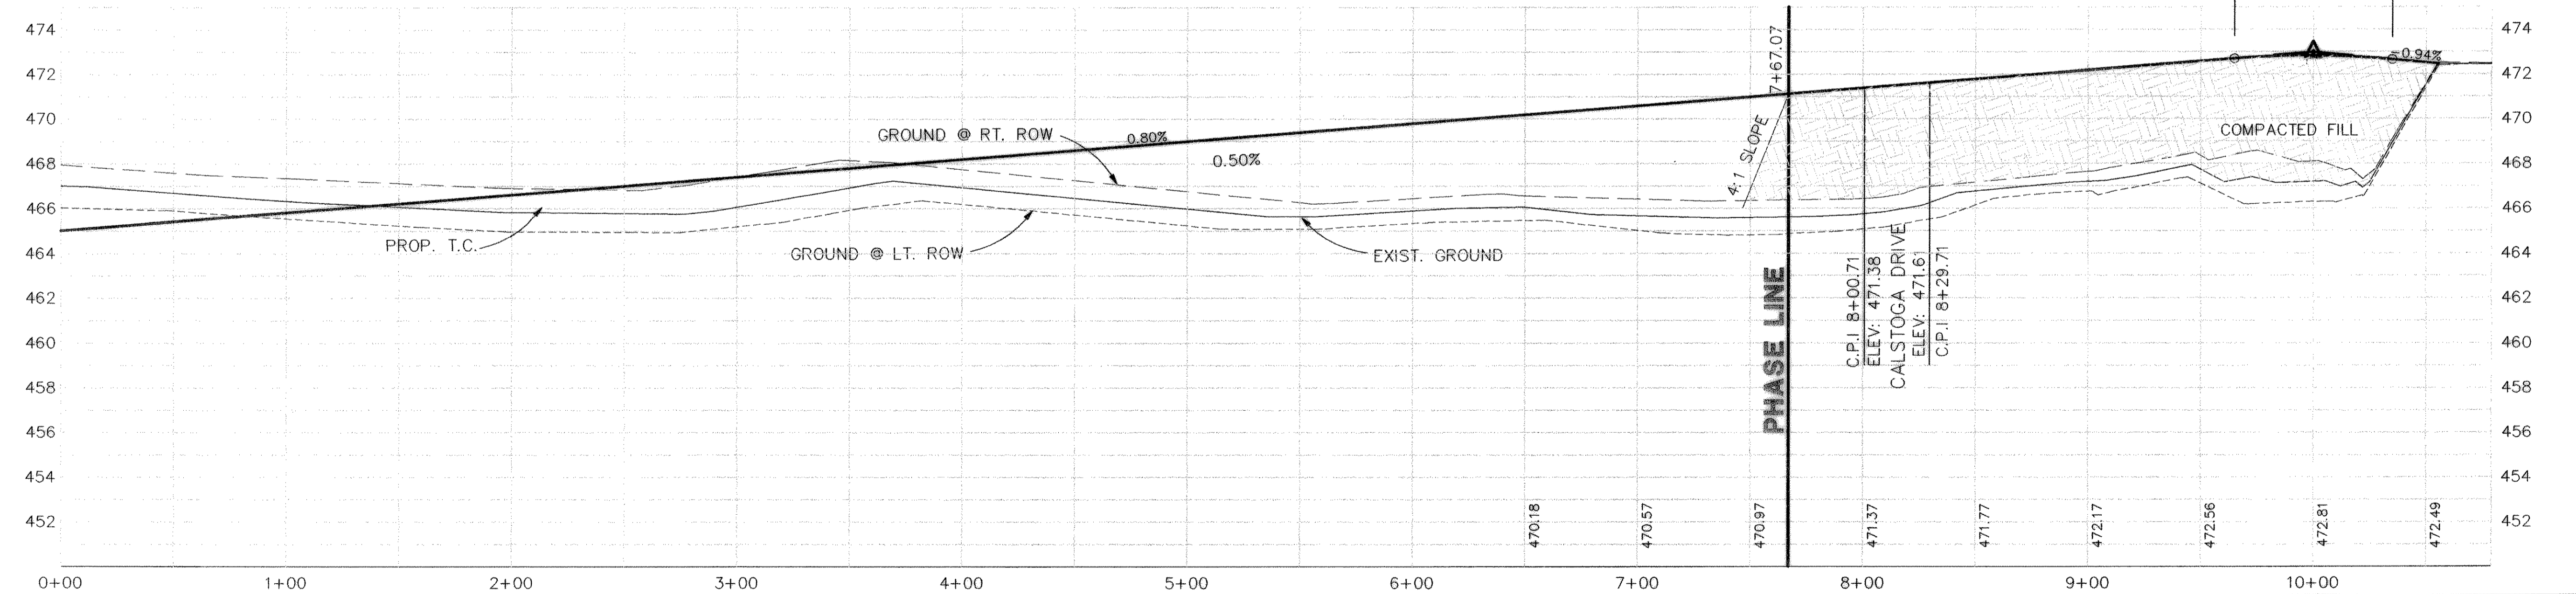

REVISED TO CONFORM TO CONSTRUCTION RECORDS.
W.L.D.
 DATE: 11-05-2002

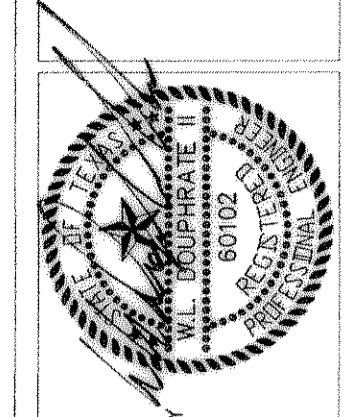

DOUPHRA
 & ASSOCIATES, INC.
 ENGINEERING - PROJECT MANAGEMENT - SURVEYING
 2231 RIDGE RD., # 200 ROCKWALL, TEXAS 75087
 PHONE: (972)771-9004 FAX: (972)771-9005

PAVING PLAN & PROFILE
 SONOMA DR. STA: 767.07 TO 10+79
 LAKEVIEW SUMMIT, PHASE ONE
 CITY OF ROCKWALL, ROCKWALL COUNTY, TEXAS

REVISION	
CHECKED	W.L.D.
DRAWN	K.E.B.
DATE	1/7/00
PROJECT	9919PV3
	13 OF 42