


STRIPING DETAIL

RECORD DRAWINGS:
 THE INTENT OF THE OWNER AND ENGINEER
 WAS TO CONSTRUCT THESE FACILITIES
 ACCORDING TO THESE PLANS AS APPROVED BY
 THE CITY OF Rockwall. THE LINES
 AND GRADES WERE SET ON THE GROUND FOR
 CONSTRUCTION ACCORDING TO SAID PLANS.
 THE CITY OF Rockwall INSPECTED
 THE CONSTRUCTION. THE OWNER NOR
 ENGINEER DID NOT VERIFY LINES OR GRADES
 AFTER CONSTRUCTION. WE ARE NOT AWARE
 OF ANY CHANGES OR REVISIONS TO THESE
 PLANS DURING CONSTRUCTION EXCEPT AS
 NOTED

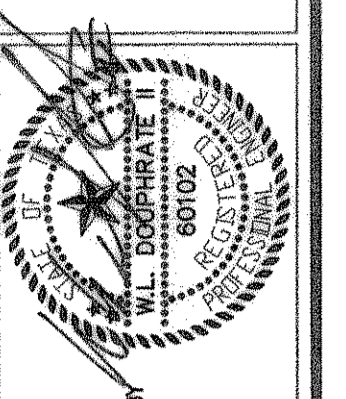

THE SEAL APPEARING ON THIS
 DOCUMENT WAS AUTHORIZED BY
 W.L. DOUPHRATE A TEXAS P.E.
 NO. 60102 ON 7/19/00

DOUPHRATE & ASSOCIATES, INC.
 ENGINEERING • PROJECT MANAGEMENT • SURVEYING
 2235 RIDGE RD., # 200 ROCKWALL, TEXAS 75087
 PHONE: (972)771-9004 FAX: (972)771-9005

PAVING PLAN & PROFILE
LOS ALTOS DR. STA: 0+00 TO 7+22.58
 LAKEVIEW SUMMIT, PHASE ONE
 CITY OF ROCKWALL, ROCKWALL COUNTY, TEXAS

1. REVISED AS PER CITY
 OF ROCKWALL REVISIONS
 7/6/00

| | |
|----------|-----------|
| REVISION | W.L.D. |
| CHECKED | K.E.B. |
| DRAWN | 1/10/00 |
| DATE | 9919 PVI0 |
| PROJECT | |