



- LEGEND:
- SILT FENCING
 - INLET PROTECTION
 - CONSTRUCTION ENTRANCE
 - CREEK PROTECTION

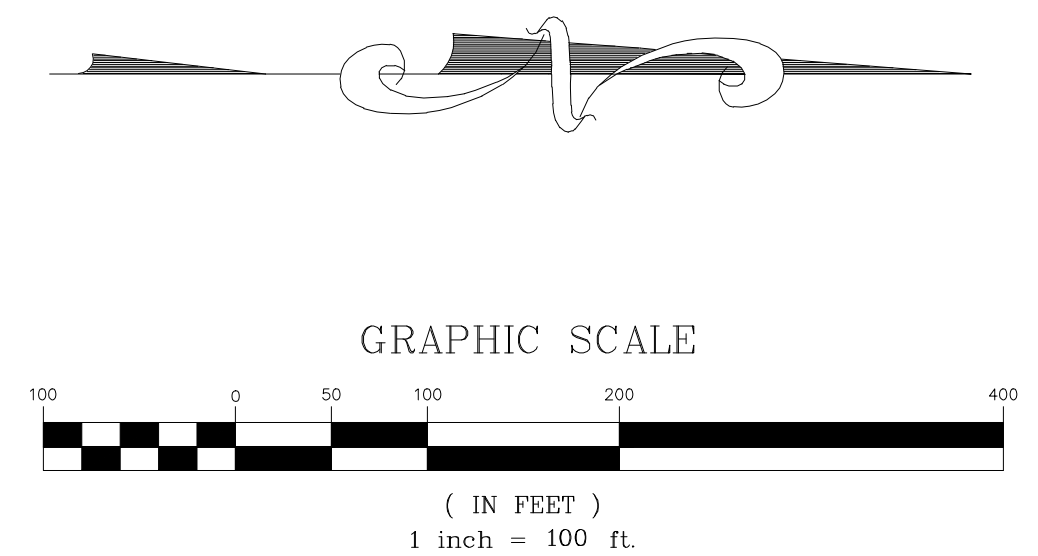

REVISED TO CONFORM TO CONSTRUCTION RECORDS.

W.L.D. DATE: 12-1-16

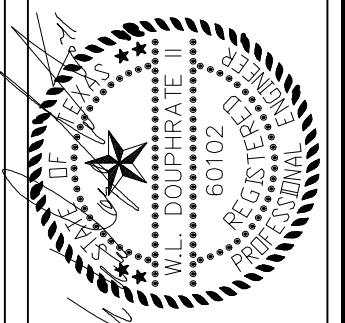

THE SEAL APPEARING ON THIS DOCUMENT WAS AUTHORIZED BY W.L. DOUPHRATE II, TEXAS P.E., NO. 60102, F-496, EXP. DATE: OCT. 3, 2014

DOUPHRATE & ASSOCIATES, INC.
 ENGINEERING • PROJECT MANAGEMENT • SURVEYING
 2235 RIDGE RD., # 200 ROCKWALL, TEXAS 75087
 PHONE: (972)771-9004 FAX: (972)771-9005

EROSION CONTROL PLAN
 LAKEVIEW SUMMIT, PHASE IV
 CITY OF ROCKWALL
 ROCKWALL COUNTY, TEXAS

REVISION
W.L.D. CHECKED
K.E.B. DRAWN
10/14 DATE
9919-4-ERO1 PROJECT
13.0 OF