


REVISED TO CONFORM TO CONSTRUCTION RECORDS.
[Signature] DATE: 12-1-16

BENCHMARKS:
BRASS CAP MONUMENT NO. 10 SET IN CONCRETE IN THE CENTER OF GRASS MEDIAN IN MASTERS DRIVE BETWEEN NORTH LAKESHORE & SHORES BLVD.
N 7032464.6317, E 2589554.1518
ELEV. = 524.62

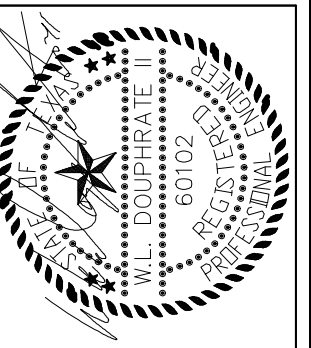

THE SEAL APPEARING ON THIS DOCUMENT WAS AUTHORIZED BY W.L. DOUPHRATE II TEXAS P.E. NO. 60102, F-886, ON 06/13/2014.

DOUPHRATE & ASSOCIATES, INC.
ENGINEERING • PROJECT MANAGEMENT • SURVEYING
22235 RIDGE RD., # 200 ROCKWALL, TEXAS 75087
PHONE: (972)771-9004 FAX: (972)771-9005

PAVING PLAN & PROFILE
BURLINGAME DRIVE
LAKEVIEW SUMMIT, PHASE 4
CITY OF ROCKWALL, ROCKWALL COUNTY, TEXAS

REVISION
SAH. CHECKED
DLB. DRAWN
10/14 DATE
9919-4PV12 PROJECT
8.11 OF