

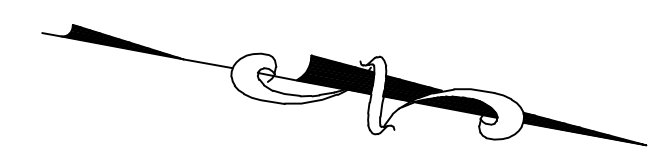
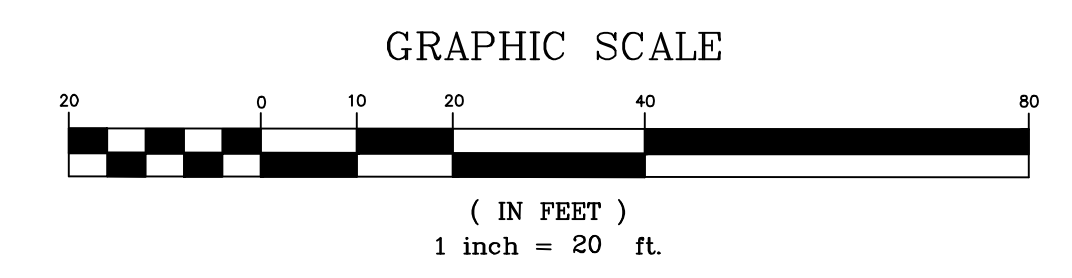


DOUPHRA
& ASSOCIATES, INC.
ENGINEERING • PROJECT MANAGEMENT • SURVEYING
2235 RIDGE RD., # 200 ROCKWALL, TEXAS 75087
PHONE: (972)771-9004 FAX: (972)771-9005

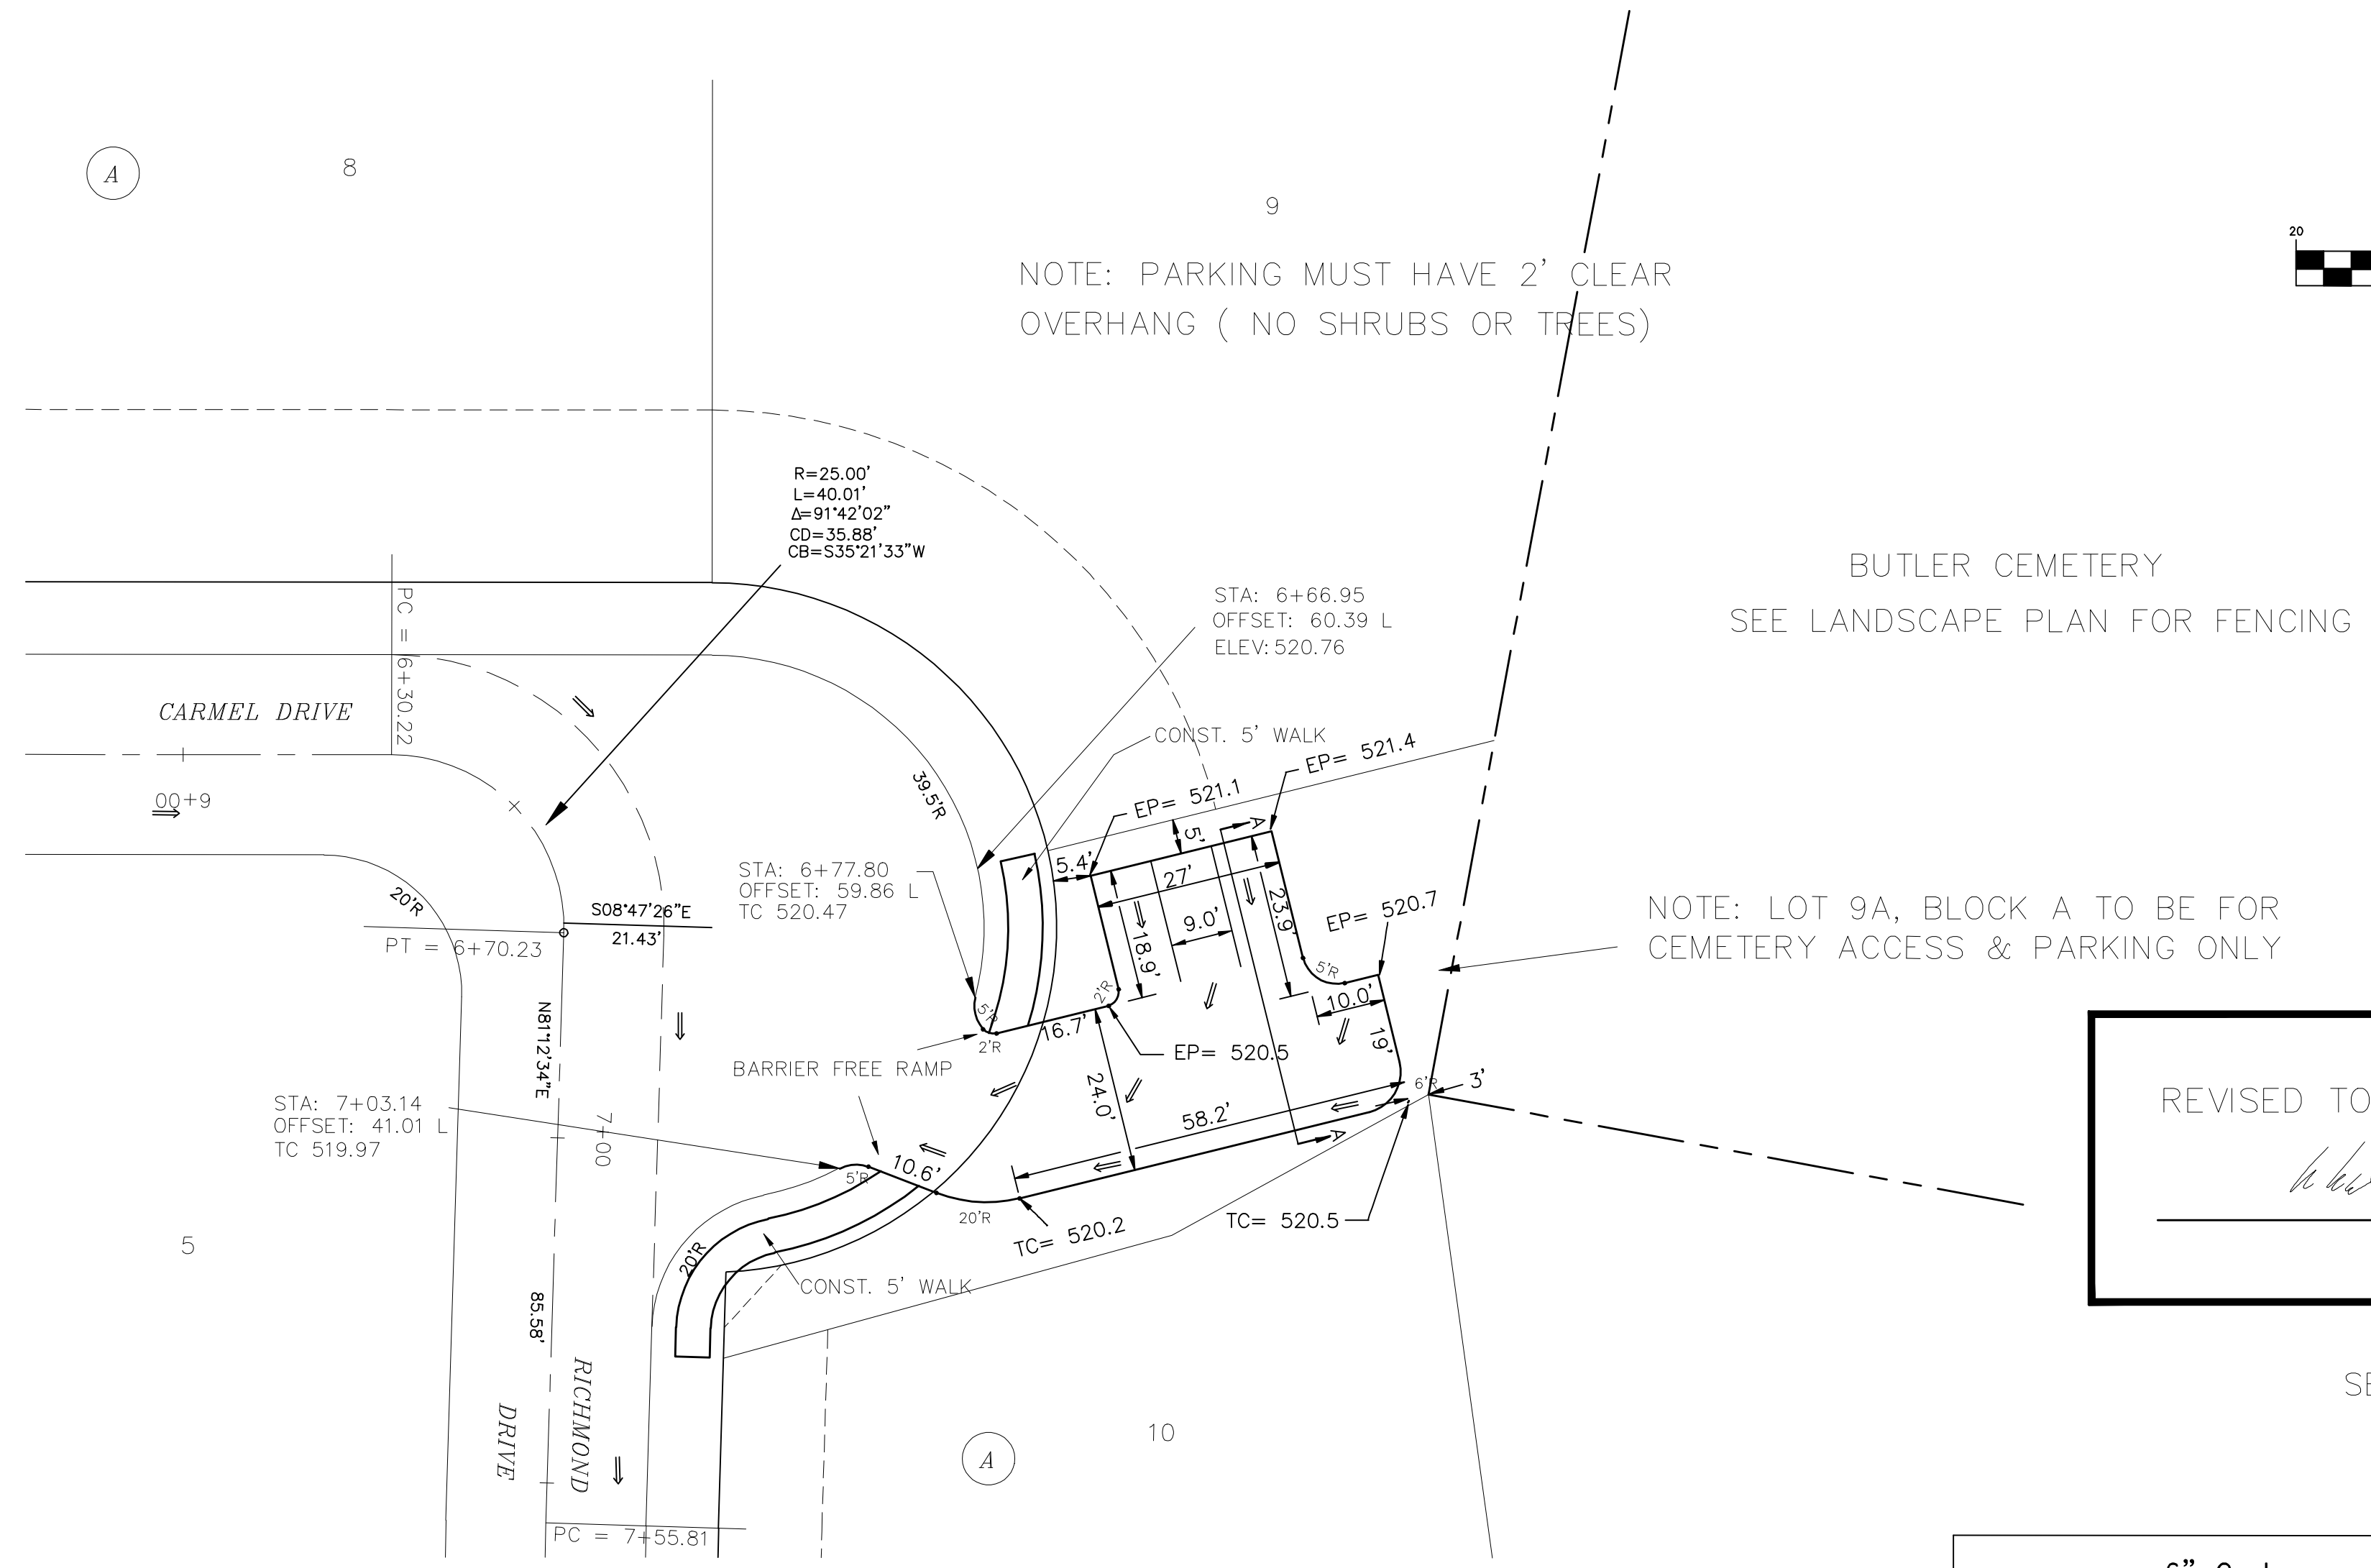

REVISED TO CONFORM TO CONSTRUCTION RECORDS.
W. Douphrate DATE: 12-1-16

SECTION A - A

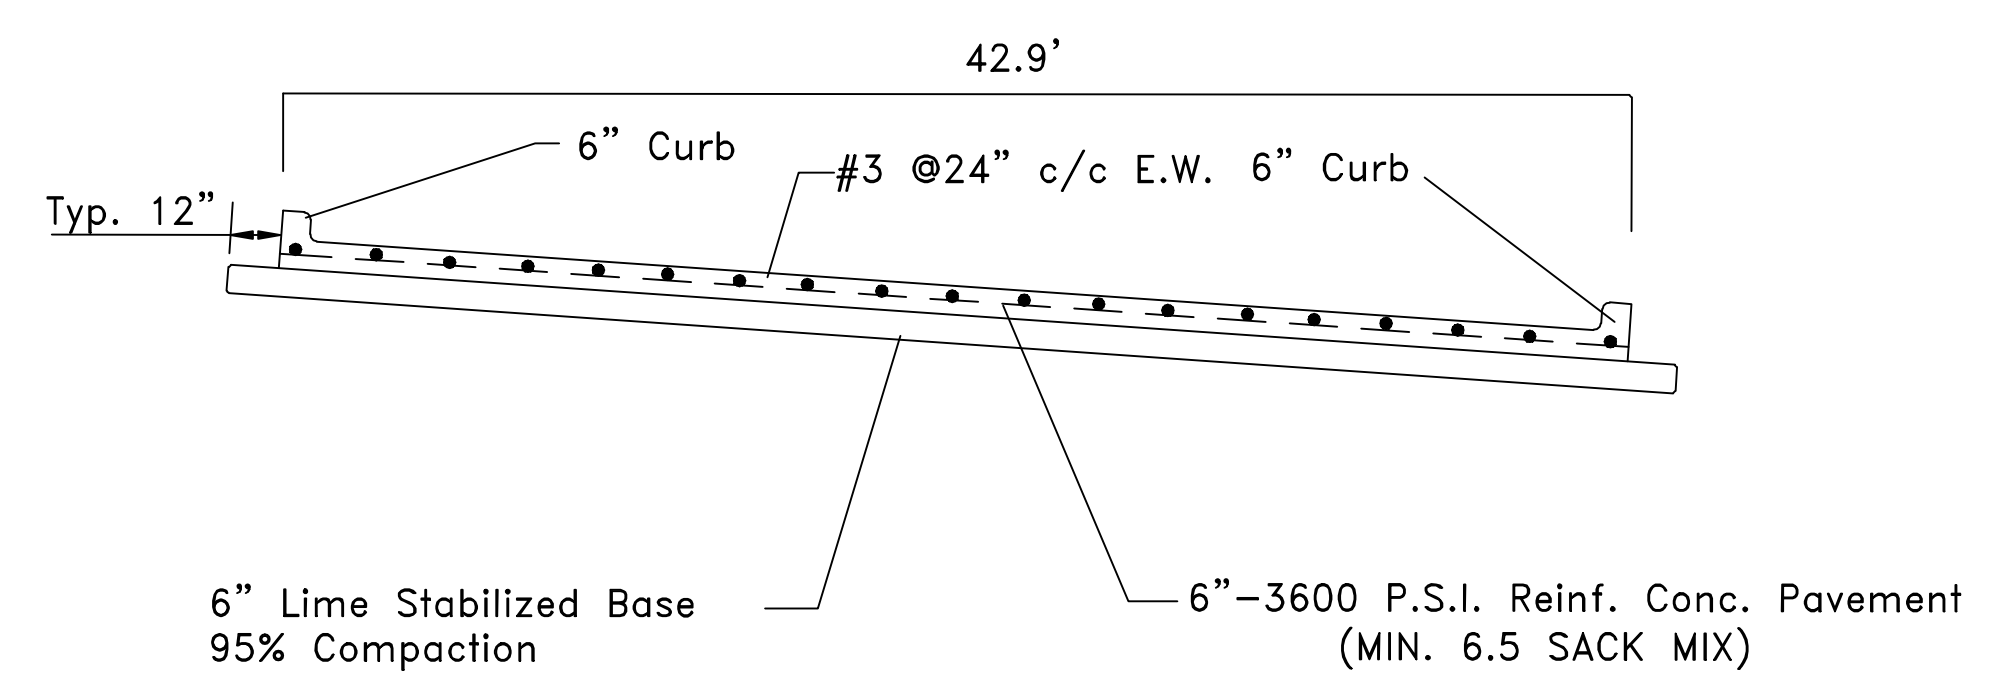

BENCHMARKS:
BRASS CAP MONUMENT NO. 10 SET IN CONCRETE IN THE CENTER OF GRASS MEDIAN IN MASTERS DRIVE BETWEEN NORTH LAKESHORE & SHORES BLVD.
N 7032464.6317, E 2589554.1518
ELEV. = 524.62

REVISION
W.L.D. CHECKED
K.E.B. DRAWN
10/14 DATE
9919-4 PV17 PROJECT
816 OF

PARKING PLAN
LAKEVIEW SUMMIT PH-4
CITY OF ROCKWALL
ROCKWALL COUNTY, TEXAS