


LEGEND


= BARRIER-FREE RAMP WITH TRUNCATED DOMES

REVISED TO CONFORM TO CONSTRUCTION RECORDS.

[Signature] DATE: 12-1-16

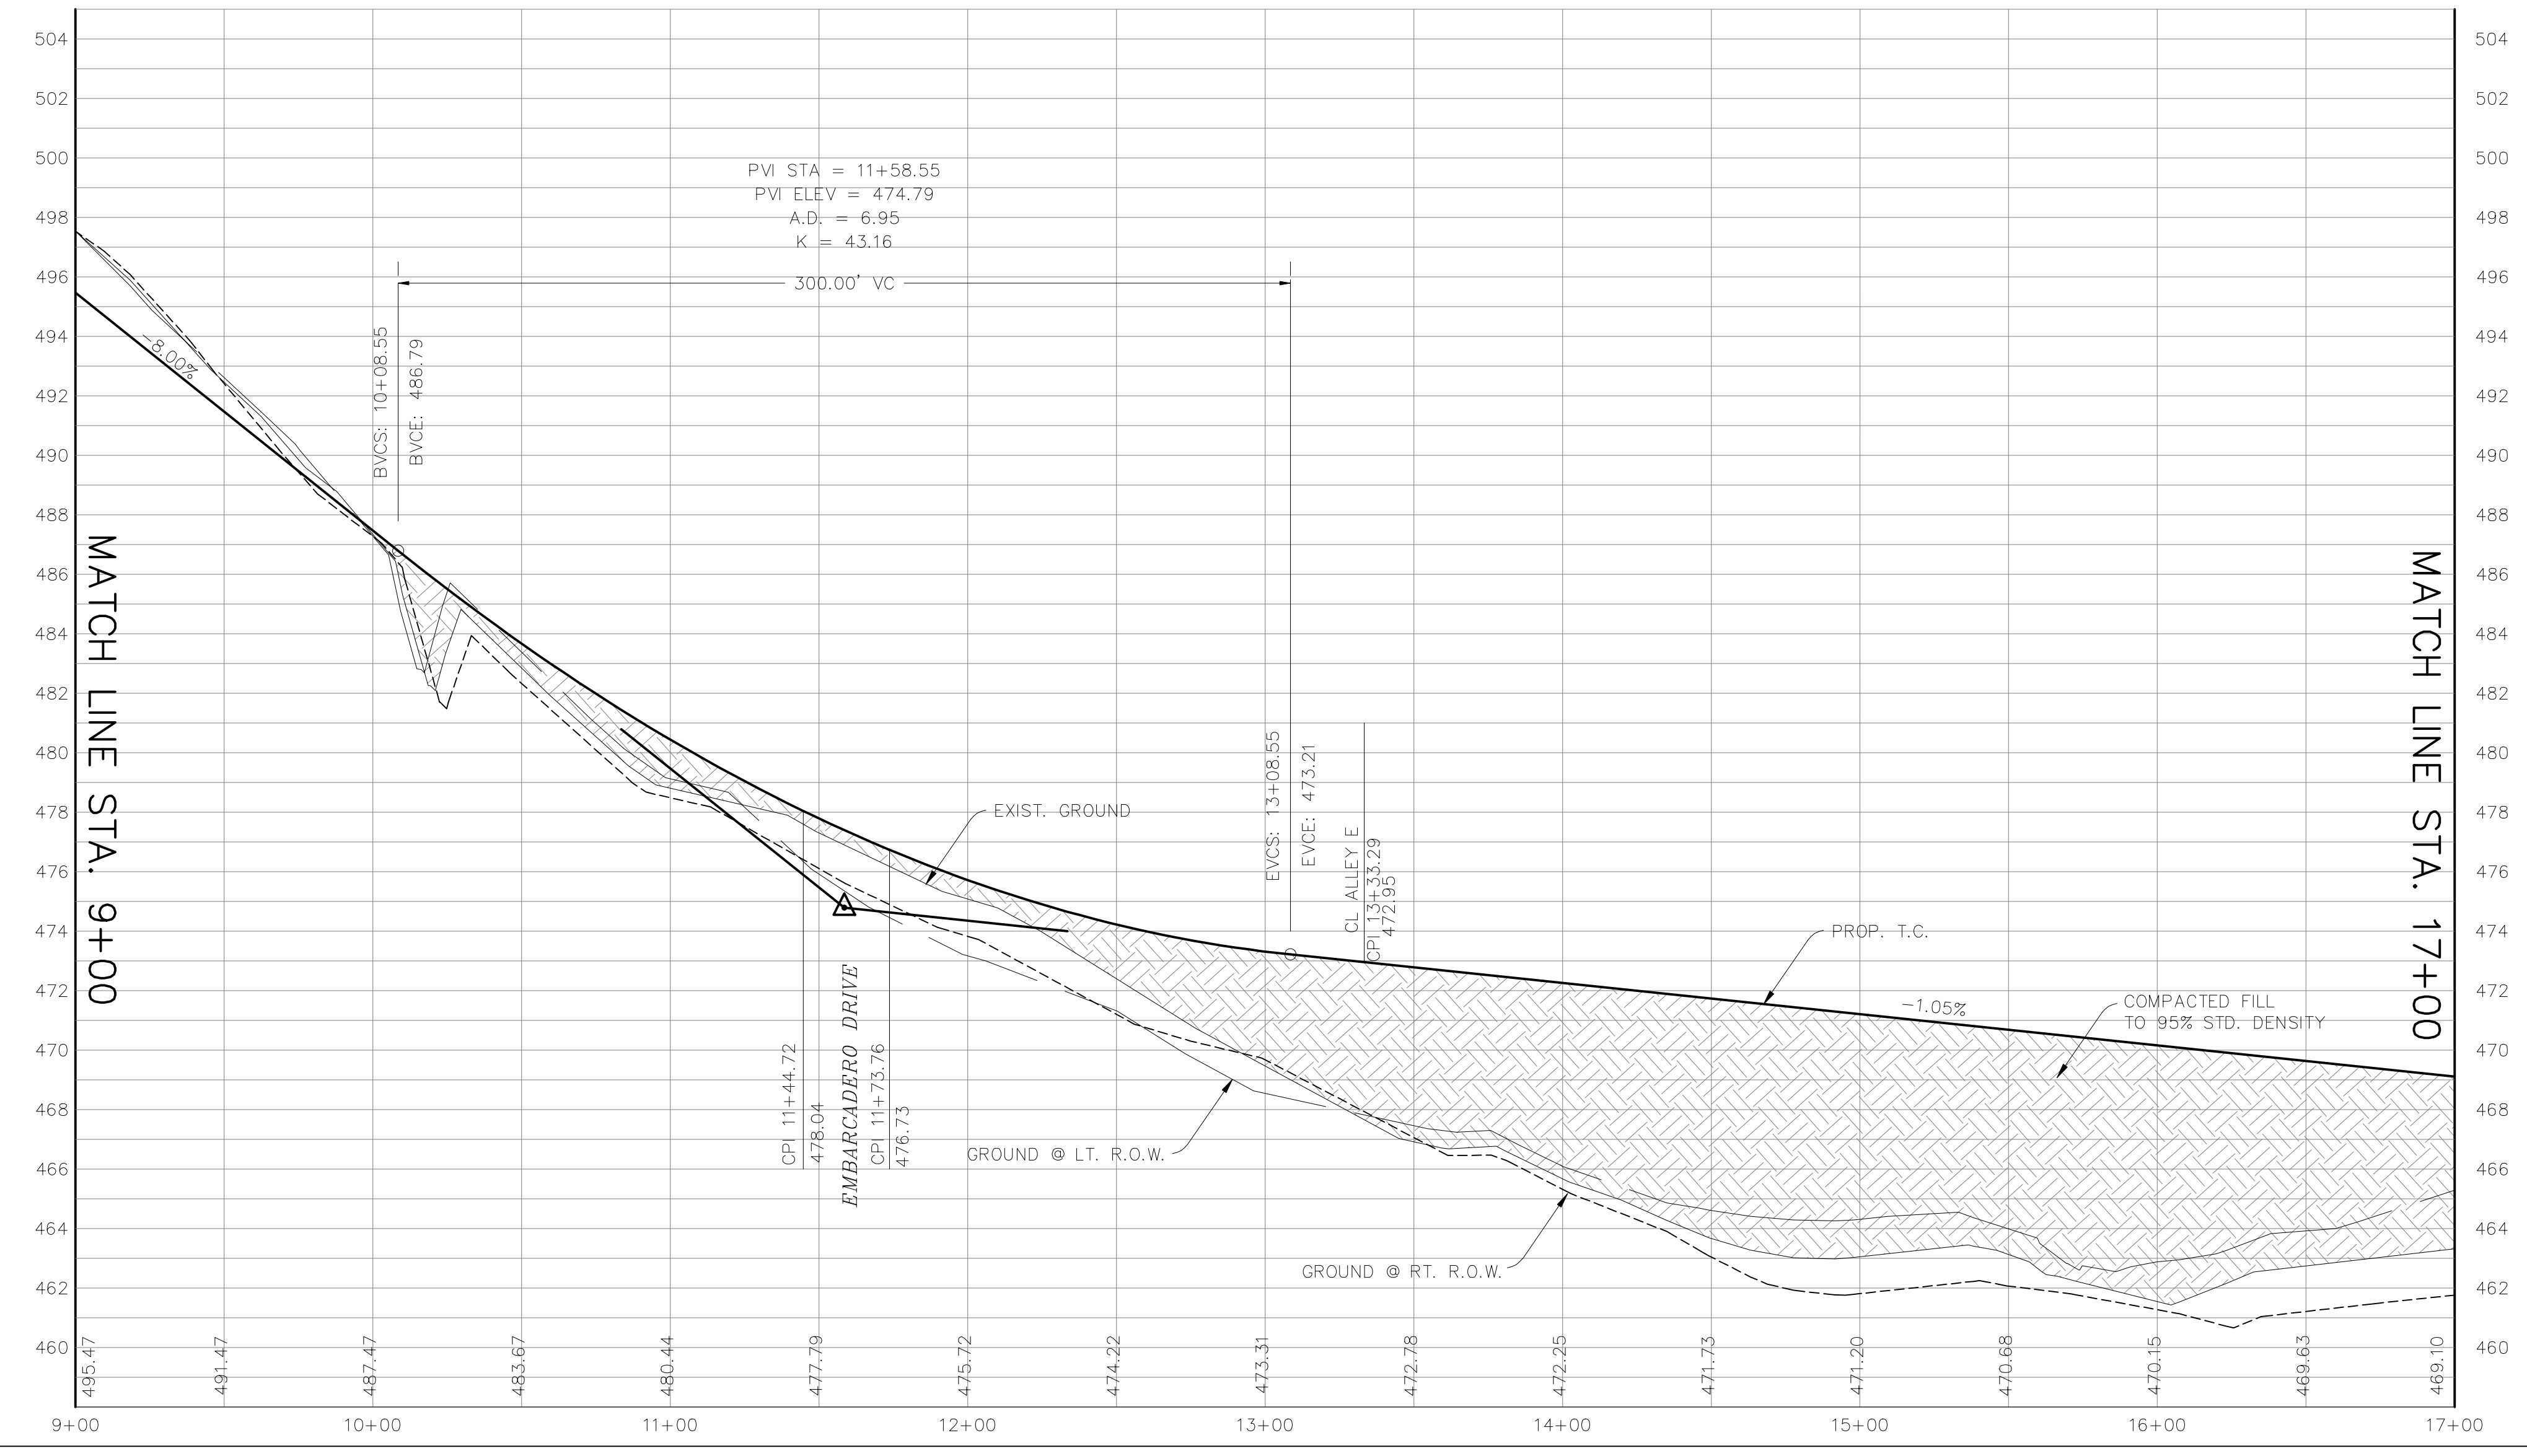

BENCHMARKS:
BRASS CAP MONUMENT NO. 10 SET IN CONCRETE IN THE CENTER OF GRASS MEDIAN IN MASTERS DRIVE BETWEEN NORTH LAKESHORE & SHORE'S BLVD.
N 7032464.6317, E 2589554.1518
ELEV. = 524.62

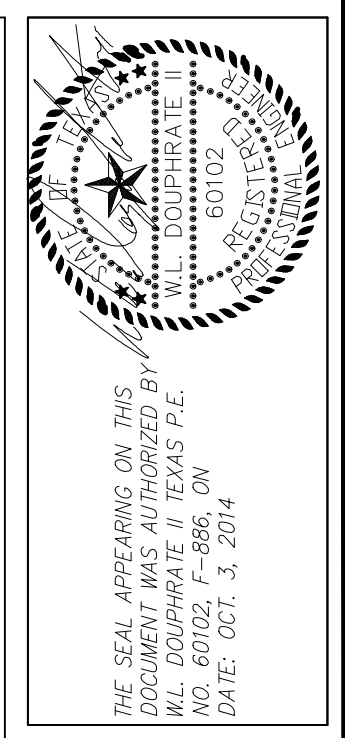

DOUPHRATE & ASSOCIATES, INC.
ENGINEERING + PROJECT MANAGEMENT + SURVEYING
2235 RIDGE RD., # 200 ROCKWALL, TEXAS 75087
PHONE: (972)771-9004 FAX: (972)771-9005

PAVING PLAN & PROFILE
PETALUMA DRIVE & LOMBARD DRIVE
LAKEVIEW SUMMIT, PHASE 4
CITY OF ROCKWALL, ROCKWALL COUNTY, TEXAS

REVISION
SAH CHECKED
DLB. DRAWN
10/14 DATE
9919-4PV3 PROJECT
82 OF