
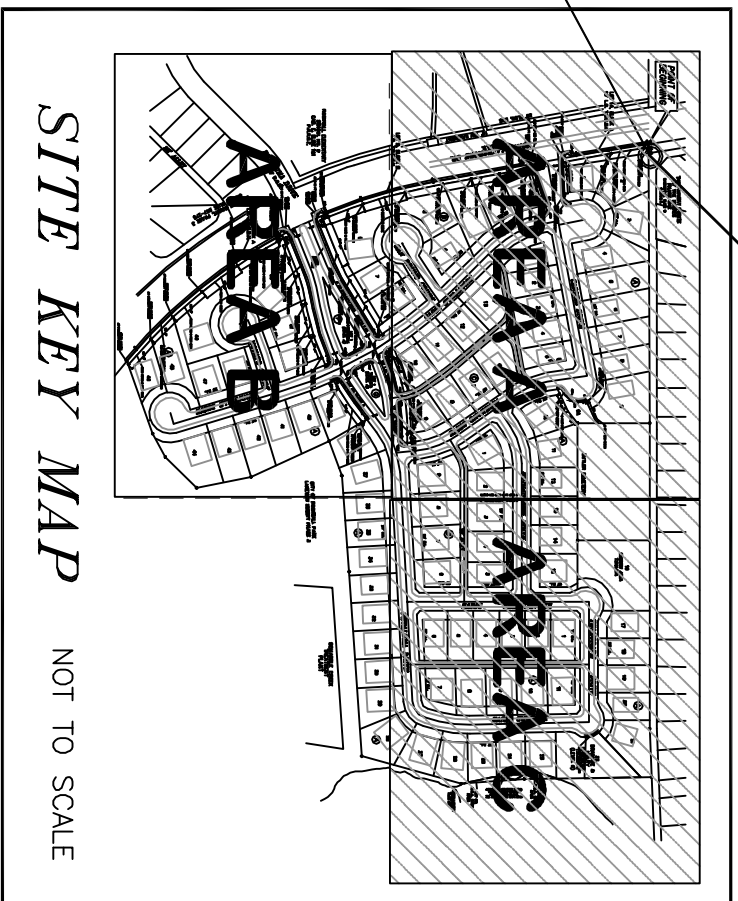


**SITE FENCE AND SIDEWALK LEGEND**

- WOOD FENCE 6 FOOT HIGH  
SEE DETAIL 1, SFP-4
- 6 FOOT IRON FENCE  
SEE DETAIL 2, SFP-4
- STONE COLUMN  
AT PROPERTY CORNERS  
SEE DETAIL 3, SFP-4
- 5 FOOT WIDE SIDEWALK  
PER CITY CODE  
SEE DETAIL 4, SFP-4
- IRRIGATION SLEEVE REQUIRED  
2" & 4" P.V.C. SCH 40 AT EACH LOCATION

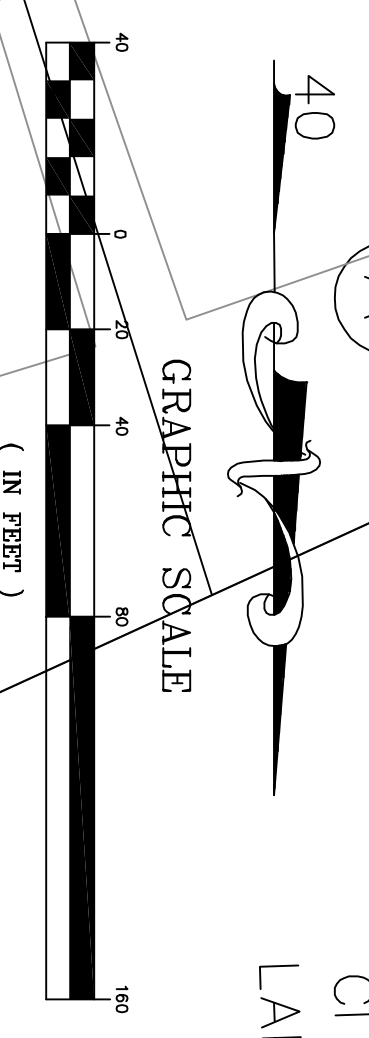

**LANDSCAPE PLANTING PLAN**  
**LAKEVIEW SUMMIT**  
**PHASE 4**  
 CITY OF ROCKWALL, ROCKWALL COUNTY, TEXAS

**DOUPHRADE & ASSOCIATES, INC.**  
 ENGINEERING • PROJECT MANAGEMENT • SURVEYING  
 2235 RIDGE RD., # 200 ROCKWALL, TEXAS 75087  
 PHONE: (972)771-9004 FAX: (972)771-9005

T.H. Pritchett & Associates  
 LANDSCAPE ARCHITECTS  
 1218 CAMINO LAGO  
 IRVING, TEXAS 75039  
 214-697-2580  
 tom@landdesignplan.com



REVISION	
CHECKED	T.H.P.
DRAWN	T.H.P.
DATE	01/06/2015
SITE FENCE AND SIDEWALK PLAN PROJECT	
<b>FSP-1</b> OF	