


T.H.Pritchett / Associates
 LANDSCAPE ARCHITECTS
 1218 CAMINO LAGO
 IRVING, TEXAS 75039
 214-697-2580
 tom@landdesignplan.com

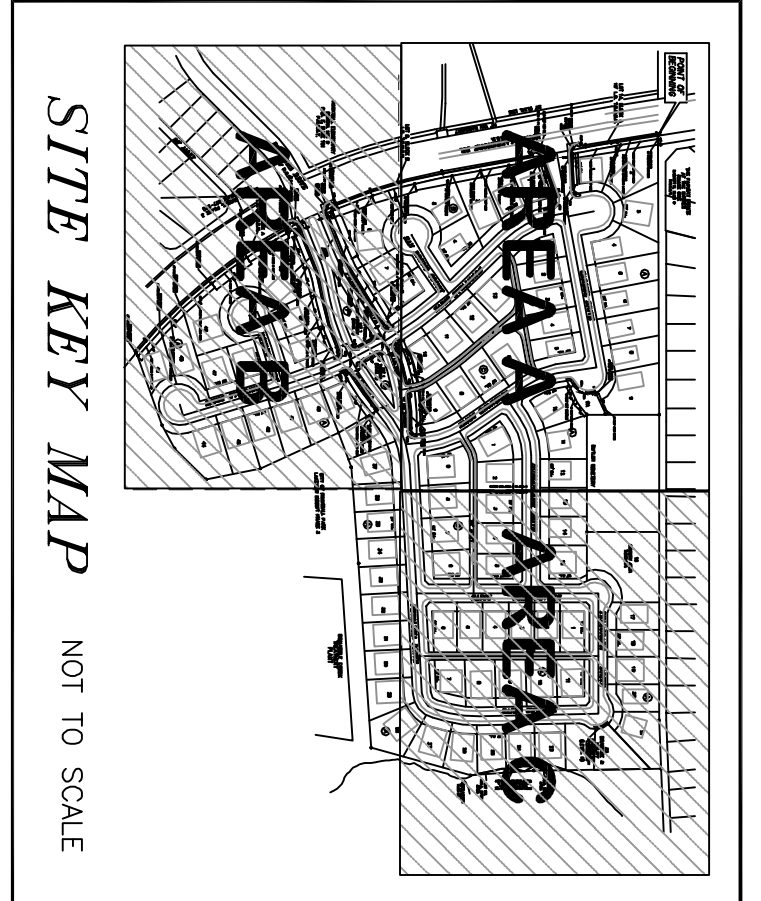

LANDSCAPE PLANTING PLAN
 LAKEVIEW SUMMIT
 PHASE 4
 CITY OF ROCKWALL, ROCKWALL COUNTY, TEXAS

DOUPHRADE & ASSOCIATES, INC.
 ENGINEERING • PROJECT MANAGEMENT • SURVEYING
 2235 RIDGE RD., # 200 ROCKWALL, TEXAS 75087
 PHONE: (972)771-9004 FAX: (972)771-9005

THE SEAL APPEARING ON THIS DOCUMENT WAS AUTHORIZED BY
 T. H. PRITCHETT, R.L.A.,
 NO. 2115 ON 07/06/2015

REVISION	
THP	
CHECKED	
DATE	01/06/2015
SITE FENCE AND SIDEWALK PLAN AREA A	
PROJECT	

FSP-2
 OF