
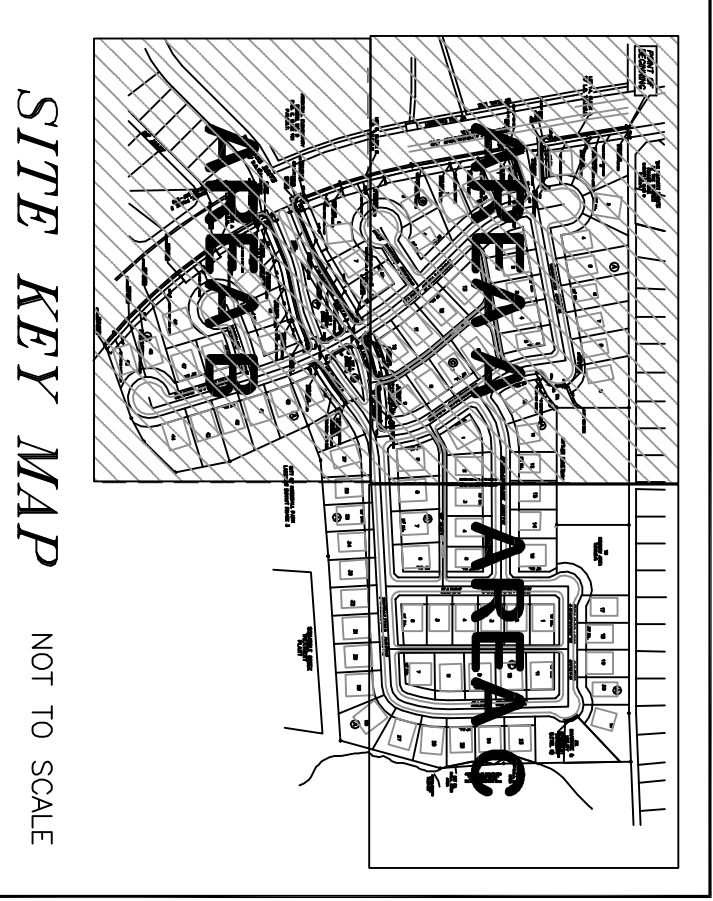


SITE FENCE AND SIDEWALK LEGEND

- WOOD FENCE 6 FOOT HIGH
SEE DETAIL 1, SFP-4
- 6 FOOT IRON FENCE
SEE DETAIL 2, SFP-4
- STONE COLUMN
AT PROPERTY CORNERS
SEE DETAIL 3, SFP-4
- 6 FOOT WIDE SIDEWALK
SEE DETAIL 4, SFP-4
- IRRIGATION SLEEVE REQUIRED
2" & 4" P.V.C. SCH 40 AT EACH LOCATION

T.H.Pritchett / Associates
 LANDSCAPE ARCHITECTS
 1218 CAMINO LAGO
 IRVING, TEXAS 75039
 214-697-2580
 tom@landdesignplan.com

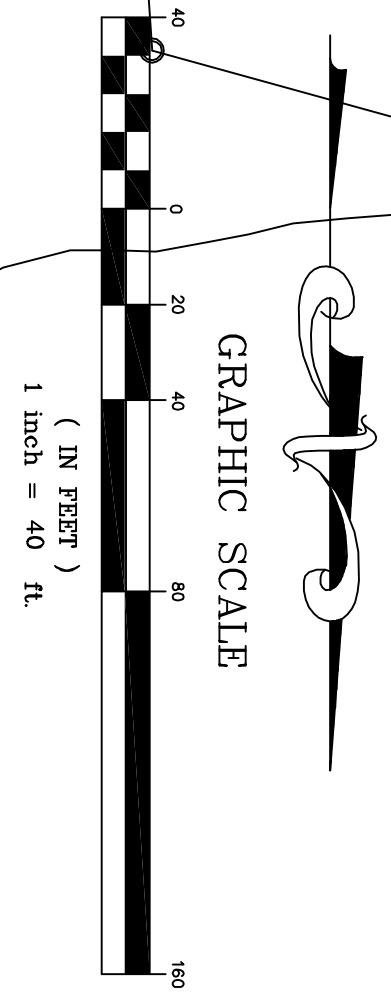


LOT 55, H.O.A. OPEN AREA
 PARK LAND DEDICATION TO THE LAKEVIEW SUMMIT PHASE 4
 CITY OF ROCKWALL WITH CAB. F. SLIDE 267-270. DRCT

LOT 56, H.O.A. OPEN AREA
 APPROX. LOCATION OF 100 YEAR FLOOD LINE

**LANDSCAPE PLANTING PLAN
 LAKEVIEW SUMMIT
 PHASE 4
 CITY OF ROCKWALL, ROCKWALL COUNTY, TEXAS**

DOUPHRADE & ASSOCIATES, INC.
 ENGINEERING • PROJECT MANAGEMENT • SURVEYING
 2235 RIDGE RD., # 200 ROCKWALL, TEXAS 75087
 PHONE: (972)771-9004 FAX: (972)771-9005

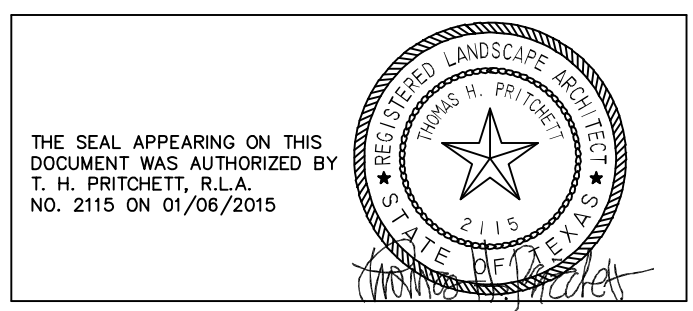

DATE	01/06/2015
DRAWN	T.H.P.
CHECKED	T.H.P.
REVISION	
FSP-3	
OR	