

LANDSCAPE PLANT SYMBOLS

- TREE MITIGATION TREES, 4" CAL.
- LANDSCAPE EDGE SHADE TREES, 3" CALIPER (1) ONE PER (50) FIFTY FEET OF LANDSCAPE EDGE BUFFER
- LANDSCAPE EDGE ACCENT TREES, ORNAMENTAL TREES (1) ONE PER (50) FIFTY FEET OF LANDSCAPE EDGE BUFFER
- PARKING AREA TREES, 3" CAULIPER (1) ONE PER 25 PARKING SPACES
- DETENTION POND AREA TREES, 3.0" CAULIPER MIN. 1 PER 750 SQ FT
- EVERGREEN ORNAMENTAL TREE FOR SCREENING
- LANDSCAPE SHRUBS LANDSCAPE EDGE, NATIVE GRASSES

LANDSCAPE PLAN LEGEND



- RRR QUANTITY
- RRR SYMBOL KEY TO PLANT LIST
- IRRIGATION SLEEVE SUPPLY 4", WIRES 2" OR AS NOTED ON PLAN

CITY OF ROCKWALL IRRIGATION INSTALLATION NOTE

1. THE CITY OF ROCKWALL PUBLIC WORKS DEPARTMENT DOES NOT ALLOW MAIN LINE BETWEEN THE BACK OF CURB AND THE RIGHT OF WAY LINE WHICH INCLUDES THE SIDEWALK IN SOME CASES.
2. THE CITY OF ROCKWALL REQUIRES MINIMUM SCHEDULE 40 0.5" PVC DIRECT BURIAL LATERAL LINES UNDER THE PAVING, OR SIDEWALKS INSTALLED AT THE SPACING REQUIRED ON THE APPROVED SITE IRRIGATION SYSTEM PLAN.
3. THE MAIN LINE AND WIRES SHALL APPARALLEL THE SIDEWALK ON THE PROPERTY SIDE OF THE RIGHT OF WAY LINE.
4. THE IRRIGATION LATERAL LINES SHALL BE PERPENDICULAR TO THE MAIN LINE.
5. CONTRACTOR TO COORDINATE LOCATIONS AND INSTALLATION OF IRRIGATION LATERAL LINES WITH THE OTHER SUB CONTRACTORS AND GENERAL CONTRACTOR AND OWNERS PRIOR TO PLACEMENT OF THE STEEL AND CONCRETE AFTER FORM WORK IS COMPLETE.
6. THE OTHER APPROVED OPTION IS TO BORE EACH LOCATION FOR LATERAL LINES AS NOTED ABOVE AFTER PLACEMENT OF THE CONCRETE PAVING OR SIDEWALKS.

SELECTED PLANT LIST

EVERGREEN TREES	COMMON NAME	BOTANICAL NAME	SIZE	ALL TREES TO BE GROWN IN CONTAINERS AND MATCH SIZES PER CALIPER, AS ALTERNATE BID
TE-1	LIVE OAK, SINGLE TRUNK	QUERCUS VIRGINIANA	BB: 3.0"-3.5" 10-12 FT HIGH MATCHED FULL ROUND HEADS	
TE-2	LIVE OAK, SINGLE TRUNK	QUERCUS VIRGINIANA	BB: 4.0"-4.5" 14-16 FT HIGH MATCHED FULL ROUND HEADS	
TE-3	ELDERICA PINE	PINUS ELDERICA	BB: 3.0"-3.5" 10-12 FT HIGH MATCHED FULL ROUND HEADS	
TE-4	MAGNOLIA GRANDIFLORA	MAGNOLIA GRANDIFLORA	BB: 3.0"-3.5" 10-12 FT HIGH MATCHED FULL ROUND HEADS	
DECIDUOUS TREES	COMMON NAME	BOTANICAL NAME	SIZE	ALL TREES TO BE GROWN IN CONTAINERS AND MATCH SIZES PER CALIPER, AS ALTERNATE BID
TD-1	CEEDAR ELM	ULMUS GRASSIFOLIA	BB: 3.0"-3.5" 10-12 FT HIGH MATCHED FULL ROUND HEADS	
TD-2	CEEDAR ELM	ULMUS GRASSIFOLIA	BB: 4.0"-4.5" 14-16 FT HIGH MATCHED FULL ROUND HEADS	
TD-3	OCTOBER GLORY MAPLE	ACER RUBRUM	BB: 3.0"-3.5" 10-12 FT HIGH MATCHED FULL ROUND HEADS	
TD-4	OCTOBER GLORY MAPLE	ACER RUBRUM	BB: 4.0"-4.5" 14-16 FT HIGH MATCHED FULL ROUND HEADS	
TD-5	BALD CYPRESS	TAXODIUM DISTICHUM	BB: 3.0"-3.5" 10-12 FT HIGH MATCHED FULL ROUND HEADS	
TD-6	BALD CYPRESS	TAXODIUM DISTICHUM	BB: 4.0"-4.5" 14-16 FT HIGH MATCHED FULL ROUND HEADS	
TD-7	RED OAK	QUERCUS RUBRA SHUMARDII	BB: 3.0"-3.5" 10-12 FT HIGH MATCHED FULL ROUND HEADS	
TD-8	RED OAK	QUERCUS RUBRA SHUMARDII	BB: 4.0"-4.5" 14-16 FT HIGH MATCHED FULL ROUND HEADS	
ORNAMENTAL TREES	COMMON NAME	BOTANICAL NAME	SIZE	ALL TREES TO BE GROWN IN CONTAINERS AND MATCH SIZES PER CALIPER, AS ALTERNATE BID
OT-1	CREWRYTLE ANTOCHES	LARGENTOMA INDICA, WHITE	BB: 3.0"-3.5" 10-12 FT HIGH MATCHED FULL ROUND HEADS	
OT-2	CREWRYTLE ANTOCHES	LARGENTOMA INDICA, WHITE	BB: 4.0"-4.5" 14-16 FT HIGH MATCHED FULL ROUND HEADS	
OT-3	NELLE R. STEVENS	LEX X N.R.S. HOLLY	BB: 3.0"-3.5" 10-12 FT HIGH MATCHED FULL ROUND HEADS	
OT-4	NELLE R. STEVENS	LEX X N.R.S. HOLLY	BB: 4.0"-4.5" 14-16 FT HIGH MATCHED FULL ROUND HEADS	
SHRUBS, HERGES	COMMON NAME	BOTANICAL NAME	SIZE	ALL TREES TO BE GROWN IN CONTAINERS AND MATCH SIZES PER CALIPER, AS ALTERNATE BID
SH-1	ANDORRA JUNIPER	JUNIPERUS ANDORRA	5 GAL.	
SH-2	OWARF YAUPON HOLLY	LEX VOMITORIA, NANA	3 GAL.	
SH-3	INDIAN HAWTHORN WHITE	RAPIHEDORIS INDICA	3 GAL.	
SH-4	DWARF BURNING HOLLY	LEX CORNUTA, BURFCOROI	3 GAL.	
GROUND COVERS	COMMON NAME	BOTANICAL NAME	SIZE	ALL TREES TO BE GROWN IN CONTAINERS AND MATCH SIZES PER CALIPER, AS ALTERNATE BID
GC-1	MEXICAN FEATHER GRASS	STIPS CAPILLATA, TENUSISAKA	4" POTS	
GC-2	MEXICAN FEATHER GRASS	STIPS CAPILLATA, TENUSISAKA	1 GALLON	
PERENNIALS	COMMON NAME	BOTANICAL NAME	SIZE	ALL TREES TO BE GROWN IN CONTAINERS AND MATCH SIZES PER CALIPER, AS ALTERNATE BID
PR-1	EVERGREEN DAYLILY "RED"	HEMEROCALLIS X MOND "RED"	1 GALLON	
PR-2	TRAILING LANTANA "ORANGE"	LANTANA MONTEVIDENSIS	1 GALLON	
PR-3	TRAILING LANTANA "ORANGE"	LANTANA MONTEVIDENSIS	1 GALLON	
GRASS	COMMON NAME	BOTANICAL NAME	SIZE	ALL TREES TO BE GROWN IN CONTAINERS AND MATCH SIZES PER CALIPER, AS ALTERNATE BID
BG-1	BERMUDA GRASS	BERMUDA SPECIES, COMMON	SOLID SOO	

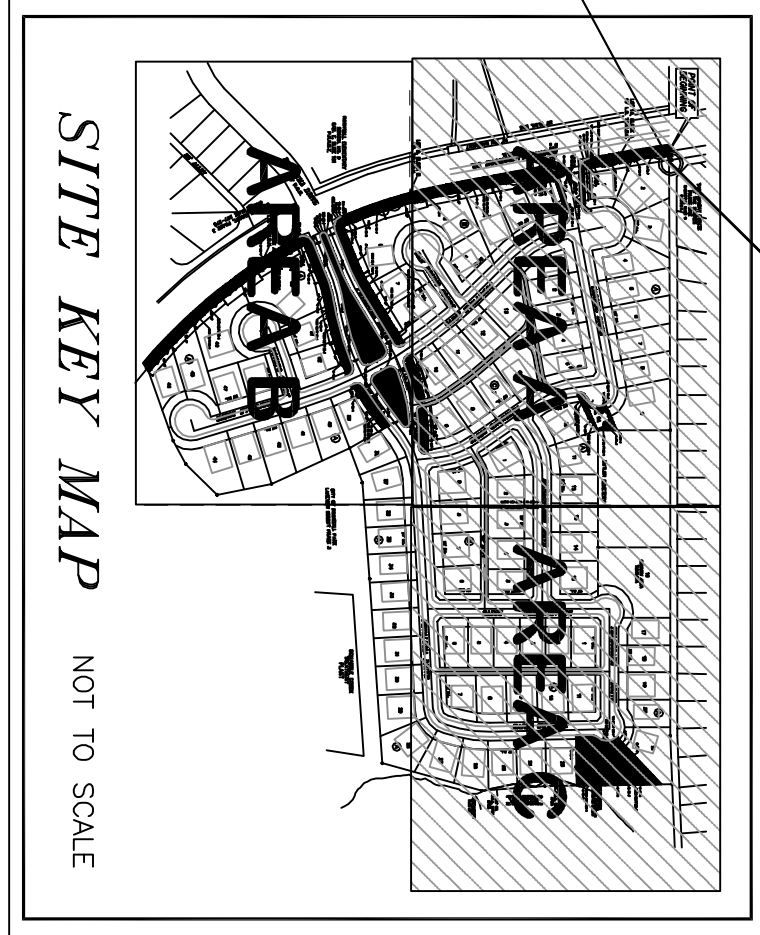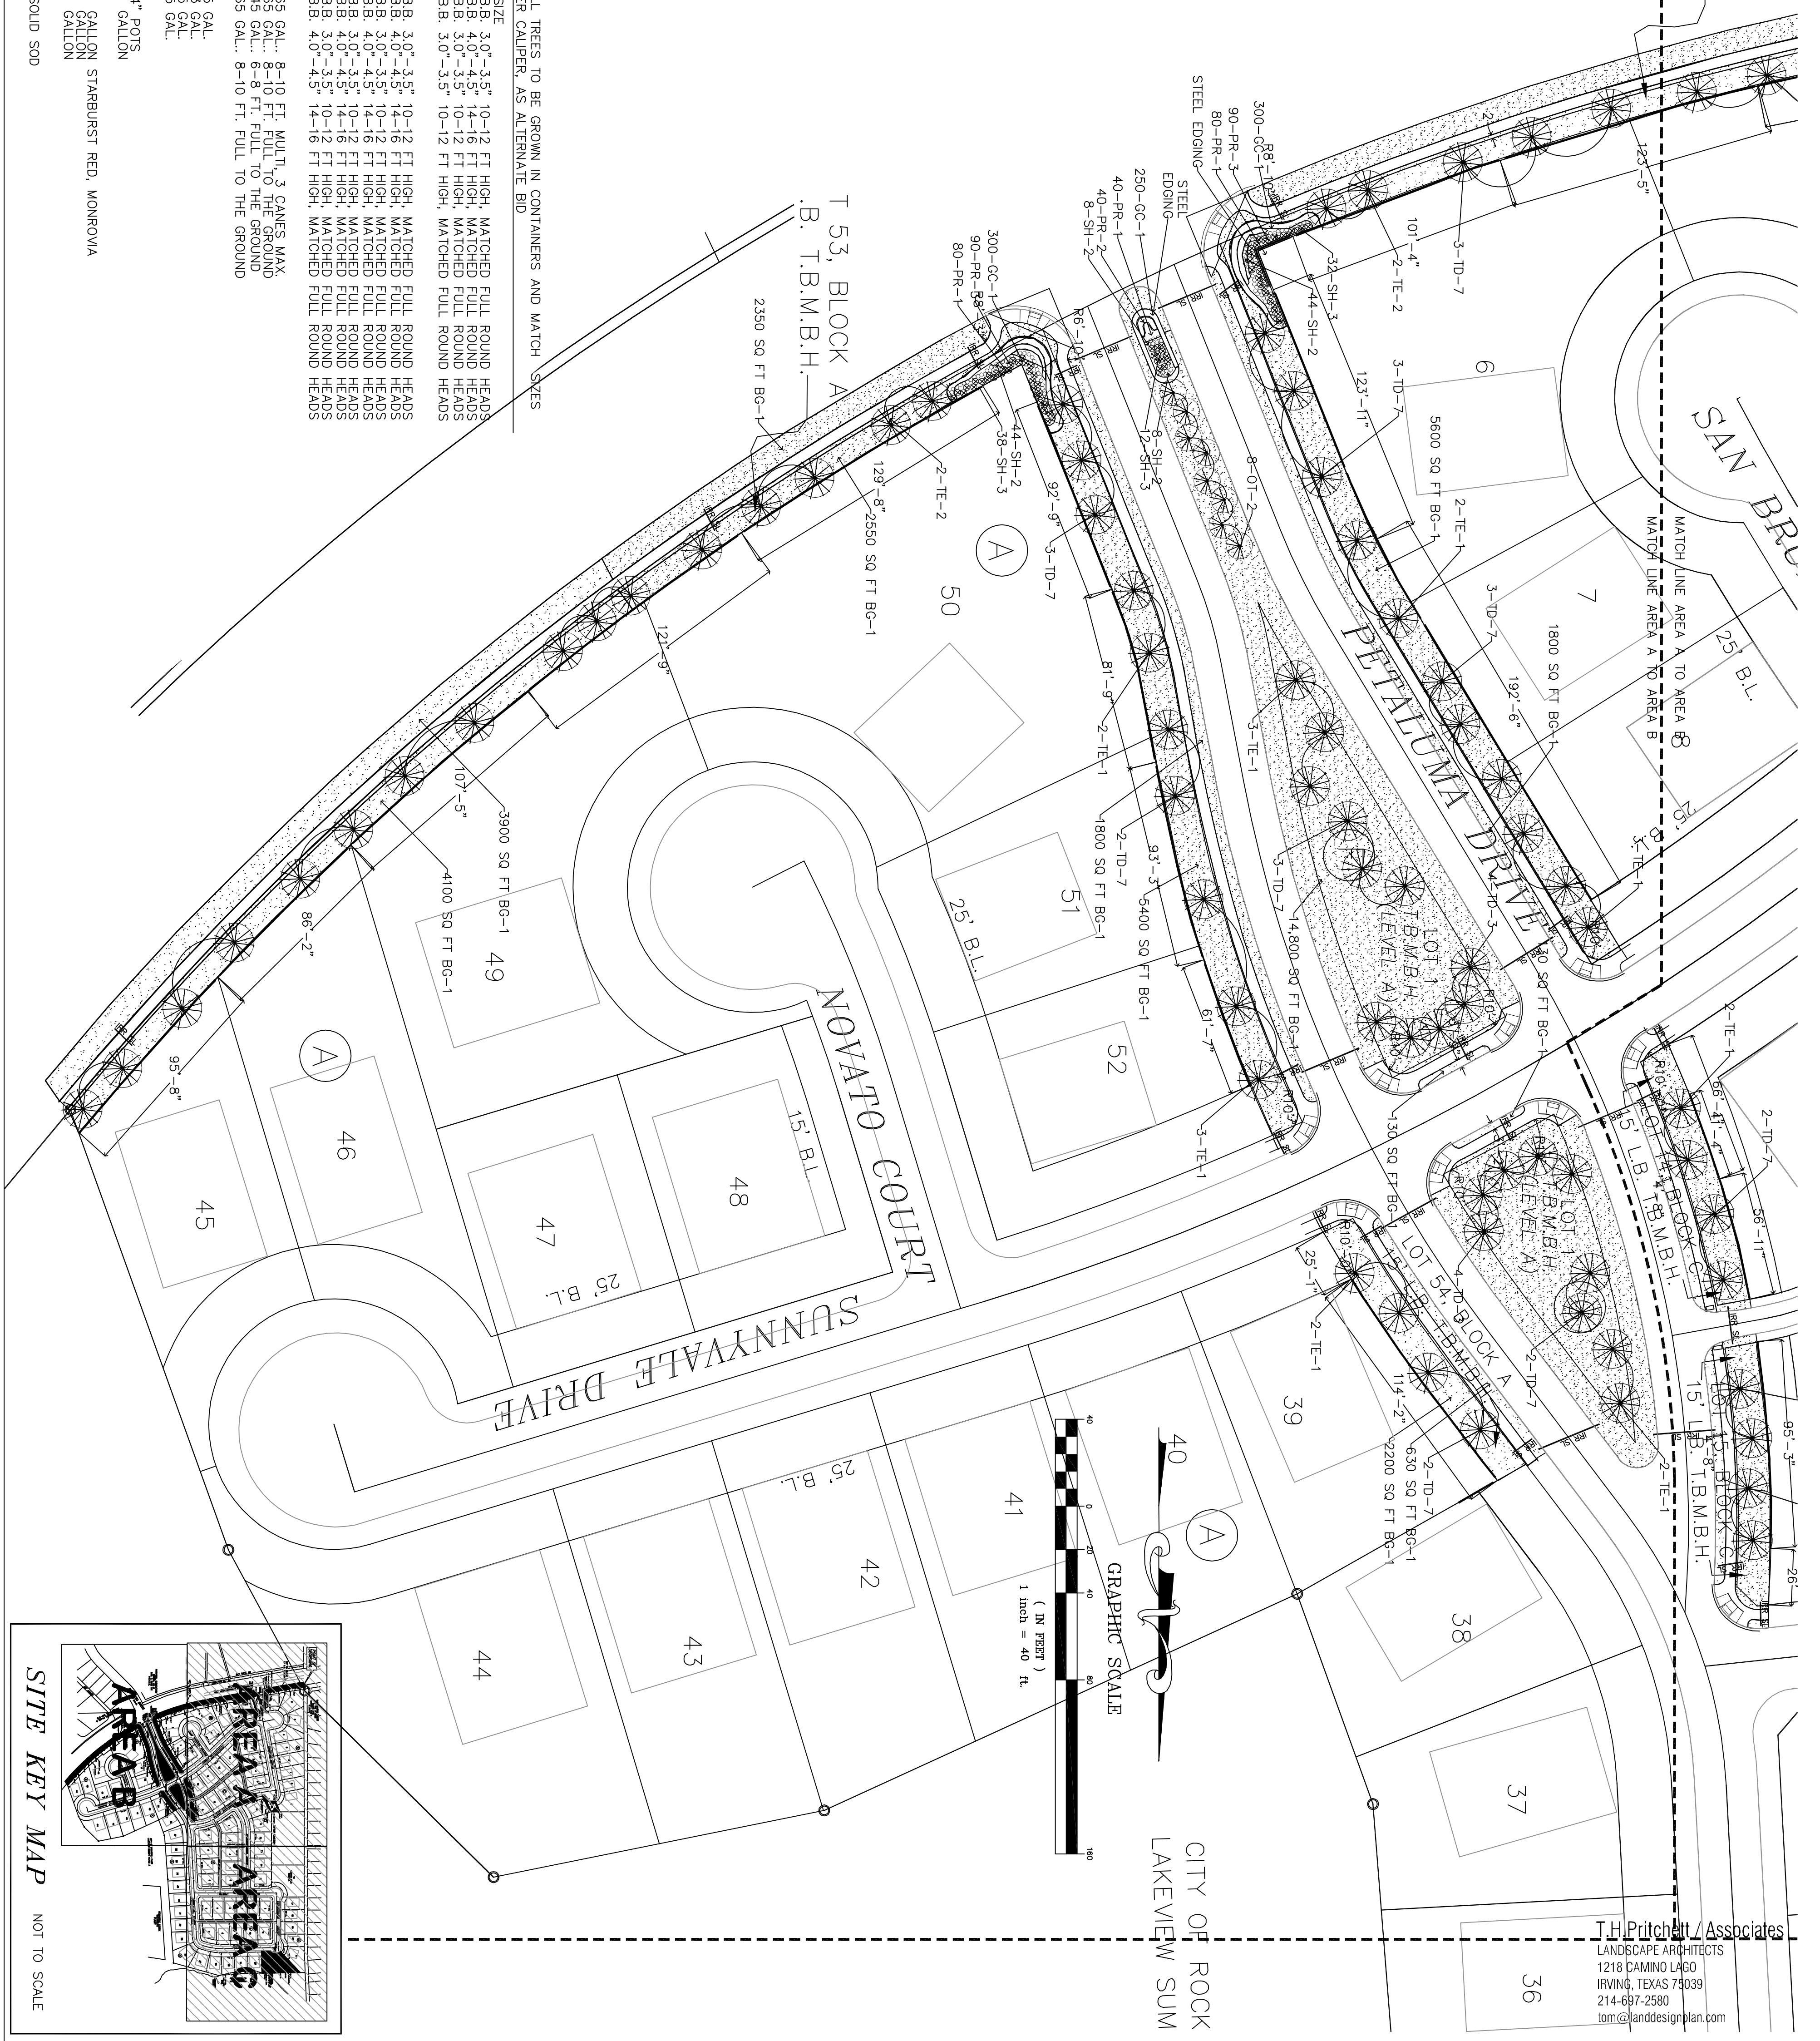

T.H.Pritchett / Associates  
 LANDSCAPE ARCHITECTS  
 1218 CAMINO LAGO  
 IRVING, TEXAS 75039  
 214-697-2580  
 tom@landdesignplan.com

<p>LANDSCAPE PLANTING PLAN                  LAKEVIEW SUMMIT                  PHASE 4                  CITY OF ROCKWALL, ROCKWALL COUNTY, TEXAS</p>	<p><b>DOUPHRATE &amp; ASSOCIATES, INC.</b>                  ENGINEERING • PROJECT MANAGEMENT • SURVEYING                  2235 RIDGE RD., # 200 ROCKWALL, TEXAS 75087                  PHONE: (972)771-9004 FAX: (972)771-9005</p>	<p>THE SEAL APPEARING ON THIS DOCUMENT WAS AUTHORIZED BY T. H. PRITCHETT, R.L.A. NO. 2115 ON 01/06/2015</p>
<p>REVISION</p> <p>THP</p> <p>THP</p> <p>DATE: 01/06/2015</p> <p>LANDSCAPE PLANTING PLAN PROJECT</p> <p>LPP-1 OF</p>		