

$\frac{3}{4}$ " GUIDE BAR (2x)
(SCHEDULE 40 PIPE)
(SIZED PER FLYGT AND PROVIDED BY FLYT)

NOM. SIZE
NPT

POWER CABLE

MIN. LIQUID LEVEL


ALL DIMENSIONS IN INCHES

NOM. SIZE	VERSION	DIMENSIONAL CHART																		
		A	B	C	D	E	F	G	H	J	K	L	M	N	P	R	S	T	U	V
2"	HT	1 1/4	4	4 1/2	2 1/4	5 1/4	6 3/4	3	20 1/2	2 1/4	9 1/4	20	5 1/2	5 1/2	5 1/2	21 1/4	13 3/4	6	3 3/4	15 3/4
2"	LT	1 1/4	4	4 1/2	2 1/4	5 1/4	6 3/4	3	20 1/2	2 1/4	9 3/4	20 1/4	5 1/2	5 1/2	5 1/2	21 3/4	14 1/4	6	3 3/4	15 3/4

NOM. SIZE	VERSION	WEIGHT(LBS)	
		PUMP	DISCH
2"	HT	175	15
2"	LT	175	15

REVISED TO CONFORM TO CONSTRUCTION RECORDS.
h. h. h. h. h. DATE: 12-1-16

- NOTES:
- DIM. TO ENDS OF GUIDE BARS.
 - REPRESENTS CLEAR INSIDE EDGE OF ACCESS FRAME OR OPENING.
 - SEE STATION DWGS. FOR COMPLETE INSTALLATION DIMENSIONS.
SIMPLEX 14-68 04 11
DUPLEX 14-68 04 13

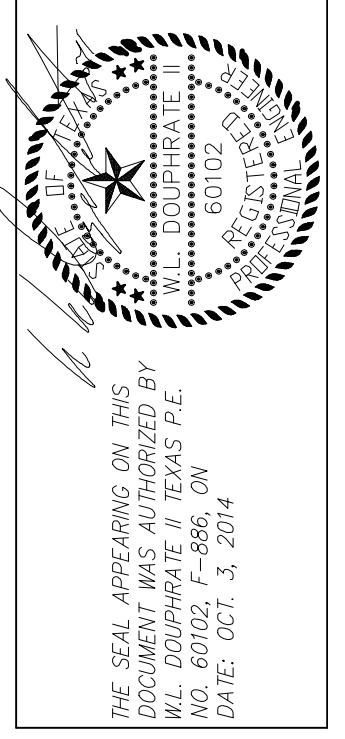

DOUPHRADE & ASSOCIATES, INC.
 ENGINEERING • PROJECT MANAGEMENT • SURVEYING
 2235 RIDGE RD., # 200 ROCKWALL, TEXAS 75087
 PHONE: (972)771-9004 FAX: (972)771-9005

LIFT STATION PLAN
 LAKEVIEW SUMMIT
 PHASE 4
 CITY OF ROCKWALL, ROCKWALL COUNTY, TEXAS

REVISION
 SAH CHECKED
 D.L.B. DRAWN
 10/14 DATE
 9919-4LIFT2 PROJECT
 10.7 OF