


DOUPHRA
TE & ASSOCIATES, INC.
ENGINEERING • PROJECT MANAGEMENT • SURVEYING
2235 RIDGE RD., # 200 ROCKWALL, TEXAS 75087
PHONE: (972)771-9004 FAX: (972)771-9005

SIGNAGE & LIGHTING PLAN
LAKEVIEW SUMMIT, PHASE IV
CITY OF ROCKWALL
ROCKWALL COUNTY, TEXAS

REVISION
WLD.
CHECKED
K.E.B.
DRAWN
10/14
DATE
9919-4 SIGN-LIGHT
PROJECT
SLP
OF

NOTE: Street Name Signs shall consist of a white legend including Logo on a green background.




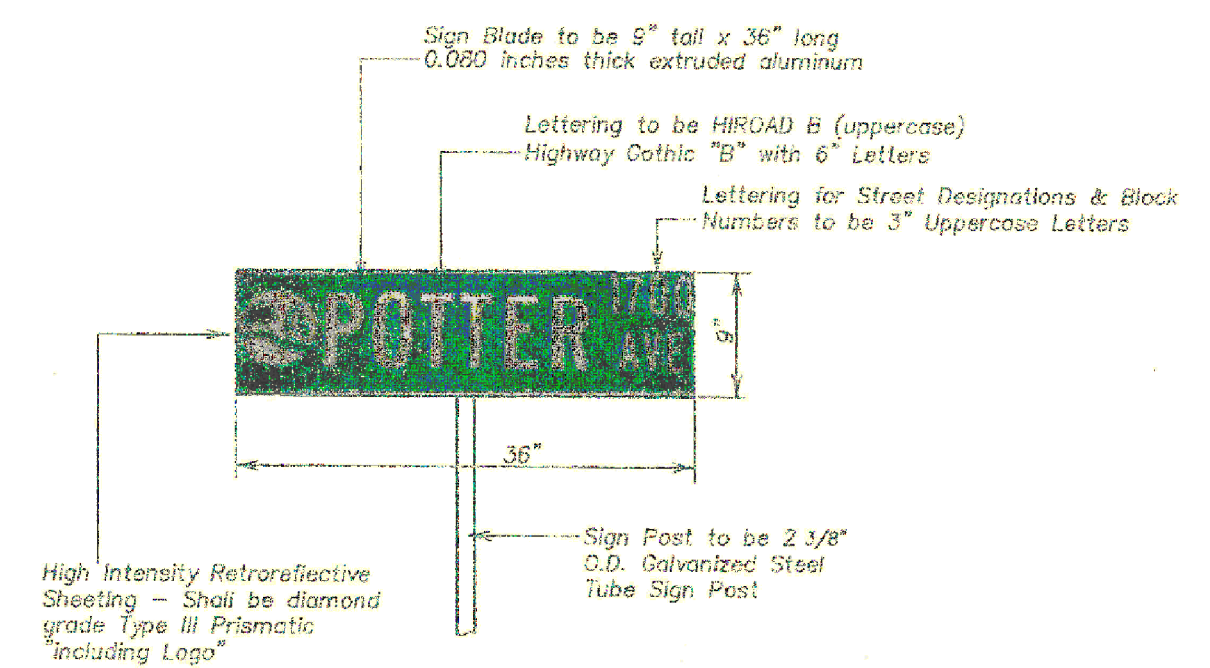


STREET SIGN DETAIL
NOT TO SCALE

LEGEND

- ◆ STOP AND/OR STREET SIGN AS LABELED
- ★ STAND ALONE STREET LIGHT
- SPEED LIMIT SIGN AS LABELED
- ◇ = STREET NAME CHANGE

- NOTES
1. BLOCK NUMBERS ARE REQUIRED ON ALL STREET NAME BLADES
 2. ALL SIGNAGE INSTALLED SHALL COMPLY WITH THE CURRENT TEXAS MANUAL ON UNIFORM TRAFFIC CONTROL DEVICES.
 3. STREET NAME BLADES SHALL BE NINE INCH TALL X 36 INCHES LONG EXTRUDED ALUMINUM. THE BLADES SHALL BE 0.080 INCHES THICK.
 4. HIGH INTENSITY RETROREFLECTIVE SHEETING FOR STREET AND REGULATORY AND WARNING SIGNS SHALL BE DIAMOND GRADE PRISMATIC TYPE III HIGH INTENSITY.
 5. THE LETTERING FOR STREET NAME BLADES SHALL BE HIROAD B-FONT HIGHWAY GOTHIC-B UPPERCASE 6" TALL LETTERS. LETTERS OF ABBREVIATED STREET DESIGNATIONS SHALL BE 3" TALL AND ALL UPPERCASE (I.E., LN, PKWY, CT, ETC.). BLOCK NUMBERS SHALL BE 3" TALL
 6. THE STREET BACKGROUND SHALL BE GREEN AND THE LEGEND SHALL BE WHITE.
 7. STREET BLADE MUST INCORPORATE THE CURRENT CITY OF ROCKWALL LOGO
 8. FOR A STREET WITH ONLY A CUL-DE-SAC END A STANDARD W14-2A SHALL BE MOUNTED OVER THE STREET NAME BLADE. IN THE CASE WHERE TWO CUL-DE-SAC ENDS, TWO STANDARD W 14-2A SIGNS SHALL BE MOUNTED OVER THE STREET NAME BLADE IN THE APPROPRIATE DIRECTIONS.

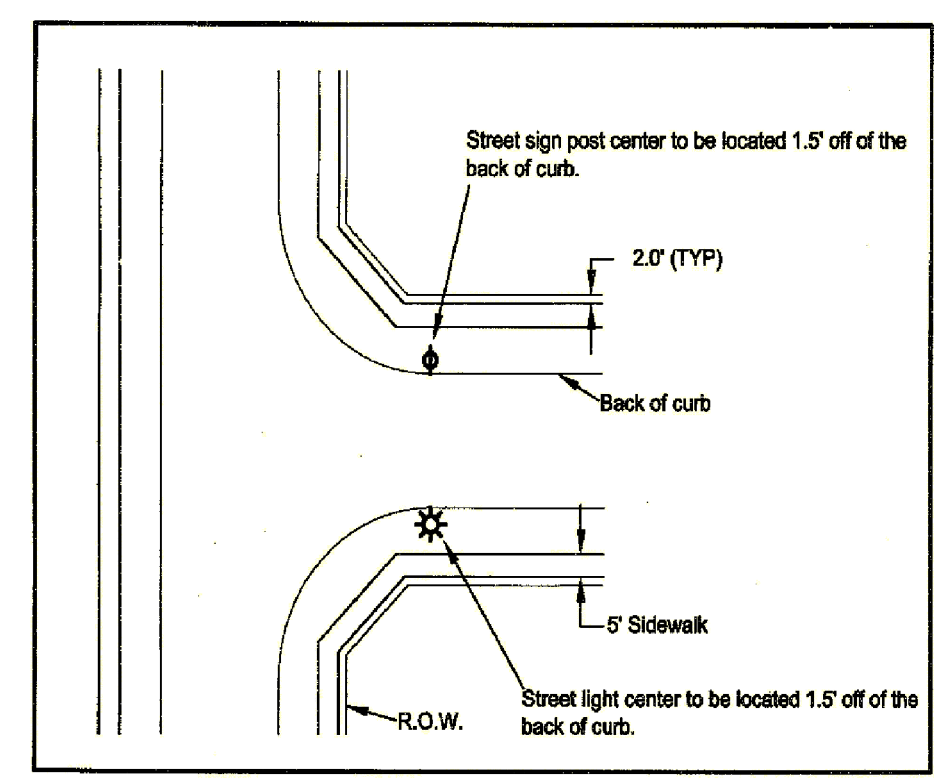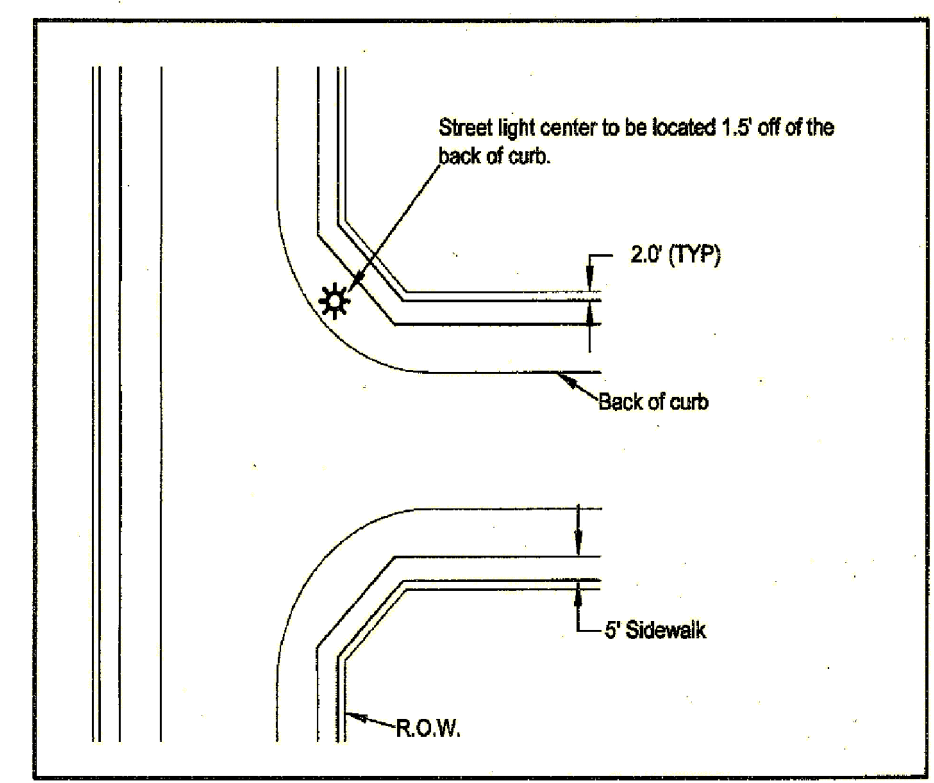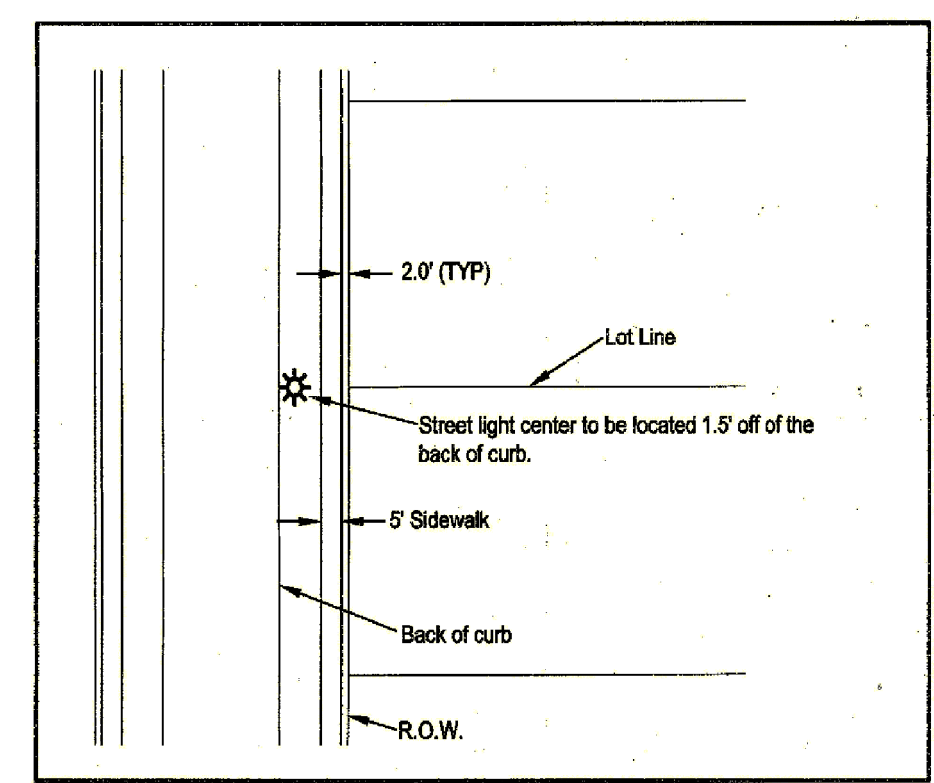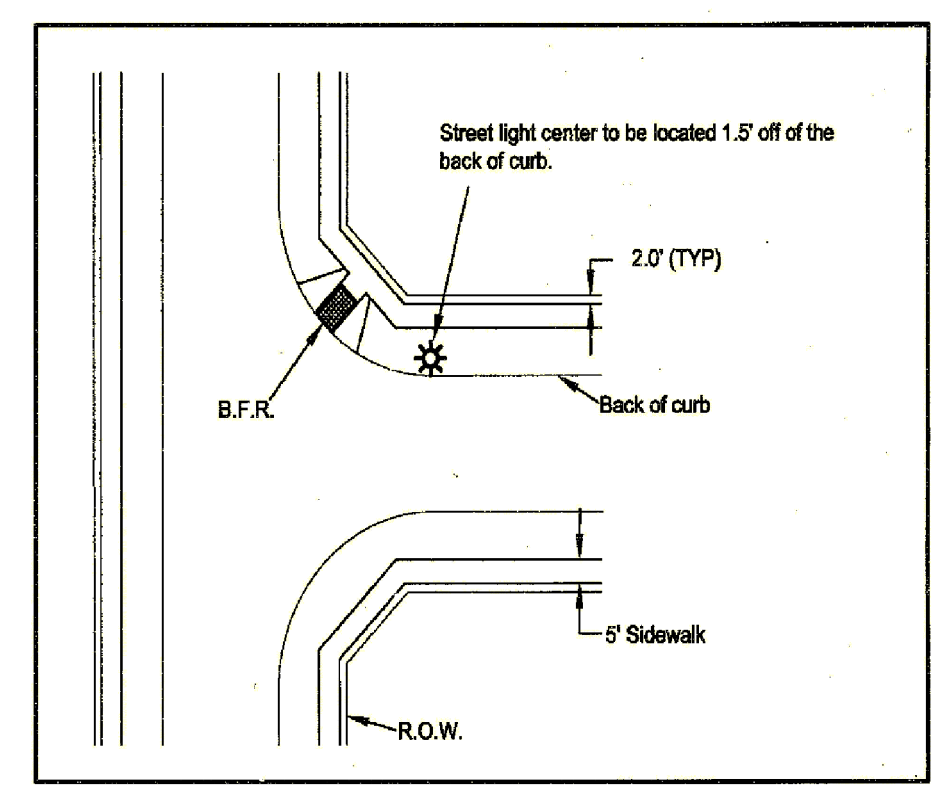

REVISED TO CONFORM TO CONSTRUCTION RECORDS.
DATE: 12-1-16

GRAPHIC SCALE

