



- LEGEND**
- TREES TO BE SAVED
 - TREES TO BE REMOVED

RETAINING WALL - - - - -

BENCHMARK:
 BRASS CAP MONUMENT NO. 10 SET IN
 CONCRETE IN THE CENTER OF GRASS
 MEDIAN IN MASTERS DRIVE BETWEEN
 NORTH LAKESHORE & SHORES BLVD.
 N 7032464.6317, E 2589554.1518
 ELEV. = 524.62

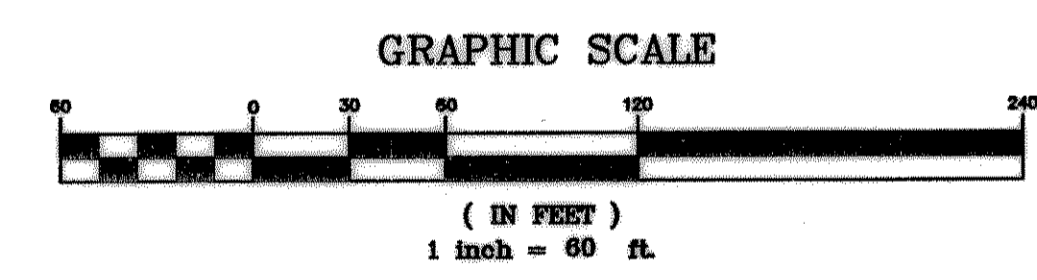

RECORD DRAWINGS:
 THE INTENT OF THE OWNER AND ENGINEER
 WAS TO CONSTRUCT THESE FACILITIES
 ACCORDING TO THESE PLANS AS APPROVED BY
 THE CITY OF Rockwall. THE LINES
 AND GRADES WERE SET ON THE GROUND FOR
 CONSTRUCTION ACCORDING TO SAID PLANS.
 THE CITY OF Rockwall INSPECTED
 THE CONSTRUCTION. THE OWNER NOR
 ENGINEER DID NOT VERIFY LINES OR GRADES
 AFTER CONSTRUCTION. WE ARE NOT AWARE
 OF ANY CHANGES OR REVISIONS TO THESE
 PLANS DURING CONSTRUCTION EXCEPT AS
 NOTED. 4/18/02

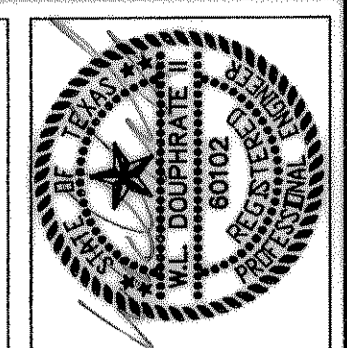

THE SEAL APPEARING ON THIS
 DOCUMENT WAS AUTHORIZED BY
 W.L. DOUPHRATE II
 LICENSE NO. 80102 ON 4/18/02

DOUPHRATE & ASSOCIATES, INC.
 ENGINEERING • PROJECT MANAGEMENT • SURVEYING
 2235 RIDGE RD., # 200 ROCKWALL, TEXAS 75087
 PHONE: (972)771-9004 FAX: (972)771-9005

TREE PRESERVATION PLAN
LAKEVIEW SUMMIT, PHASE 1-A
 CITY OF ROCKWALL
 ROCKWALL COUNTY, TEXAS

REVISION	W.L.D.
CHECKED	KEB.
DRAWN	8/16/00
DATE	9919-1ATREE2
PROJECT	10A
	or