
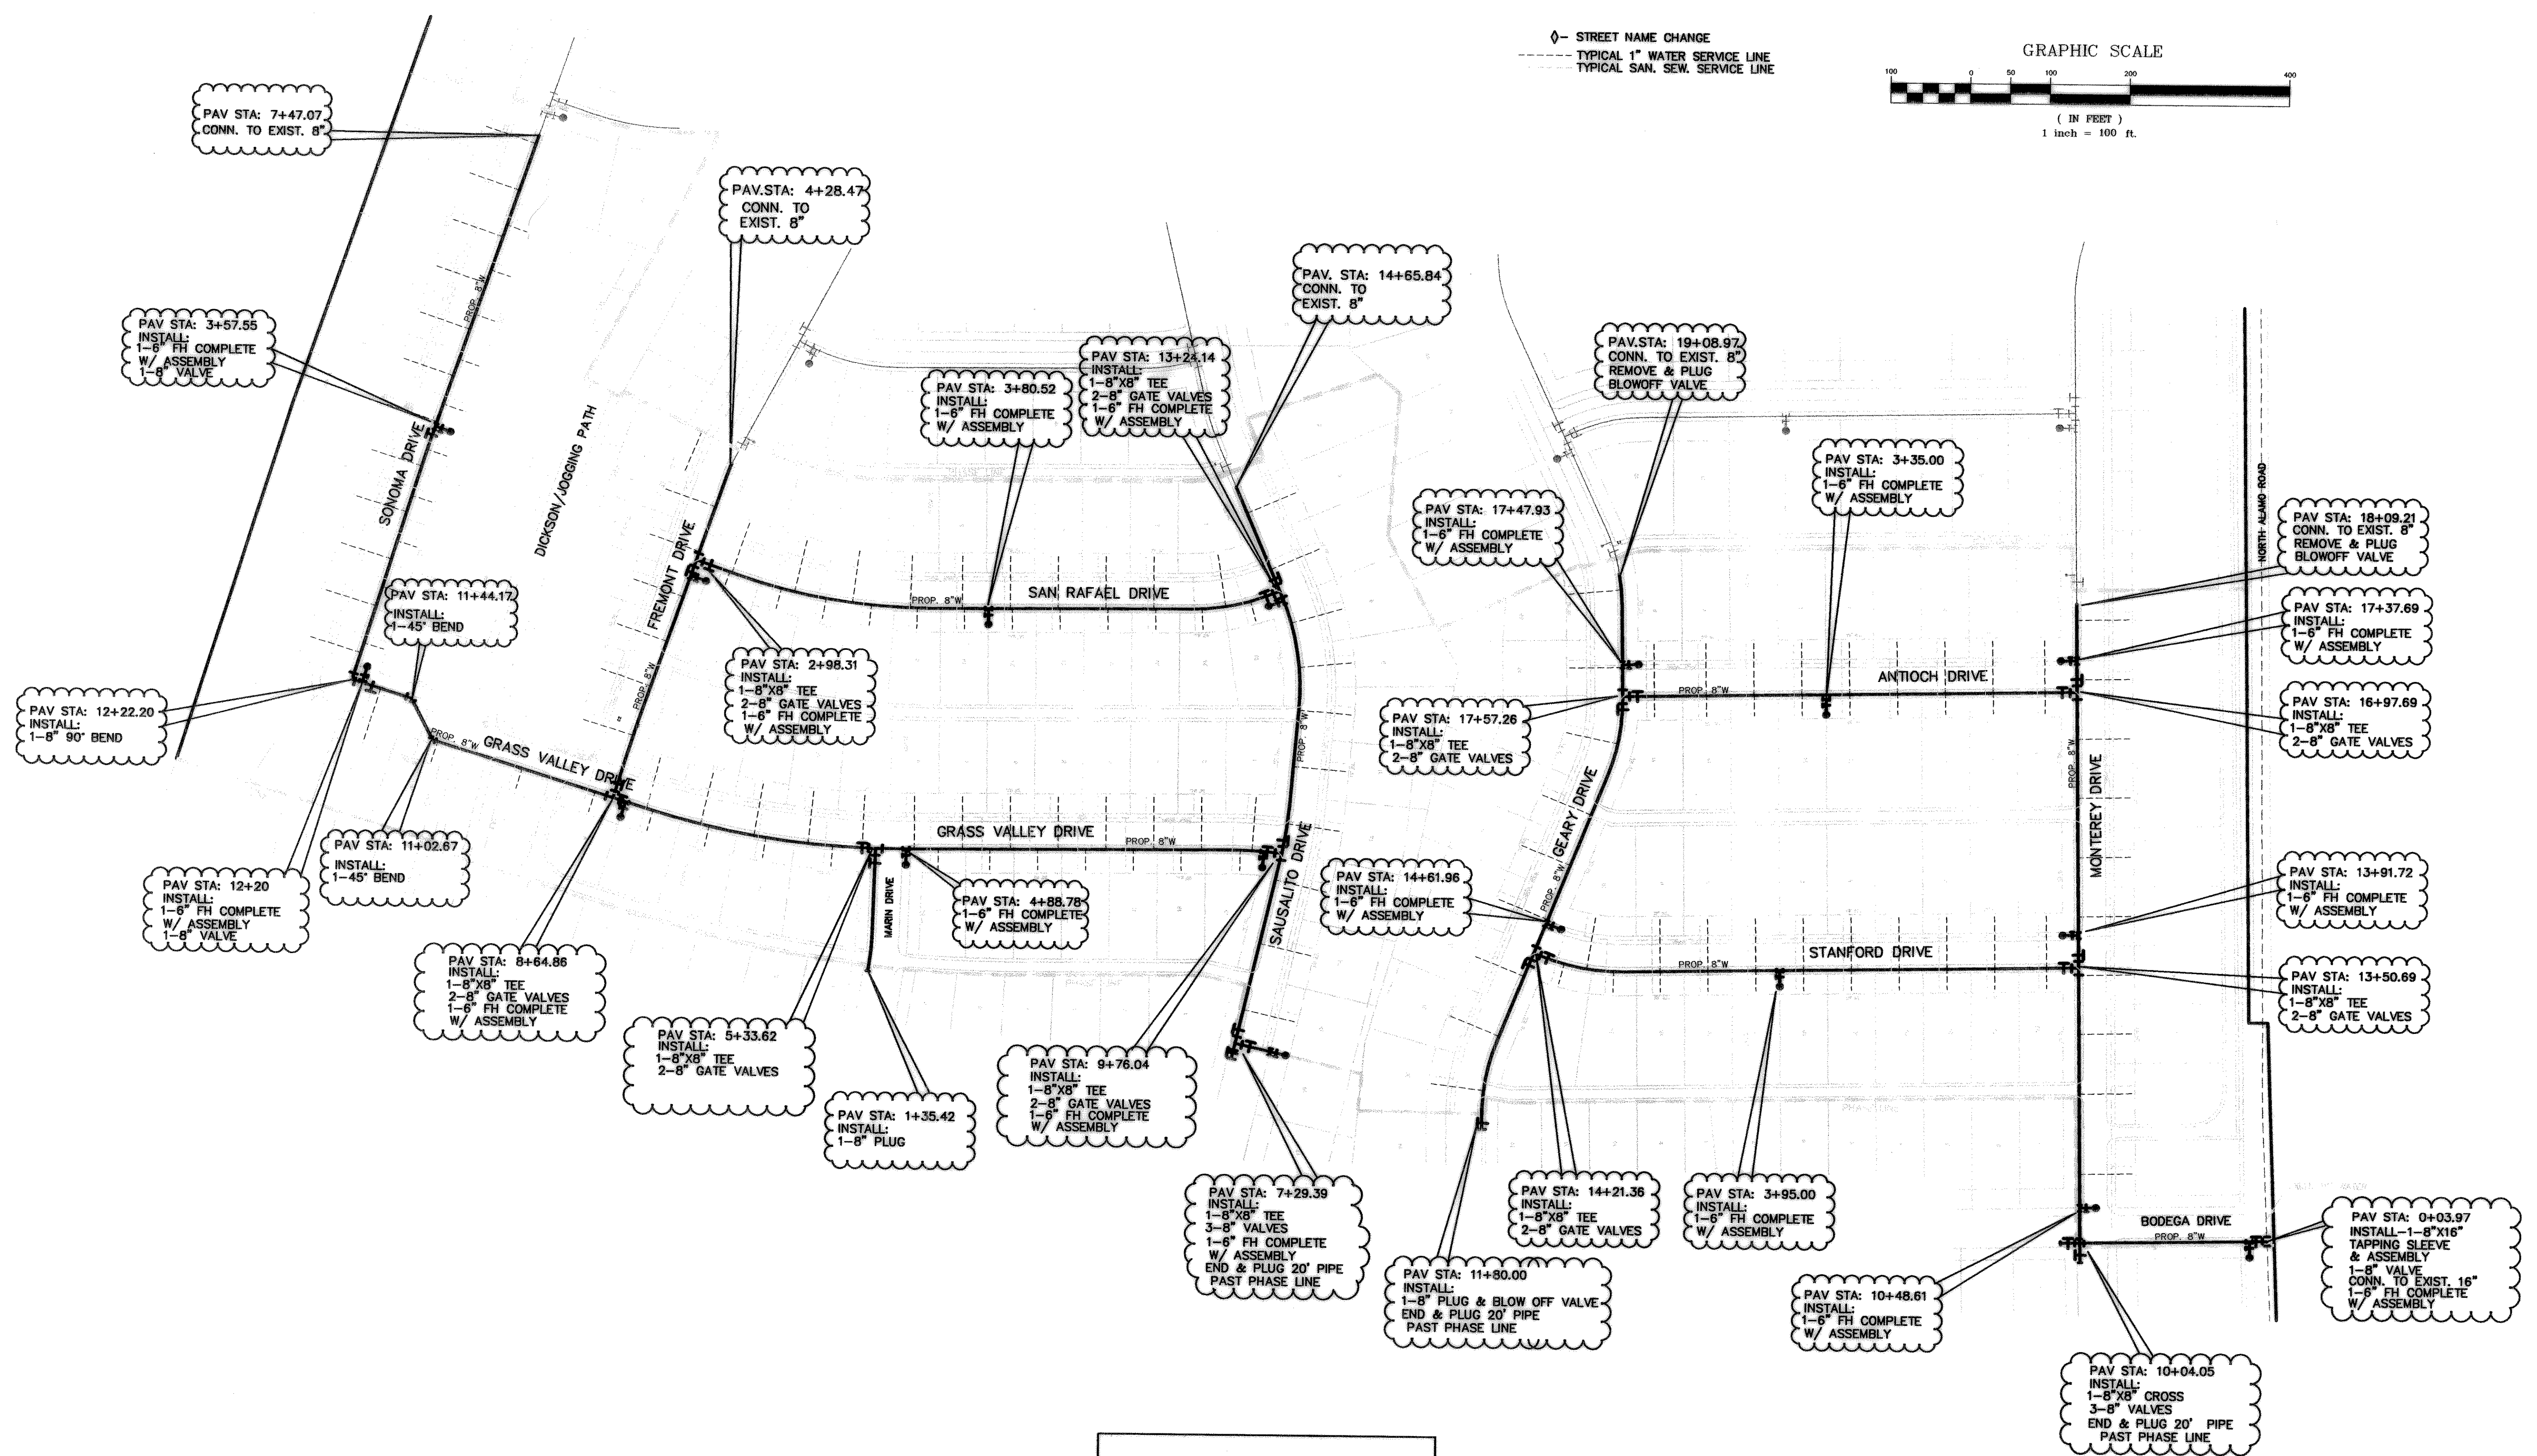


DOUPHRADE & ASSOCIATES, INC.  
 ENGINEERING - PROJECT MANAGEMENT - SURVEYING  
 2235 RIDGE RD., # 200 ROCKWALL, TEXAS 75087  
 PHONE: (972)771-9004 FAX: (972)771-9005

WATER PLAN  
 LAKEVIEW SUMMIT, PHASE 1 - A  
 CITY OF ROCKWALL  
 ROCKWALL COUNTY, TEXAS

REV. 10/20/00  
 REVISION  
 W.L.D.  
 CHECKED  
 K.E.B.  
 DRAWN  
 8/21/00  
 DATE  
 9919-IAWAT  
 PROJECT

○- STREET NAME CHANGE  
 --- TYPICAL 1" WATER SERVICE LINE  
 --- TYPICAL SAN. SEW. SERVICE LINE

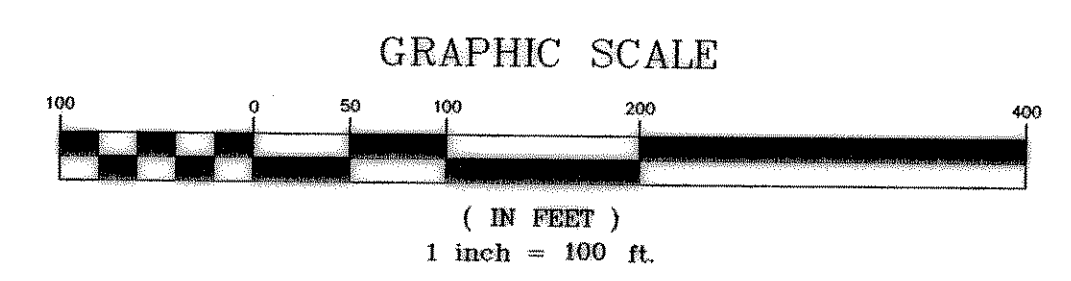

REVISED TO CONFORM TO CONSTRUCTION RECORDS.  
 DATE: 11-05-2001