
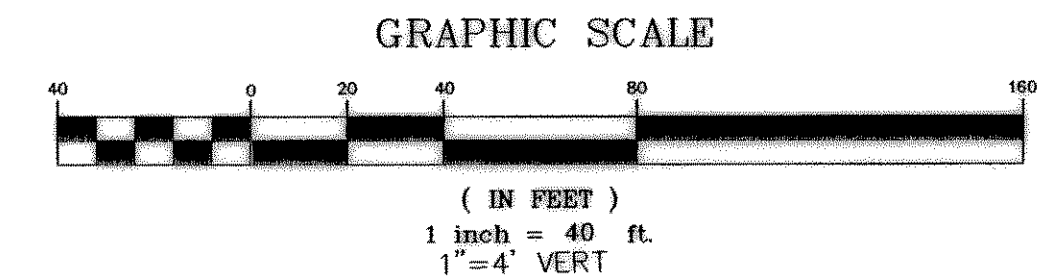



PHASE 3

PHASE 7

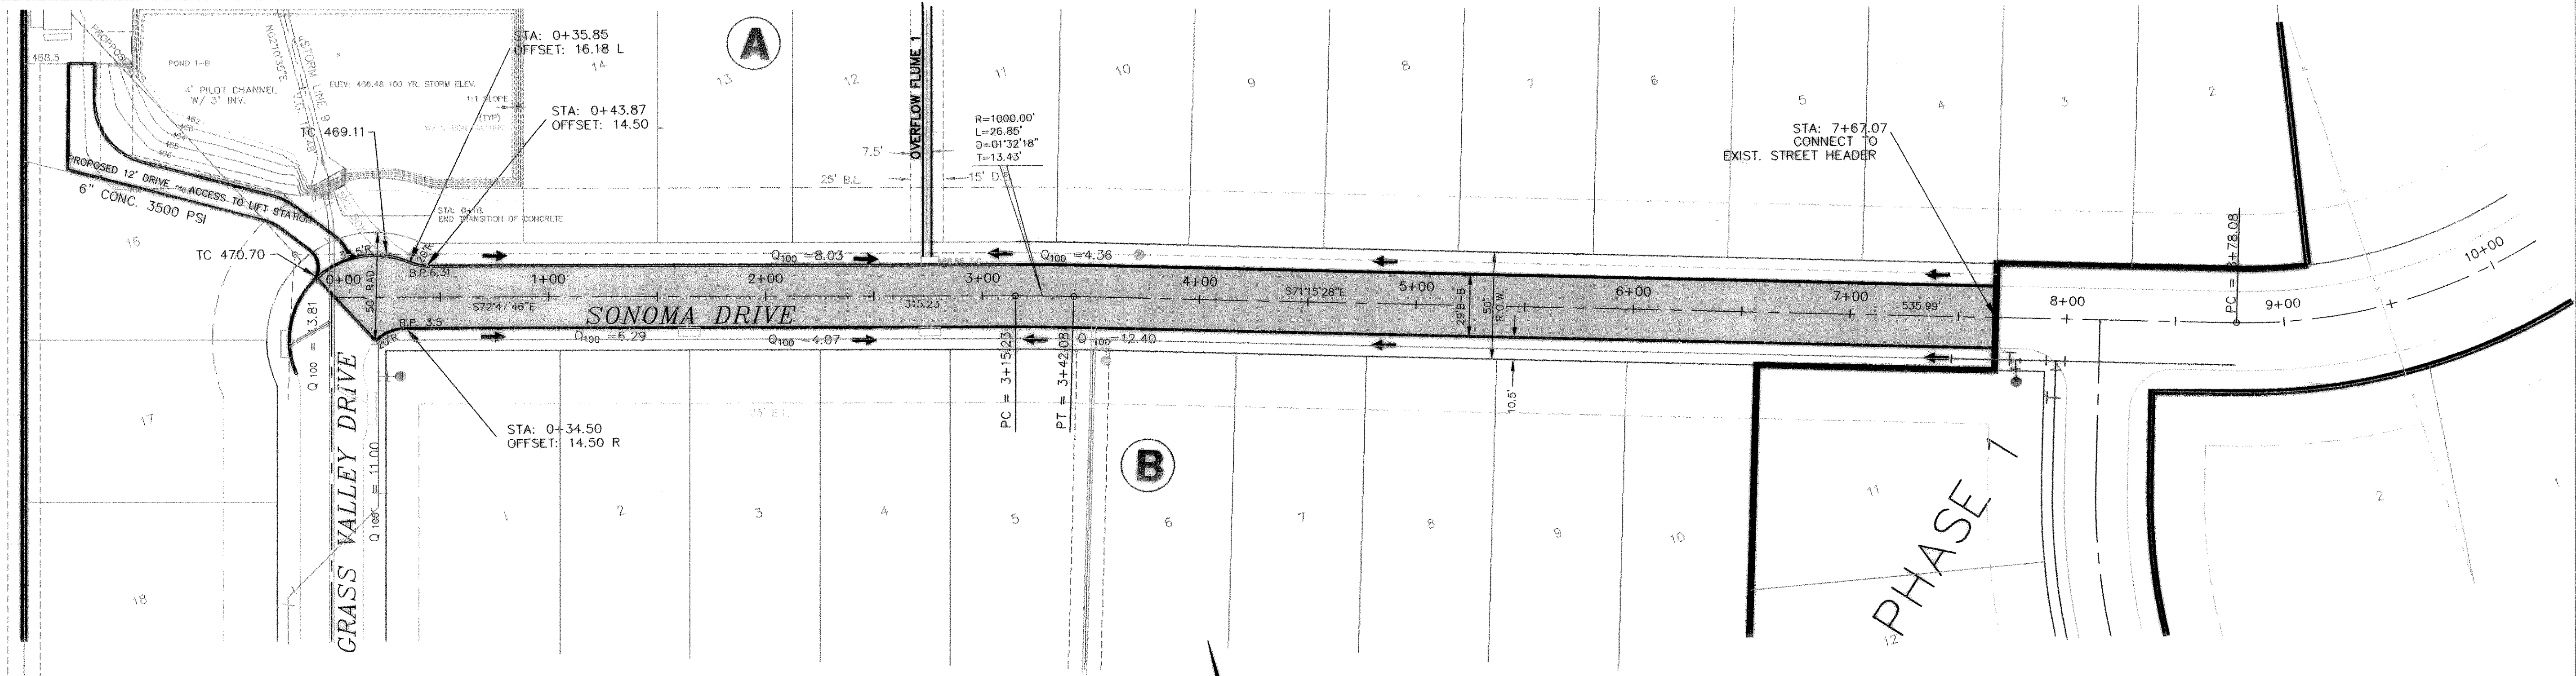

BENCHMARK:
BRASS CAP MONUMENT NO. 10 SET IN
CONCRETE IN THE CENTER OF GRASS
MEDIAN IN MASTERS DRIVE BETWEEN
NORTH LAKESHORE & SHORES BLVD.
N 7032464.6317, E 2589554.1518
ELEV. = 524.62


PVI STA = 0+00
PVI ELEV = 470.04
A.D. = 3.41
K = 49.83

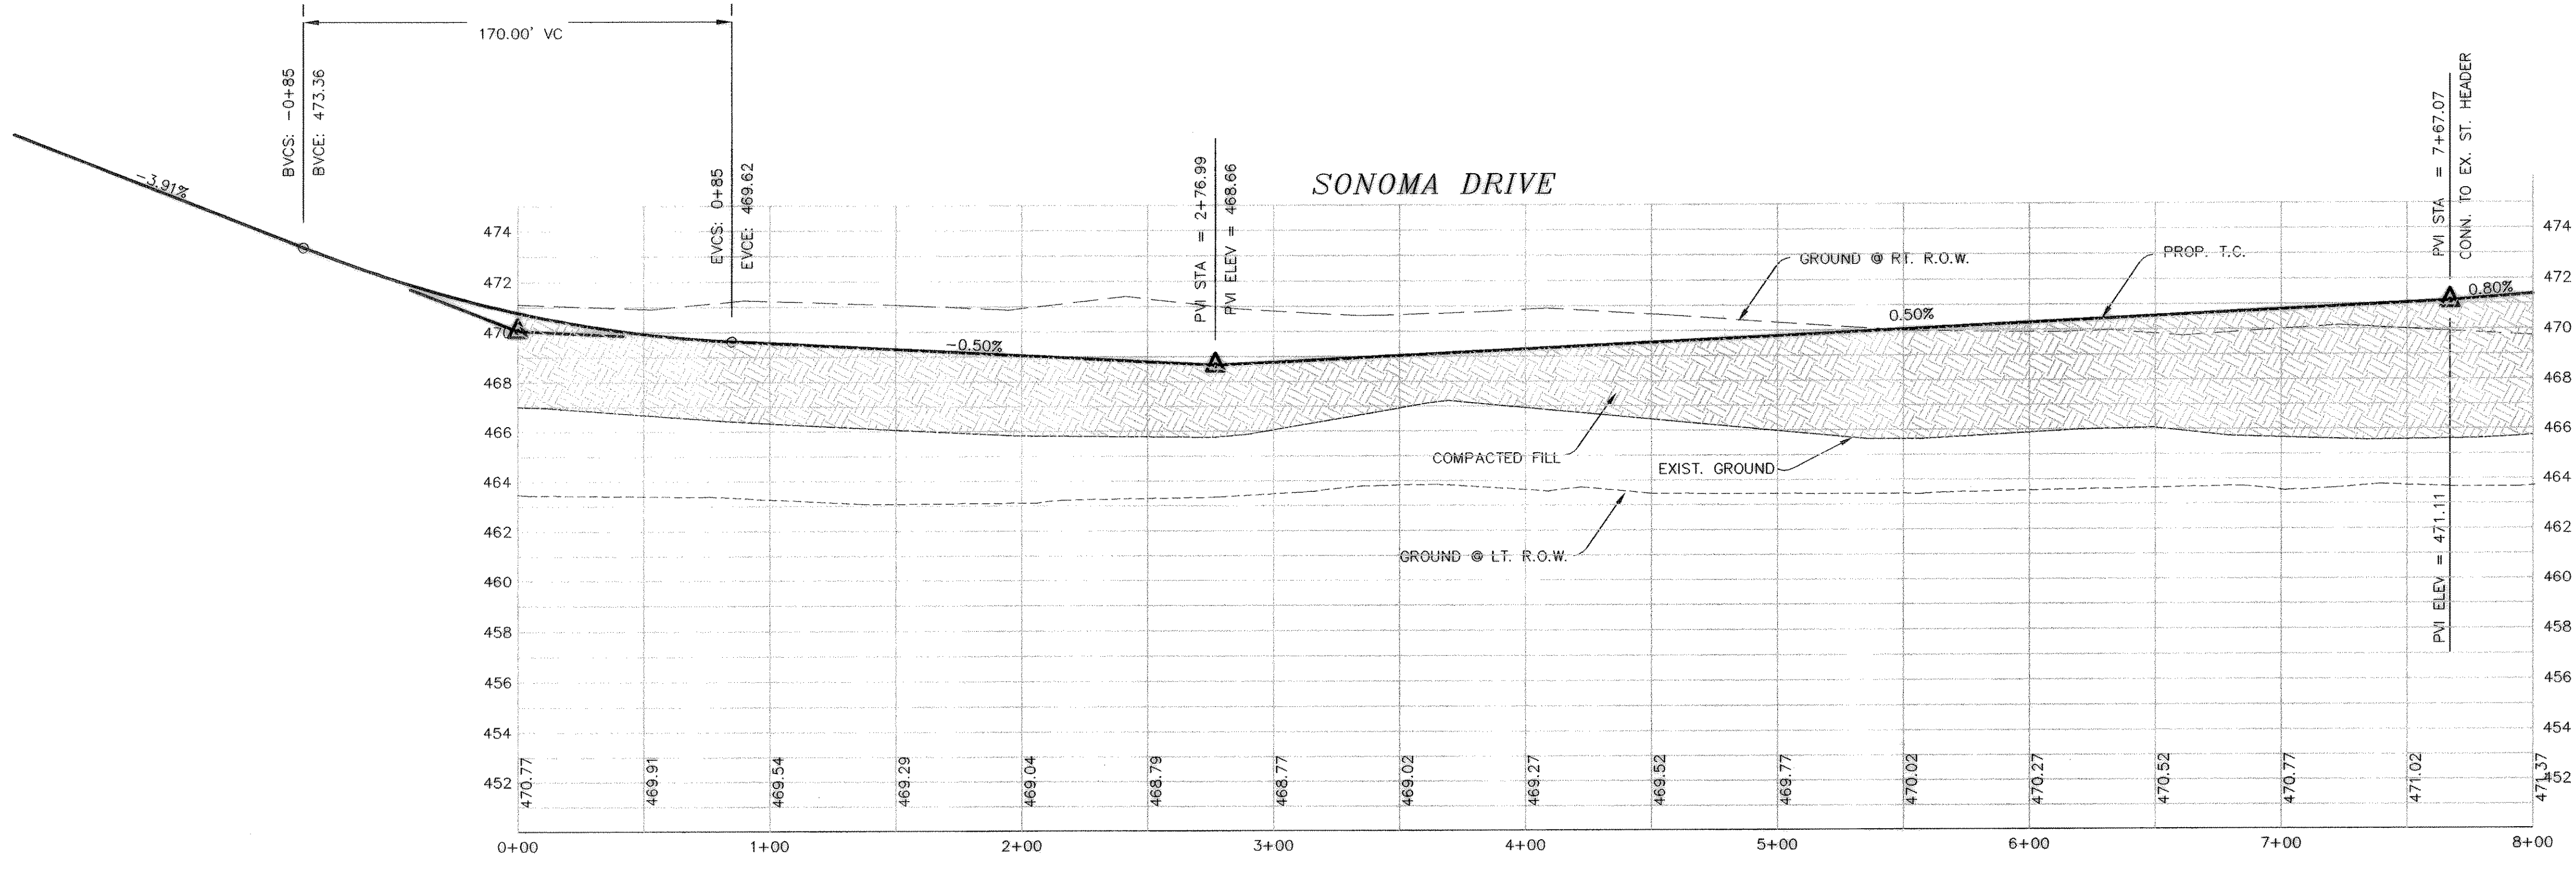

NOTE :
STA: 0+00 THRU STA: 7+67.07 TO BE 8" THICK CONC. W/ 0.5' CURBS

REVISED TO CONFORM TO CONSTRUCTION RECORDS.

W. J. [Signature] DATE: 11-05-2003

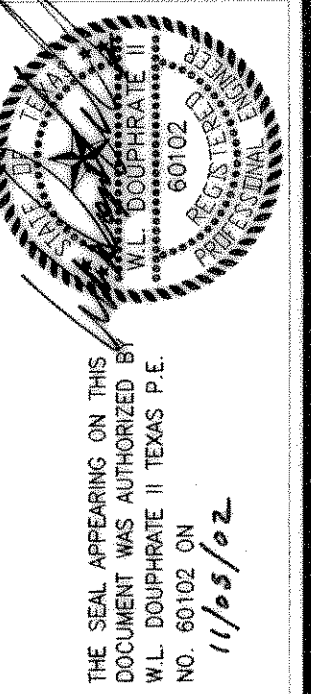

DOUPHRATE & ASSOCIATES, INC.
ENGINEERING - PROJECT MANAGEMENT - SURVEYING
2235 RIDGE RD., # 200 ROCKWALL, TEXAS 75087
PHONE: (972)771-9004 FAX: (972)771-9005

PAVING PLAN & PROFILE
SONOMA DRIVE STA: 0+00 TO 7+67.07
LAKEVIEW SUMMIT, PHASE 1A
CITY OF ROCKWALL, COUNTY OF ROCKWALL

REVISION	
WLD.	
CHECKED	
K.E.B.	
DRAWN	
8/14/00	
DATE	
9919-1APVI	
PROJECT	