


DOUPHRADE & ASSOCIATES, INC.
 ENGINEERING - PROJECT MANAGEMENT - SURVEYING
 2235 RIDGE RD., # 200 ROCKWALL, TEXAS 76087
 PHONE: (972)771-9004 FAX: (972)771-9005

WATER PLAN
 LAKEVIEW SUMMIT
 PHASE 2
 CITY OF ROCKWALL, ROCKWALL COUNTY, TEXAS

REVISION
 - REVISIONS PER CITY COMMENTS 2/5/02
 - REVISIONS PER CITY COMMENTS 5/10/02

W.L.D.
 CHECKED
 K.E.B.
 DRAWN
 11/01
 DATE
 9919-2WAT
 PROJECT
 19
 OF

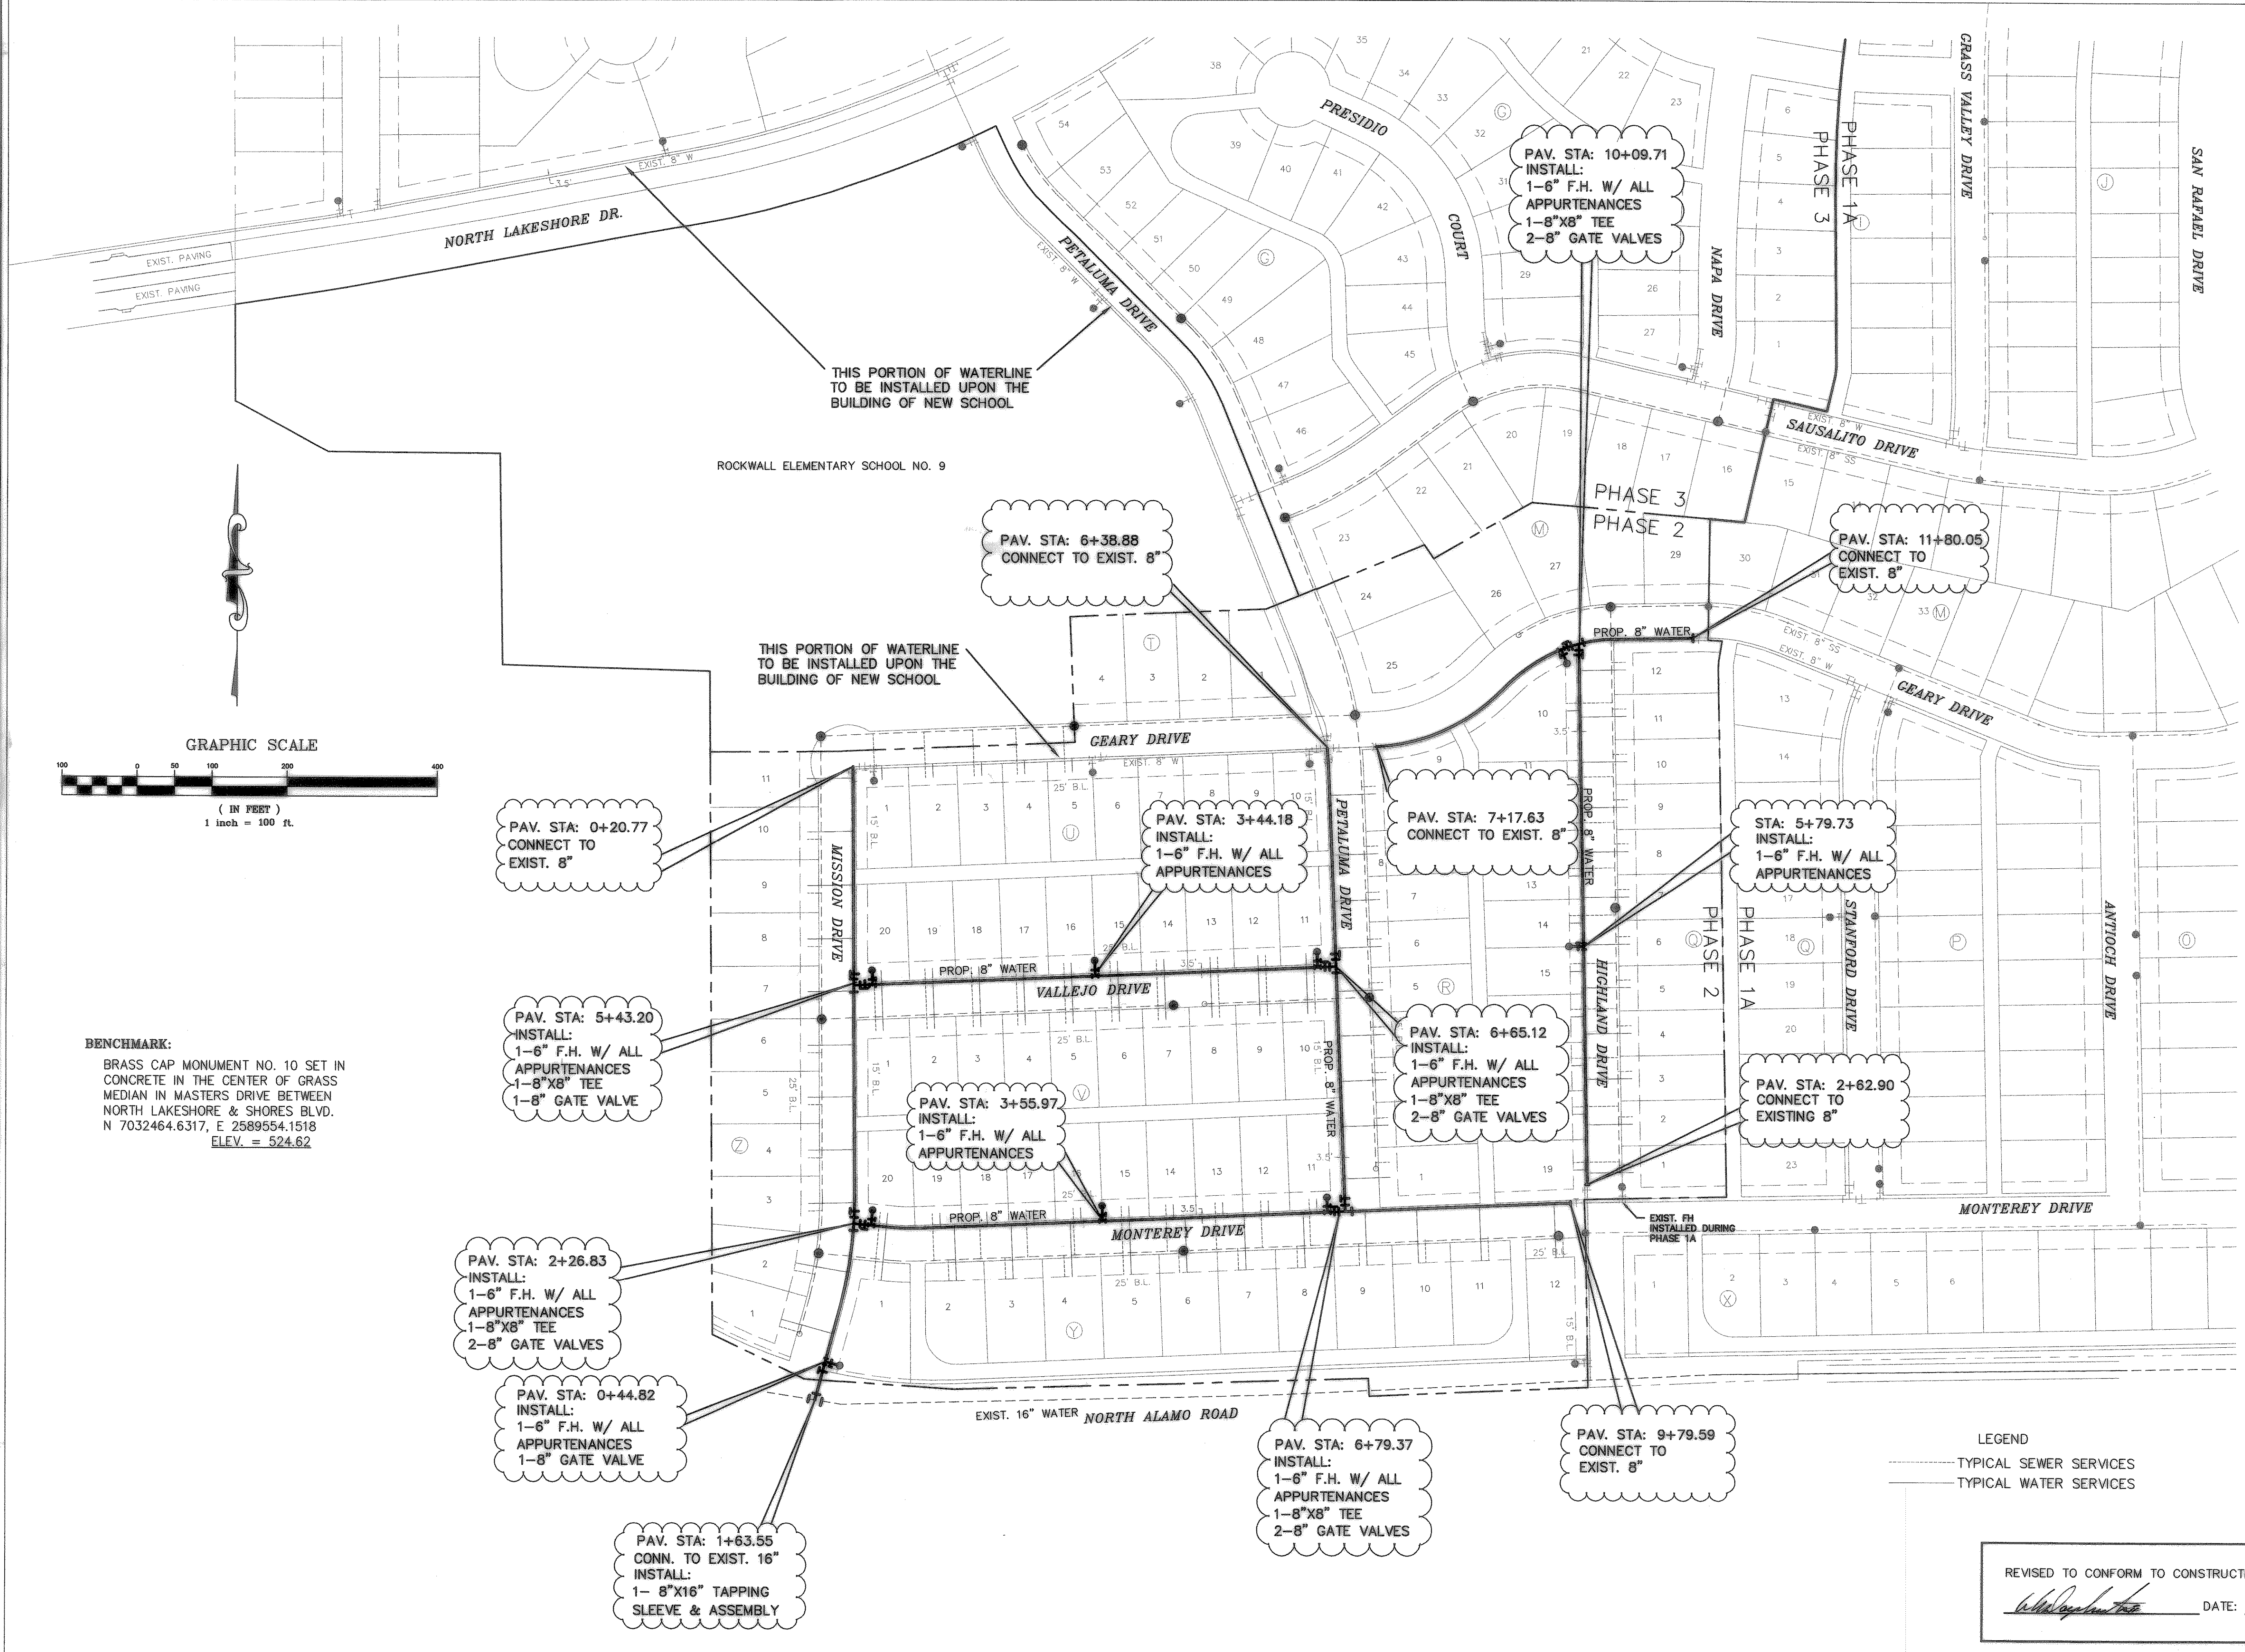

REVISED TO CONFORM TO CONSTRUCTION RECORDS.
William J. ... DATE: 11/6/01