



REVISED TO CONFORM TO CONSTRUCTION RECORDS.  
 DATE: 11/6/02

**BENCHMARK:**  
 BRASS CAP MONUMENT NO. 10 SET IN CONCRETE IN THE CENTER OF GRASS MEDIAN IN MASTERS DRIVE BETWEEN NORTH LAKESHORE & SHORES BLVD. N 7032464.6317, E 2589554.1518  
 ELEV. = 524.62

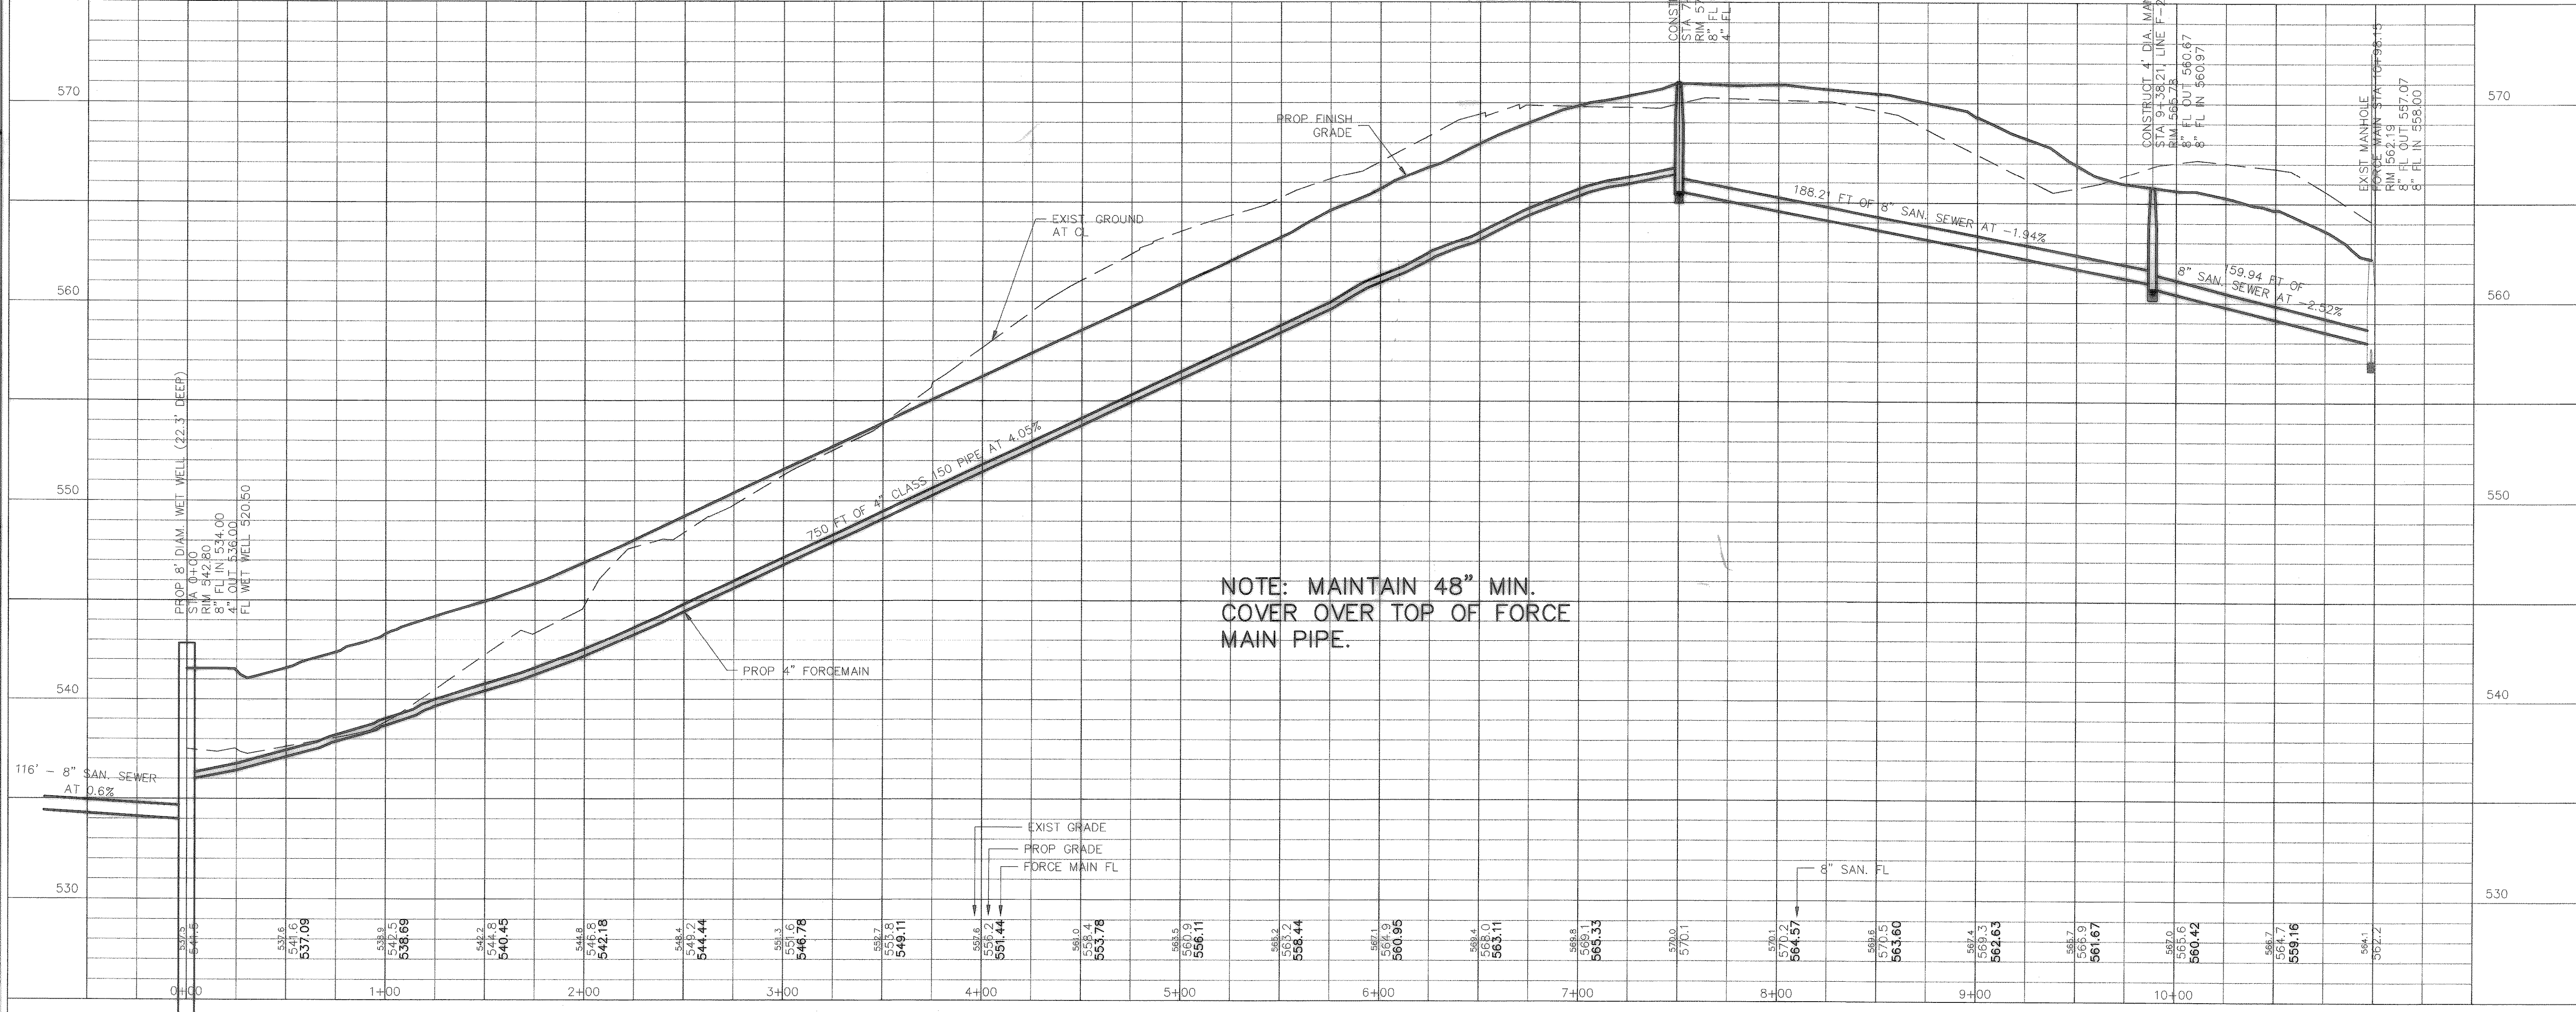

**NOTE: MAINTAIN 48" MIN. COVER OVER TOP OF FORCE MAIN PIPE.**

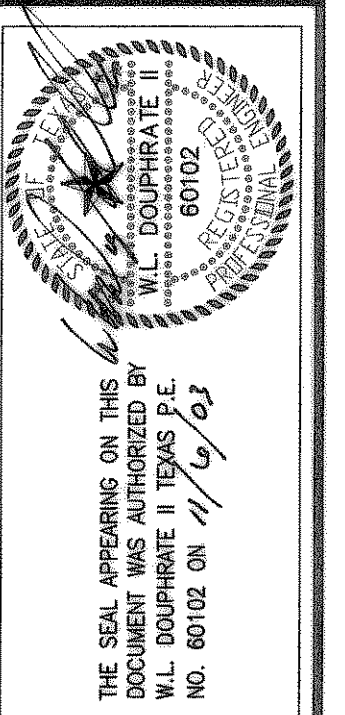

**DOUPHRATE & ASSOCIATES, INC.**  
 ENGINEERING - PROJECT MANAGEMENT - SURVEYING  
 2235 RIDGE RD., # 200 ROCKWALL, TEXAS 75087  
 PHONE: (972)771-9004 FAX: (972)771-9005

**SANITARY SEWER FORCE MAIN  
 PLAN AND PROFILE**  
 LAKEVIEW SUMMIT, PHASE 2  
 CITY OF ROCKWALL, ROCKWALL COUNTY, TEXAS

REVISION  
 - PER BIRKHOFF COMMENTS 3/28/02  
 - PER CITY COMMENTS 5/10/02

W.L.D.  
 CHECKED  
 AL  
 DRAWN  
 DATE  
 9919-2-FURCE MAIN  
 DRAWING