

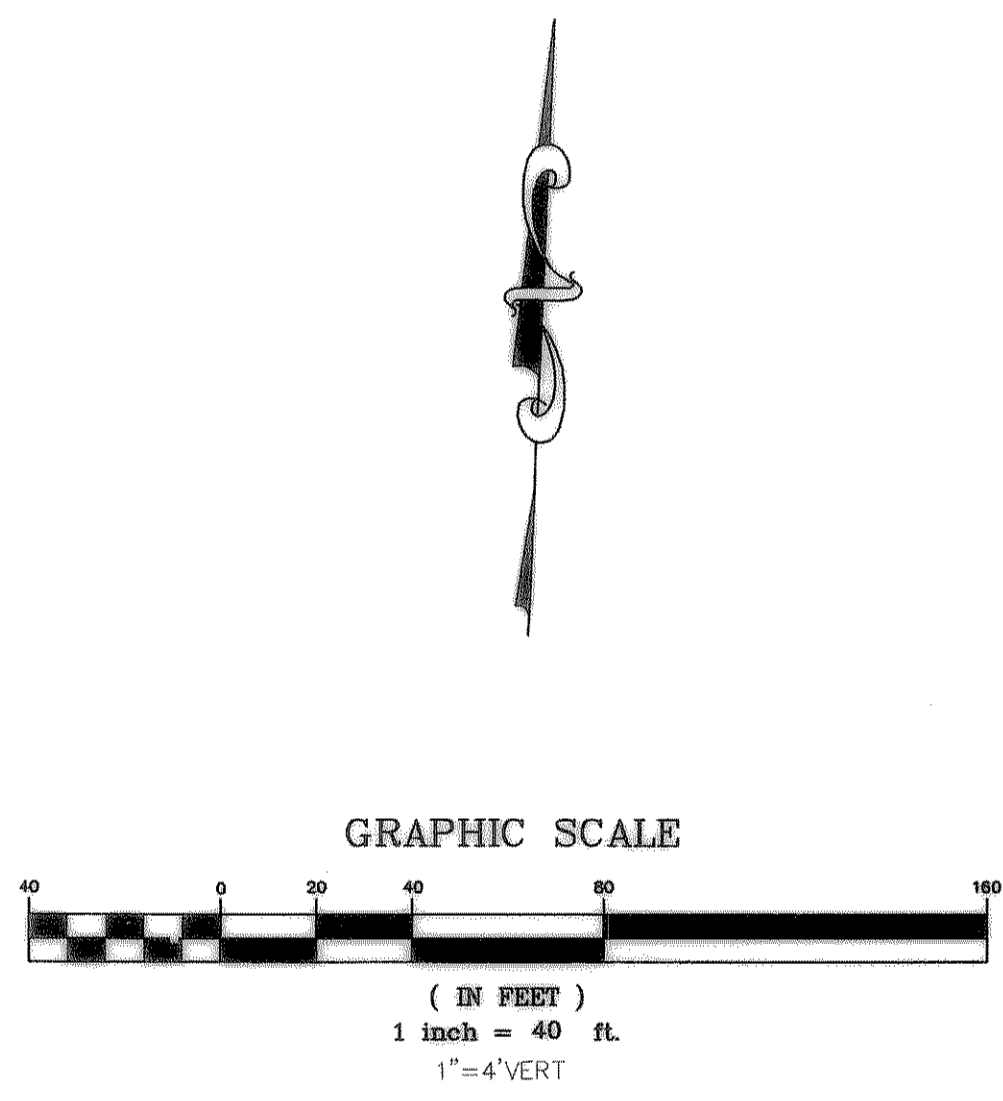


THIS PORTION OF GEARY DRIVE TO BE PAVED WITH THE DEVELOPMENT OF ROCKWALL ELEMENTARY SCHOOL NO. 9

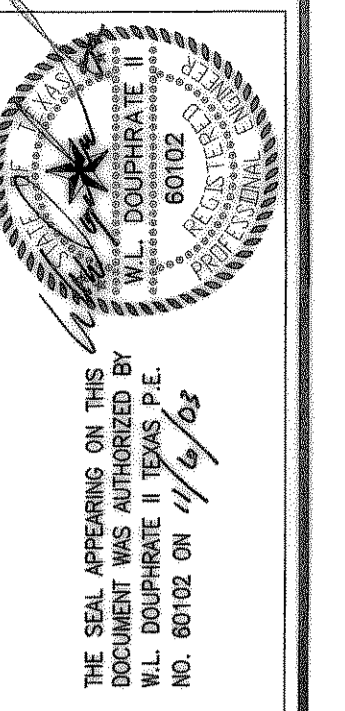

**BENCHMARK:**  
BRASS CAP MONUMENT NO. 10 SET IN CONCRETE IN THE CENTER OF GRASS MEDIAN IN MASTERS DRIVE BETWEEN NORTH LAKESHORE & SHORES BLVD.  
N 7032464.6317, E 2589554.1518  
ELEV. = 524.62

REVISED TO CONFORM TO CONSTRUCTION RECORDS.  
*[Signature]* DATE: 11/6/02

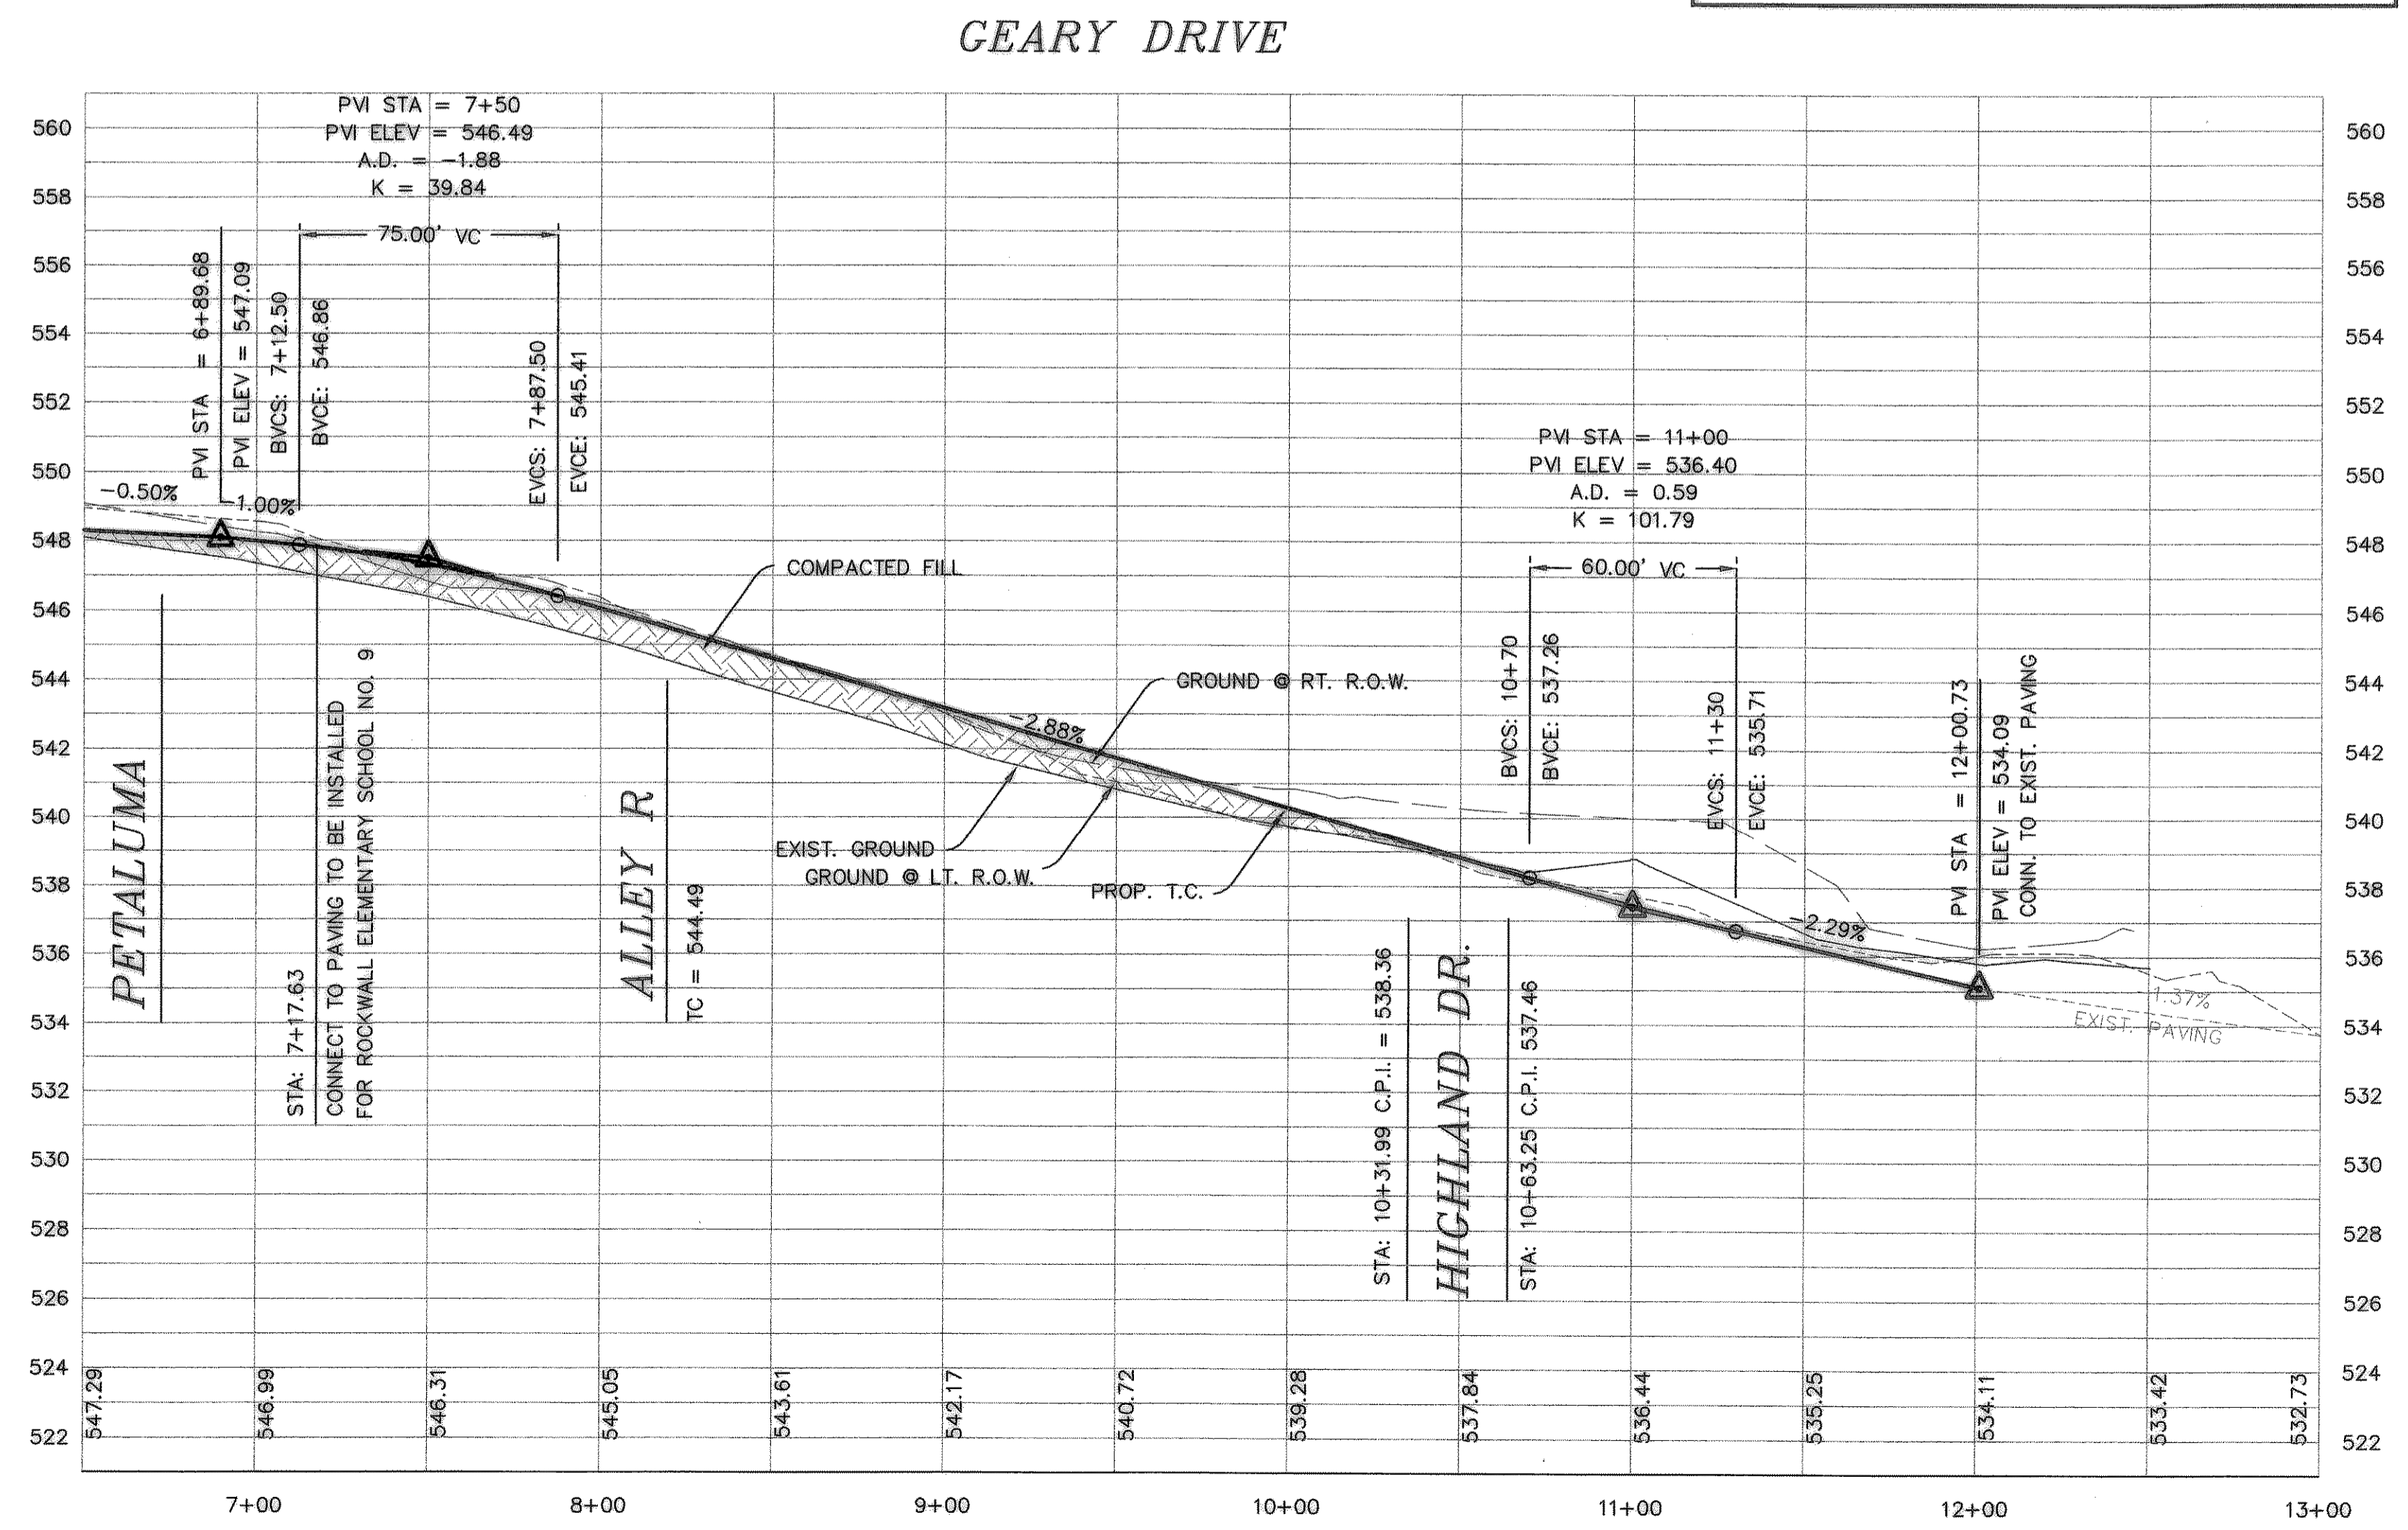

**DOUPHRATE & ASSOCIATES, INC.**  
ENGINEERING - PROJECT MANAGEMENT - SURVEYING  
2235 RIDGE RD., # 200 ROCKWALL, TEXAS 75087  
PHONE: (972)771-9004 FAX: (972)771-9005

**PAVING PLAN & PROFILE**  
GEARY DRIVE STA: 7+17.63 TO 12+00.73  
LAKEVIEW SUMMIT, PHASE 2  
CITY OF ROCKWALL, ROCKWALL COUNTY, TEXAS

REVISIONS:  
- REVISIONS PER CITY COMMENTS 2/5/02

W.L.D.  
CHECKED  
K.E.B.  
DRAWN  
DATE  
9919-2PV3  
PROJECT