

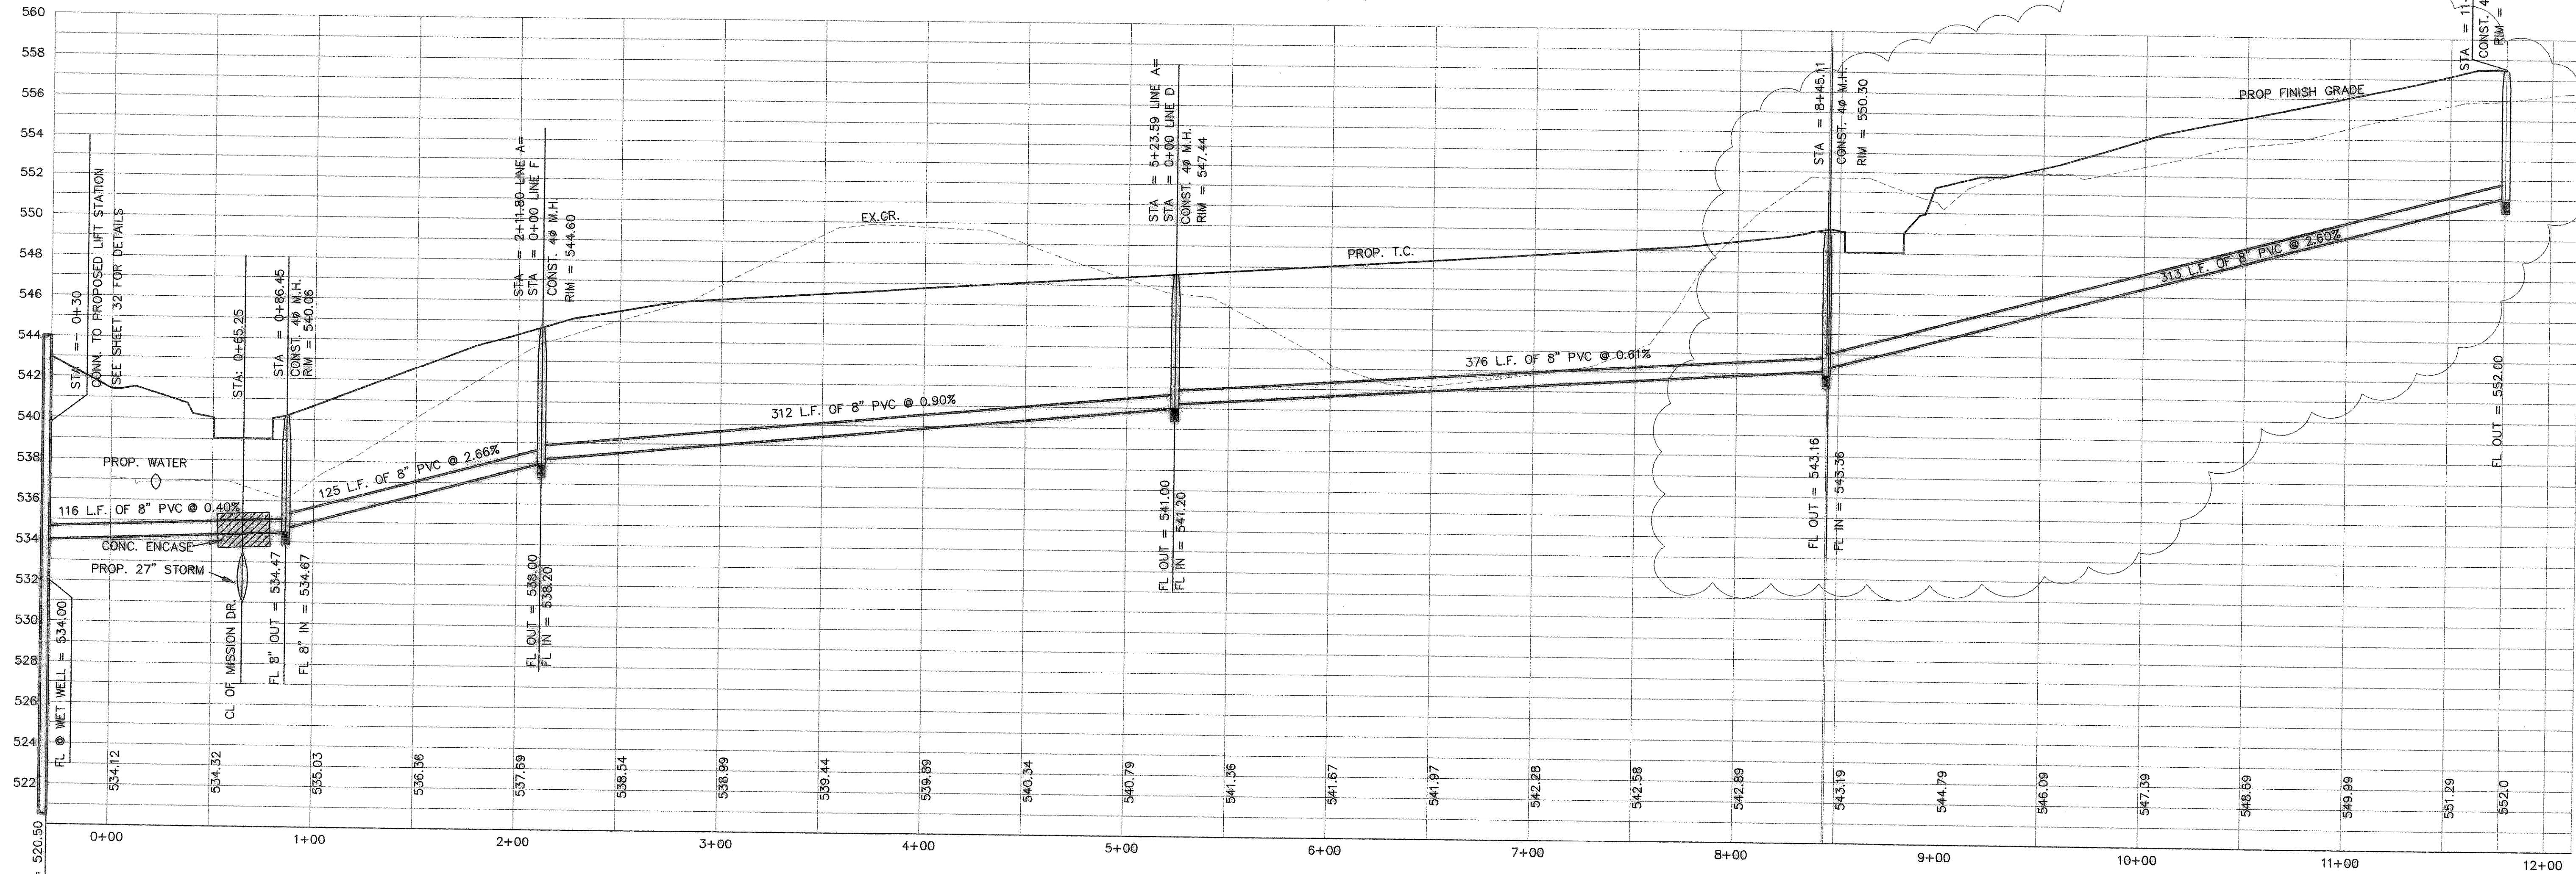


SANITARY SEWER LINE A

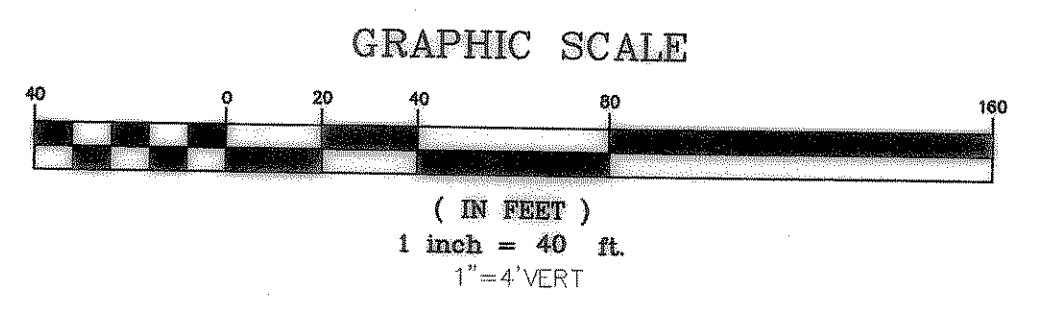


SANITARY SEWER LINE B

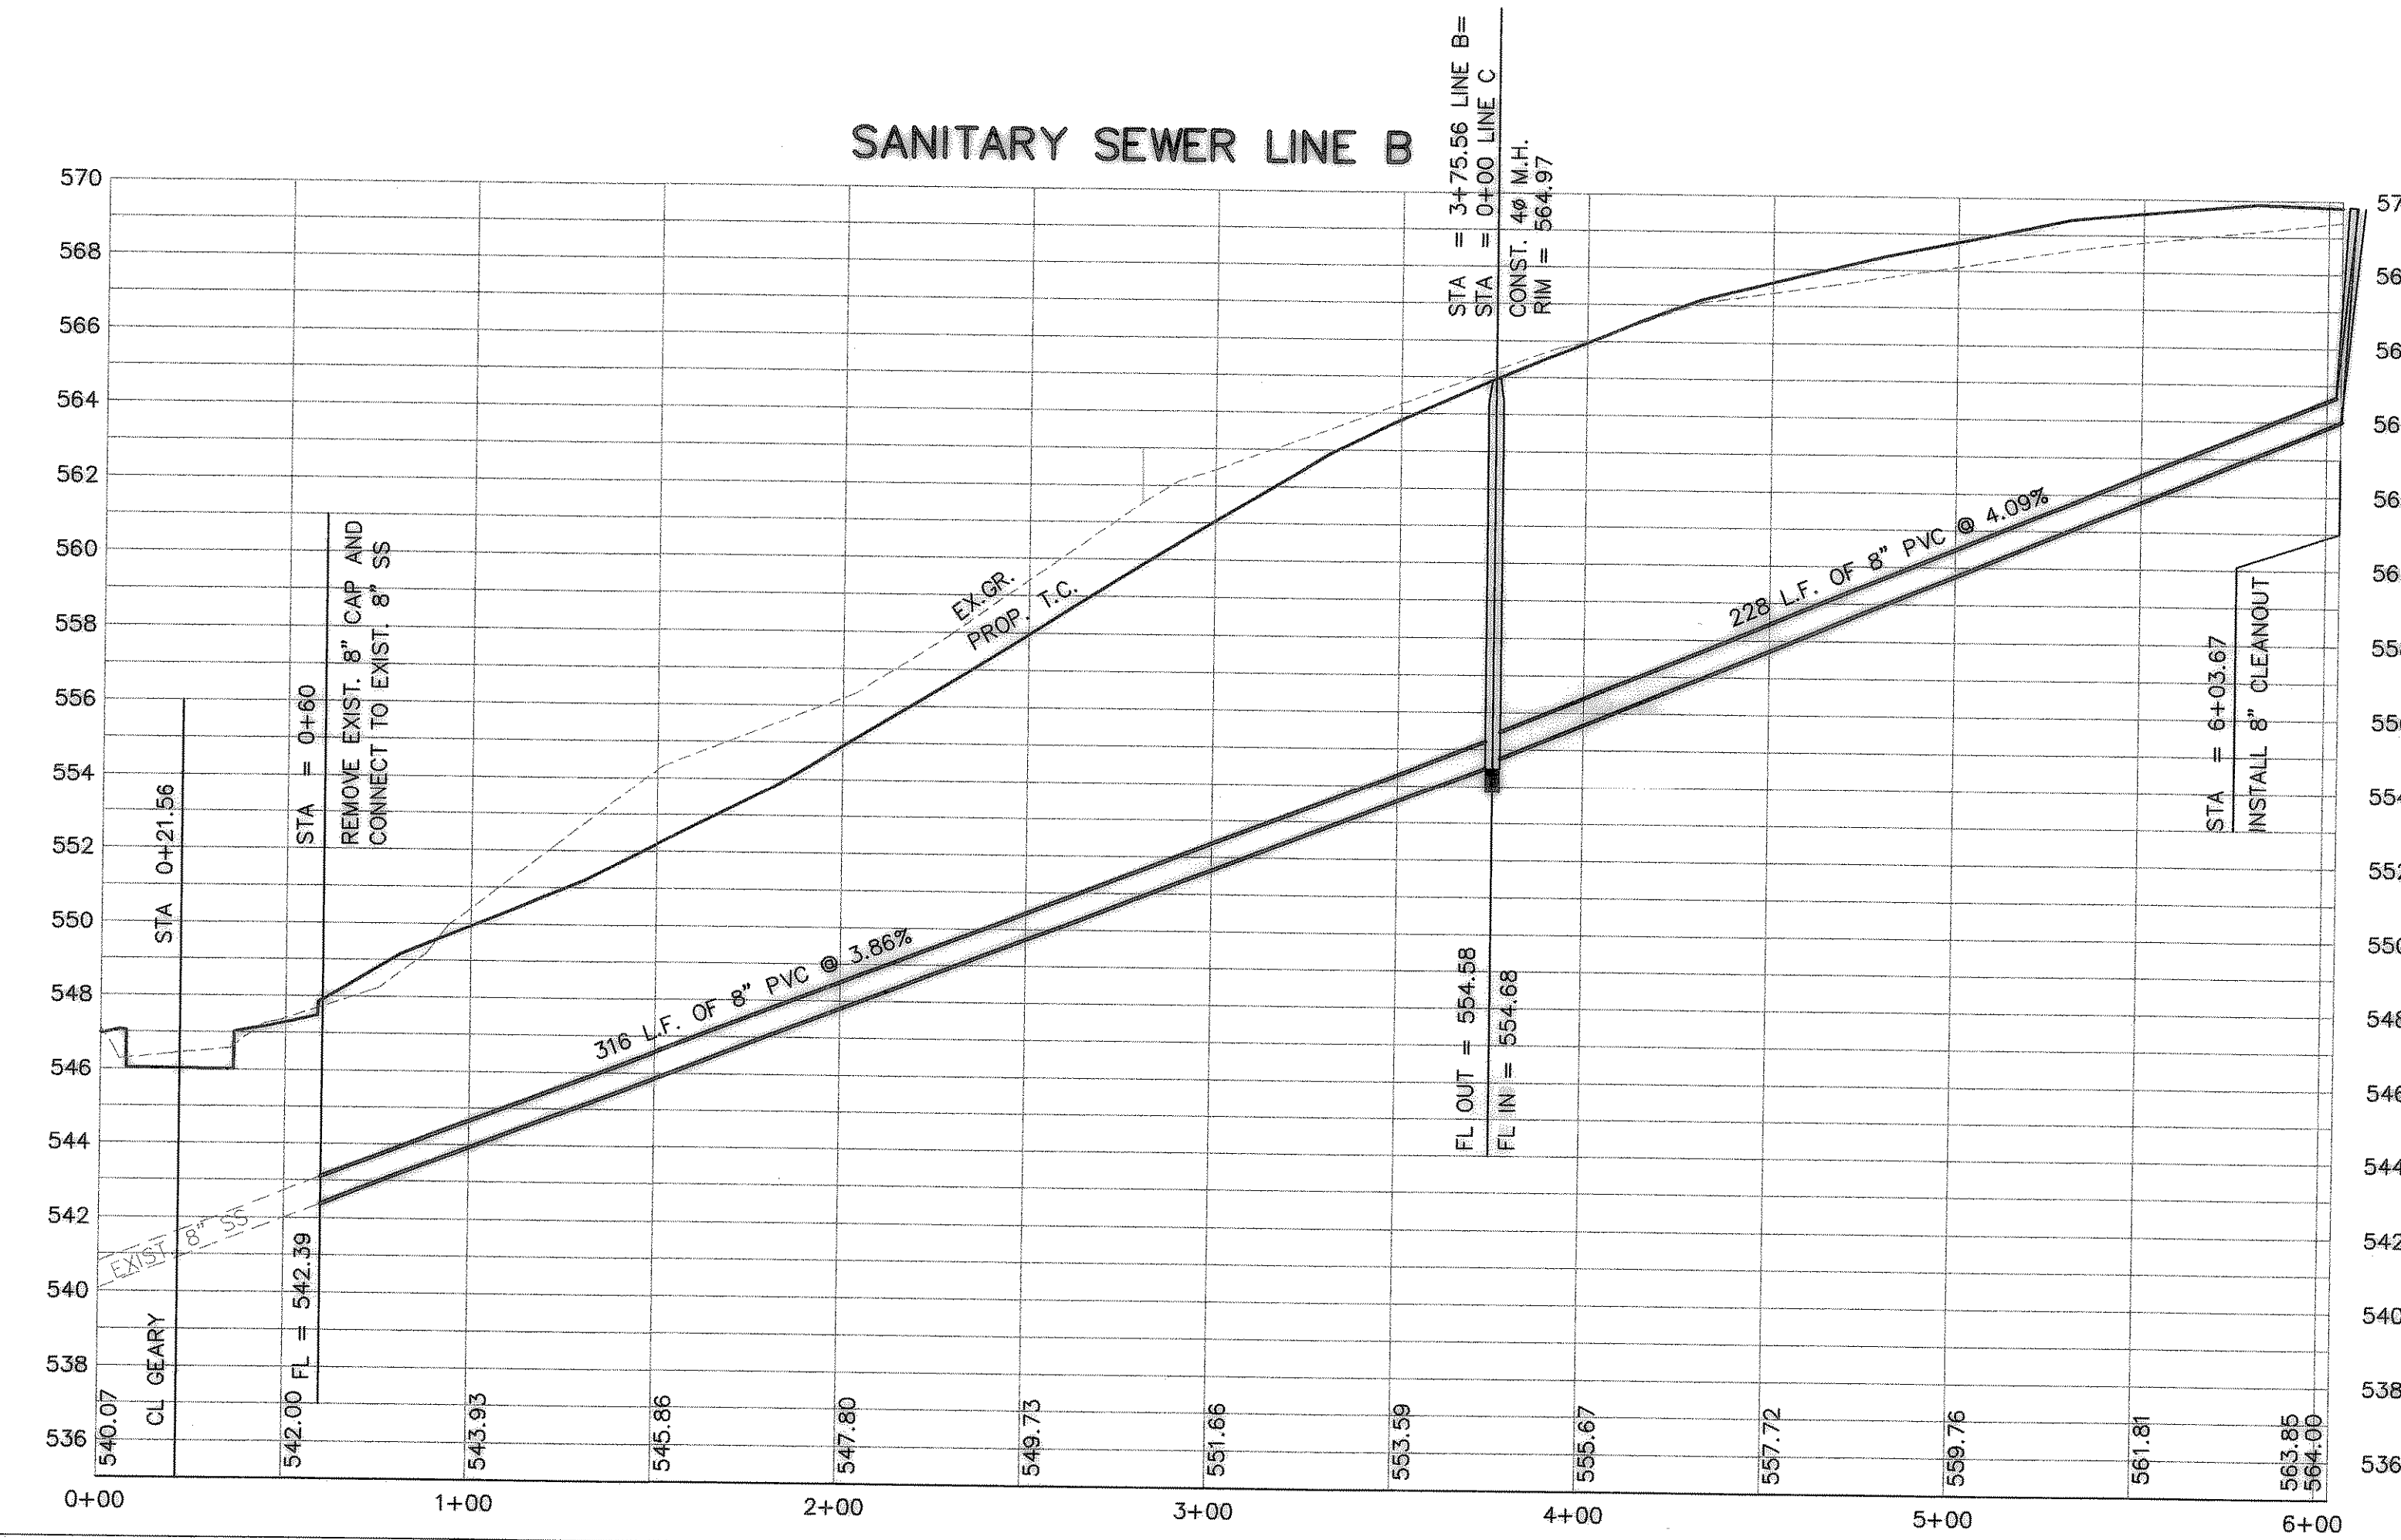

**BENCHMARK:**  
BRASS CAP MONUMENT NO. 10 SET IN CONCRETE IN THE CENTER OF GRASS MEDIAN IN MASTERS DRIVE BETWEEN NORTH LAKESHORE & SHORES BLVD. N 7032464.6317, E 2589554.1518  
ELEV. = 524.62

REVISED TO CONFORM TO CONSTRUCTION RECORDS.  
*W. Douphrate* DATE: 11/6/01

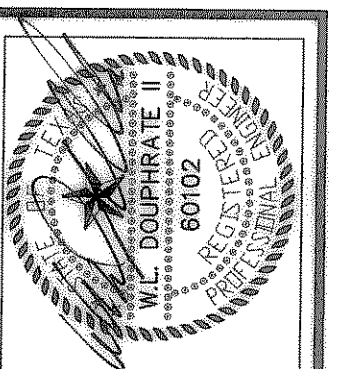

THE SEAL APPEARING ON THIS DOCUMENT WAS AUTHORIZED BY W.L. DOUPHRATE II TEXAS P.E. NO. 60102 ON 11/6/01

**DOUPHRATE & ASSOCIATES, INC.**  
ENGINEERING - PROJECT MANAGEMENT - SURVEYING  
2235 RIDGE RD., # 200 ROCKWALL, TEXAS 75087  
PHONE: (972)771-9004 FAX: (972)771-9005

**SANITARY SEWER PROFILES  
LINES A & B  
LAKEVIEW SUMMIT, PHASE 2  
CITY OF ROCKWALL, ROCKWALL COUNTY, TEXAS**

**REVISION**  
- REVISIONS PER CITY COMMENTS 2/5/02  
- REVISIONS PER CITY COMMENTS 5/11/02  
- REV. S.S. LINE A 5/12/03

W.L.D.  
CHECKED  
K.E.B.  
DRAWN  
11/01  
DATE  
9919-2SSP  
PROJECT