




**DOUPHRAFE & ASSOCIATES, INC.**  
 ENGINEERING - PROJECT MANAGEMENT - SURVEYING  
 2235 RIDGE RD., # 200 ROCKWALL, TEXAS 75087  
 PHONE: (972)771-9004 FAX: (972)771-9005

**SANITARY SEWER PLAN**  
**LAKEVIEW SUMMIT**  
**PHASE 2**  
 CITY OF ROCKWALL, ROCKWALL COUNTY, TEXAS

REVISION
- REVISIONS PER CITY COMMENTS 2/5/02
- REVISIONS PER BIRKOFF COMMENTS 3/28/02
- REVISIONS PER CITY COMMENTS 5/10/02
- S.S. LINE A 5-12-03

W.L.D.
CHECKED
K.E.B.
DRAWN
DATE
01/02
9919-2SEW
PROJECT

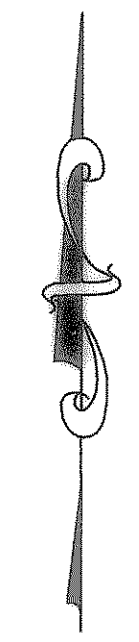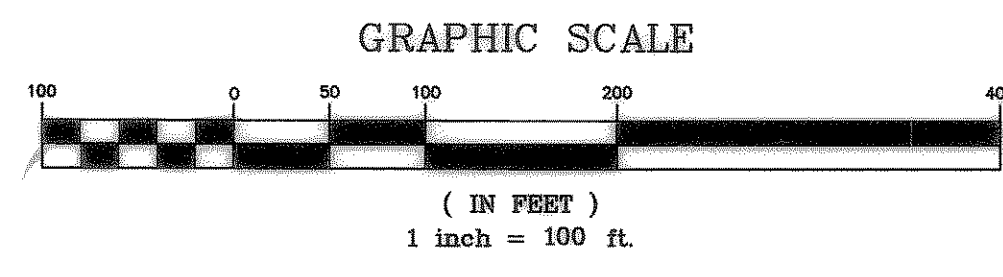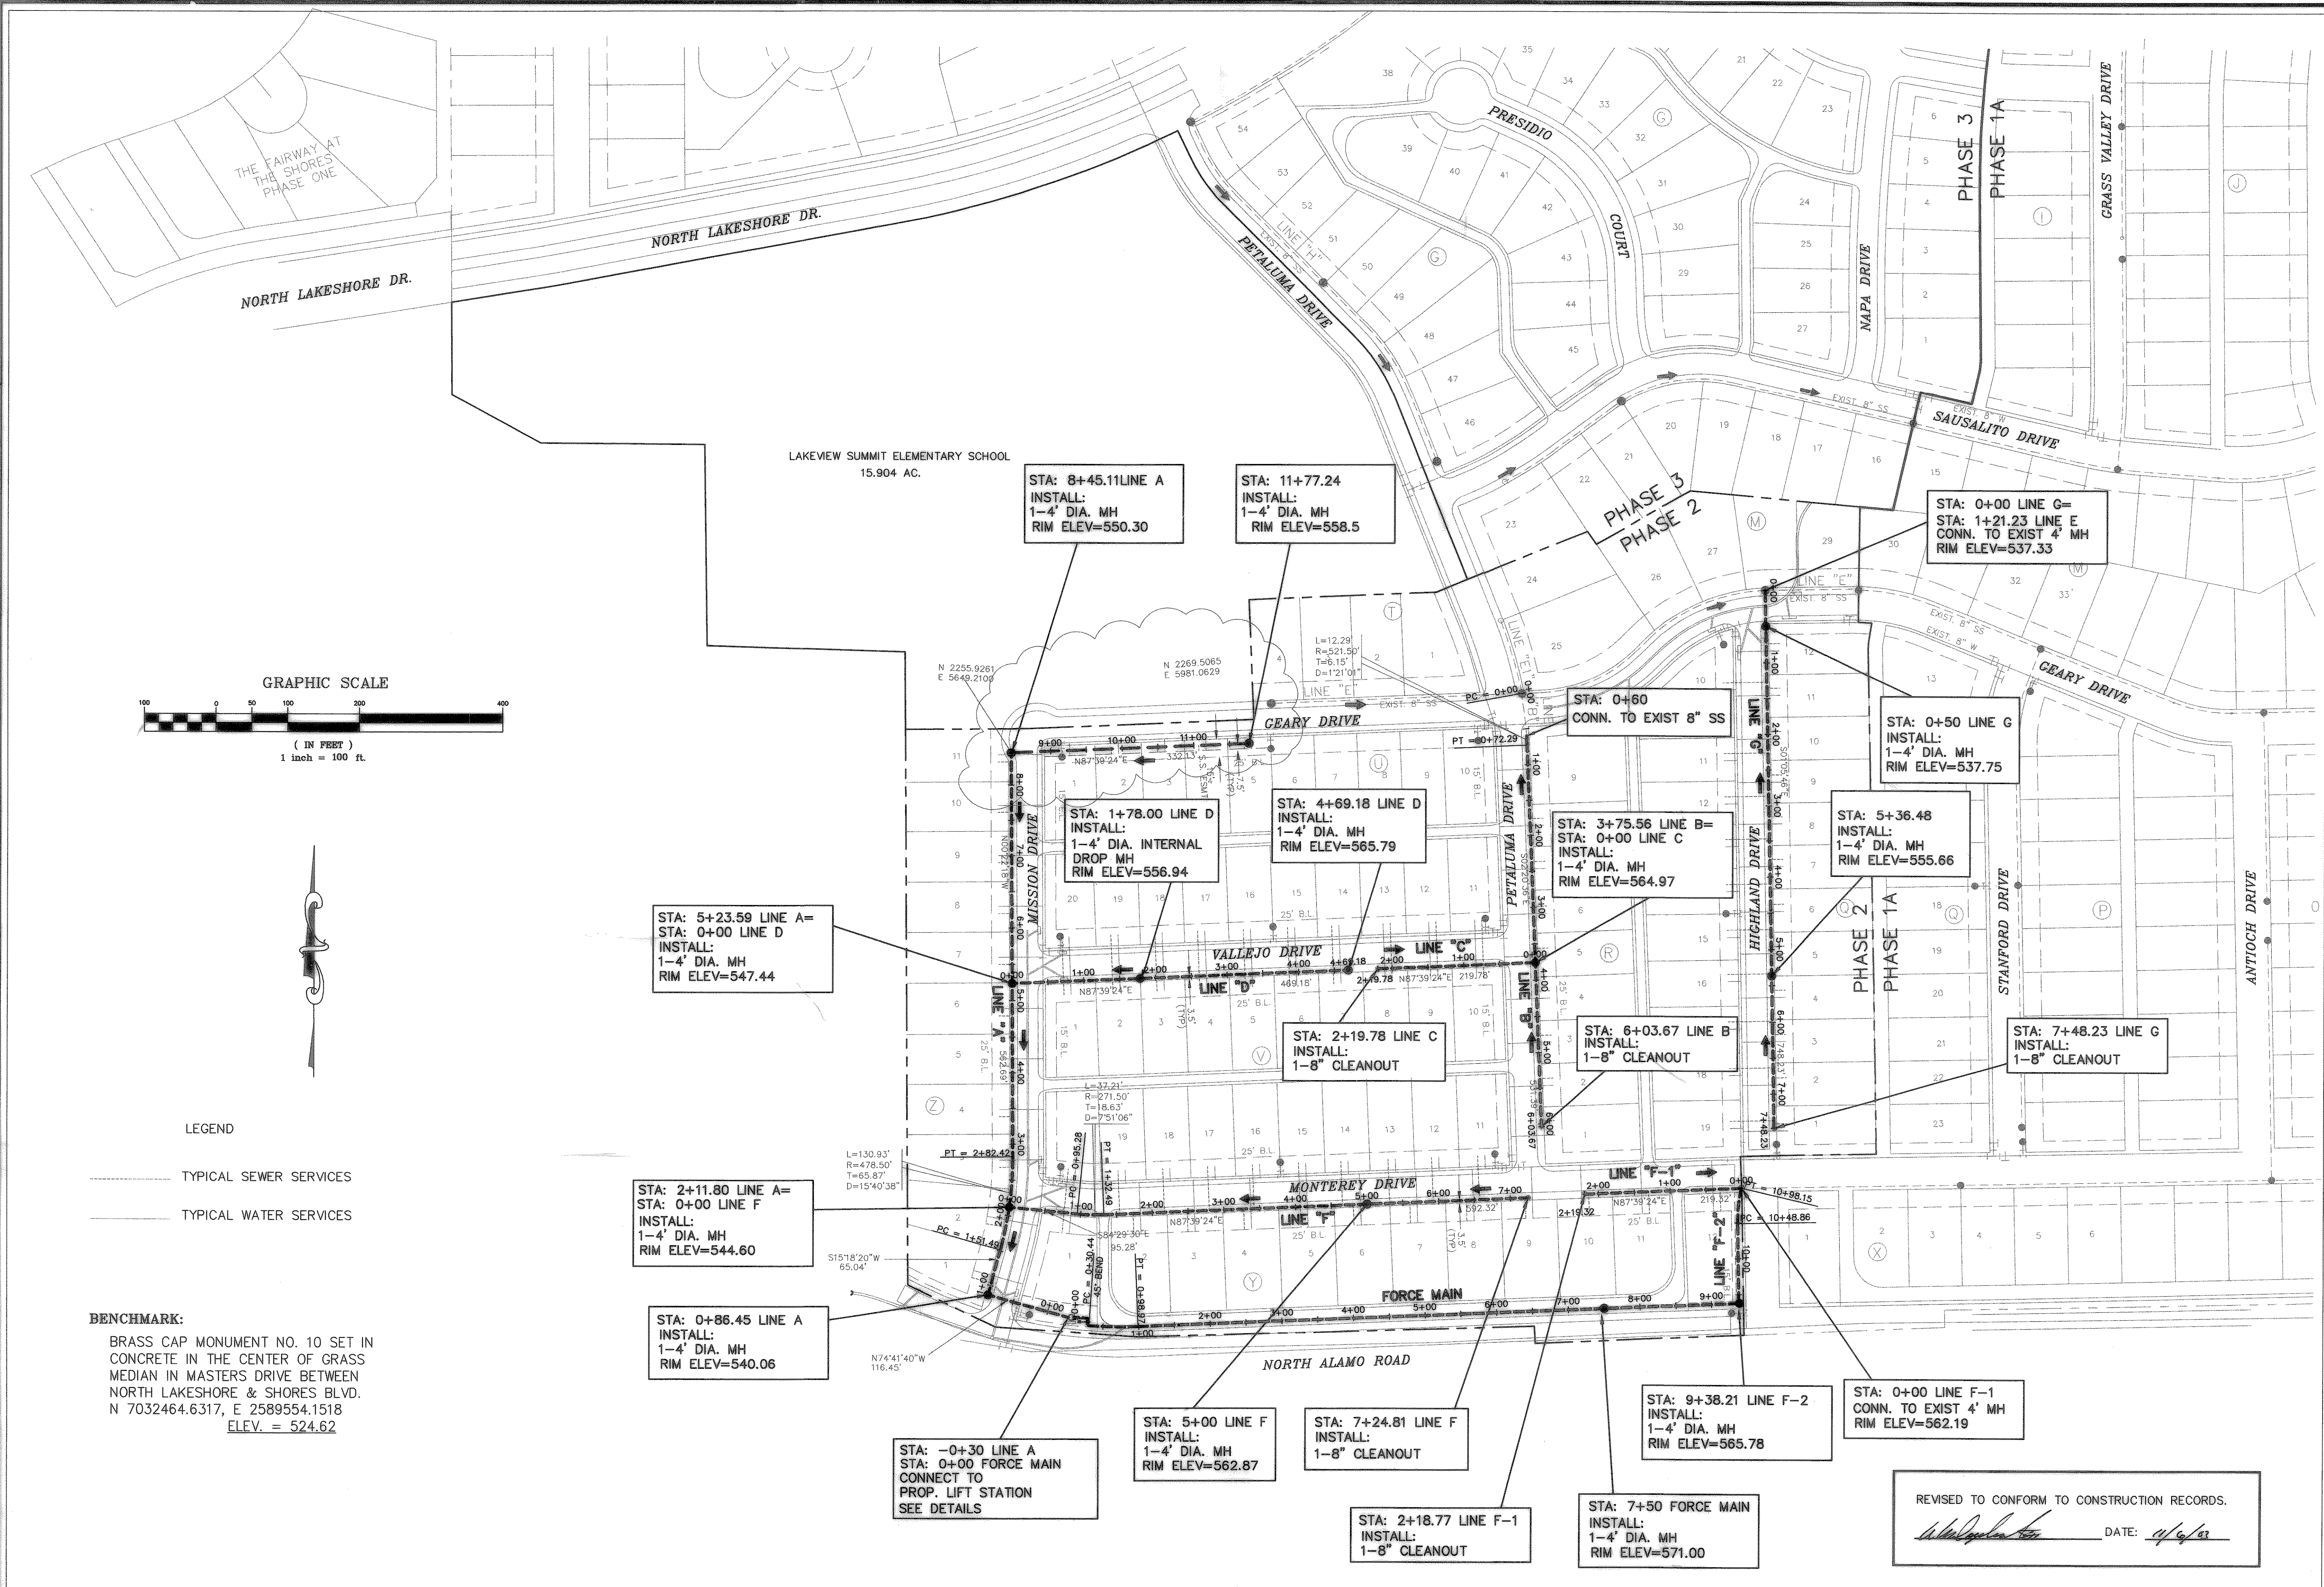

**LEGEND**

- TYPICAL SEWER SERVICES
- TYPICAL WATER SERVICES

**BENCHMARK:**  
 BRASS CAP MONUMENT NO. 10 SET IN CONCRETE IN THE CENTER OF GRASS MEDIAN IN MASTERS DRIVE BETWEEN NORTH LAKESHORE & SHORES BLVD. N 7032464.6317, E 2589554.1518 ELEV. = 524.62

REVISED TO CONFORM TO CONSTRUCTION RECORDS.  
*W.L. Douphrate II* DATE: 11/9/02