



This record drawing set was originally prepared and permitted by Nathan D. Maier, Inc. Consulting Engineers (NDMCE), sealed and dated May 6, 2011. In order to complete the process to obtain a certificate of occupancy, BIG RED DOG has provided for a party inspection of the revised drawings and plans. There are minor revisions noted on the plans and clouded. The original plans, design, and calculations are still under the responsibility of the sealing engineer from NDMCE. Only the modified markups clouded are under the responsibility of this record drawing set, sealed by Grayson K. Hughes, BIG RED DOG Engineering & Consulting. This stamp does not assert, guaranty, or certify accuracy or completeness of the original design. Clouds have been provided around the revised portions of the drawings to reflect observed conditions.



CONSTRUCTION PLANS
OF
PAVING, DRAINAGE AND UTILITY IMPROVEMENTS
FOR
LARSEN RETAIL DEVELOPMENT
3.154 ACRE TRACT
LARSEN SCHOOL ADDITION

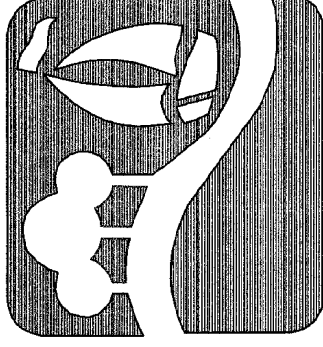


CITY OF ROCKWALL, TEXAS

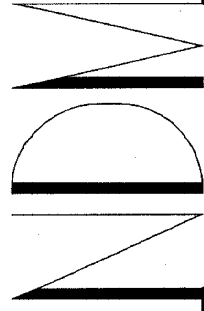

NATHAN D. MAIER, INC.
CONSULTING ENGINEERS
TEXAS FIRM REGISTRATION NO. F-356

Two North Park - 8080 Park Lane, Suite 600
Dallas, Texas 75231 • (214) 739-4741 • NDMCE.COM

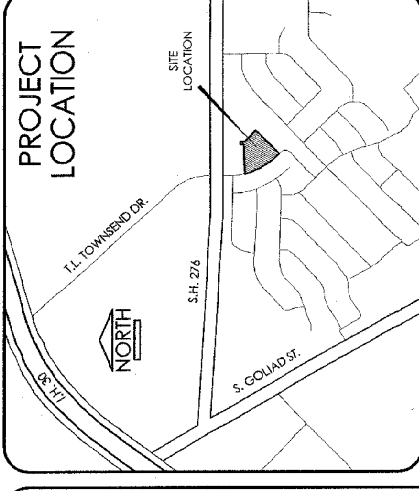

SHEET INDEX :

SHEET	DESCRIPTION
1.	REPLAT
2.	SITE PLAN
3.	HORIZONTAL CONTROL
4.	GRADING PLAN
5.	PAVEMENT CONSTRUCTION PLAN
6.	DRAINAGE AREA MAP
7.	SUBSURFACE STORMWATER MANAGEMENT SYSTEM
8.	SUBSURFACE STORMWATER MANAGEMENT SYSTEM
9.	OUTLET CONTROL STRUCTURE "A"
10.	OUTLET CONTROL STRUCTURE "B"
11.	OUTLET CONTROL STRUCTURE "C"
12.	DETENTION CALCULATIONS
13.	DETECTION CALCULATIONS
14.	WATER AND SANITARY SEWER PLAN
15.	EROSION CONTROL PLAN
16.	EROSION CONTROL DETAILS
L1	LANDSCAPE PLAN
STORMTECH SUBSURFACE STORMWATER MANAGEMENT SYSTEM CONSTRUCTION DETAILS	
VOLUME CALCULATIONS	

08-04-038.A - LARSEN RETAIL DEVELOPMENT
3.154 ACRE TRACT ~ LARSEN RETAIL SCHOOL ADDITION

OWNER:
GALAXY RANCH SHOPPING CENTER, L.P.
2101 FIREWHEEL PARKWAY
GARLAND, TX 75040
BRAD LARSEN, MANAGING MEMBER
972.414.4839

JOB NUMBER :
08-04-038.A
MAY 05, 2011