


RECORD DRAWING
 8/10/2006

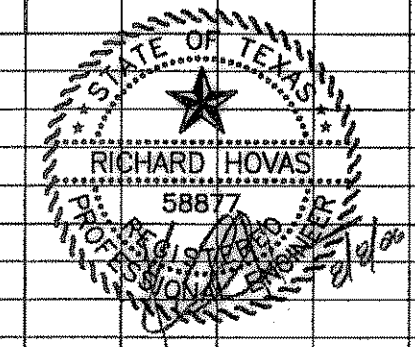

SANITARY SEWER PROFILES
 THE LARSEN SCHOOL ADDITION
 CITY OF ROCKWALL, TEXAS

TIPTON ENGINEERING, INC.
 6330 Broadway Blvd. ~ Suite C ~ Garland, Texas 75043

DESIGN	DRAWN	DATE	SCALE	NOTES	FILE	NO.
TEI, Inc.	TEI, Inc.	8-2004	H: 1"=20' V: 1"=5'			6

47675TMPROF 01-06-05