

"THE NEW HORIZON"

RECORD DRAWING
LEMMOND OFFICE / WAREHOUSE 22147

SITE CONSTRUCTION PLANS

FOR


LEMMOND OFFICE / WAREHOUSE ROCKWALL 205 BUSINESS PARK BLOCK A, LOT 6

IN THE


CITY OF ROCKWALL, TEXAS

SHEET INDEX

| Sheet No. | Description |
|-----------|-------------------------|
| 1 | Cover Sheet |
| 2 | Final Plat |
| 3 | Final Plat |
| C1 | Site Plan |
| C2 | Grading Plan |
| C3 | Drainage Area Map |
| C4 | Utility Plan |
| C5 | Erosion Control |
| C6 | Typical Details & Notes |

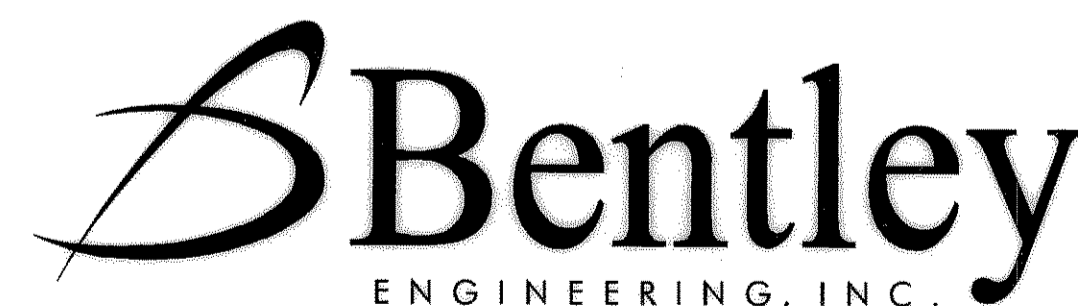

4125 BROADWAY BLVD.
SUITE A250
GARLAND, TEXAS 75043
PH. 972.240.4821
FAX. 972.240.0922

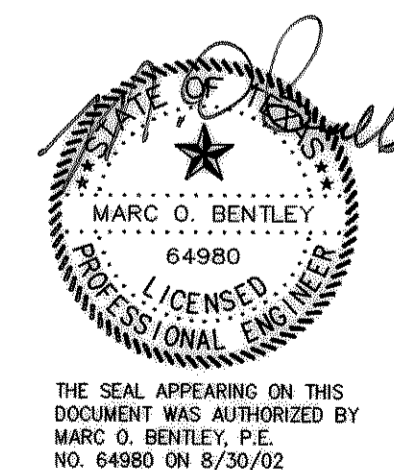

RECORD DRAWING

IMPROVEMENTS INDICATED ON THIS PLAN WHERE MADE IN ACCORDANCE WITH THE PROJECT PLANS & SPECIFICATIONS. THE DESIGN ENGINEER IS NOT AWARE OF ANY CHANGES TO THESE PLANS OTHER THAN THOSE SHOWN.
DATE: MAY 11, 2004

AUGUST 2002